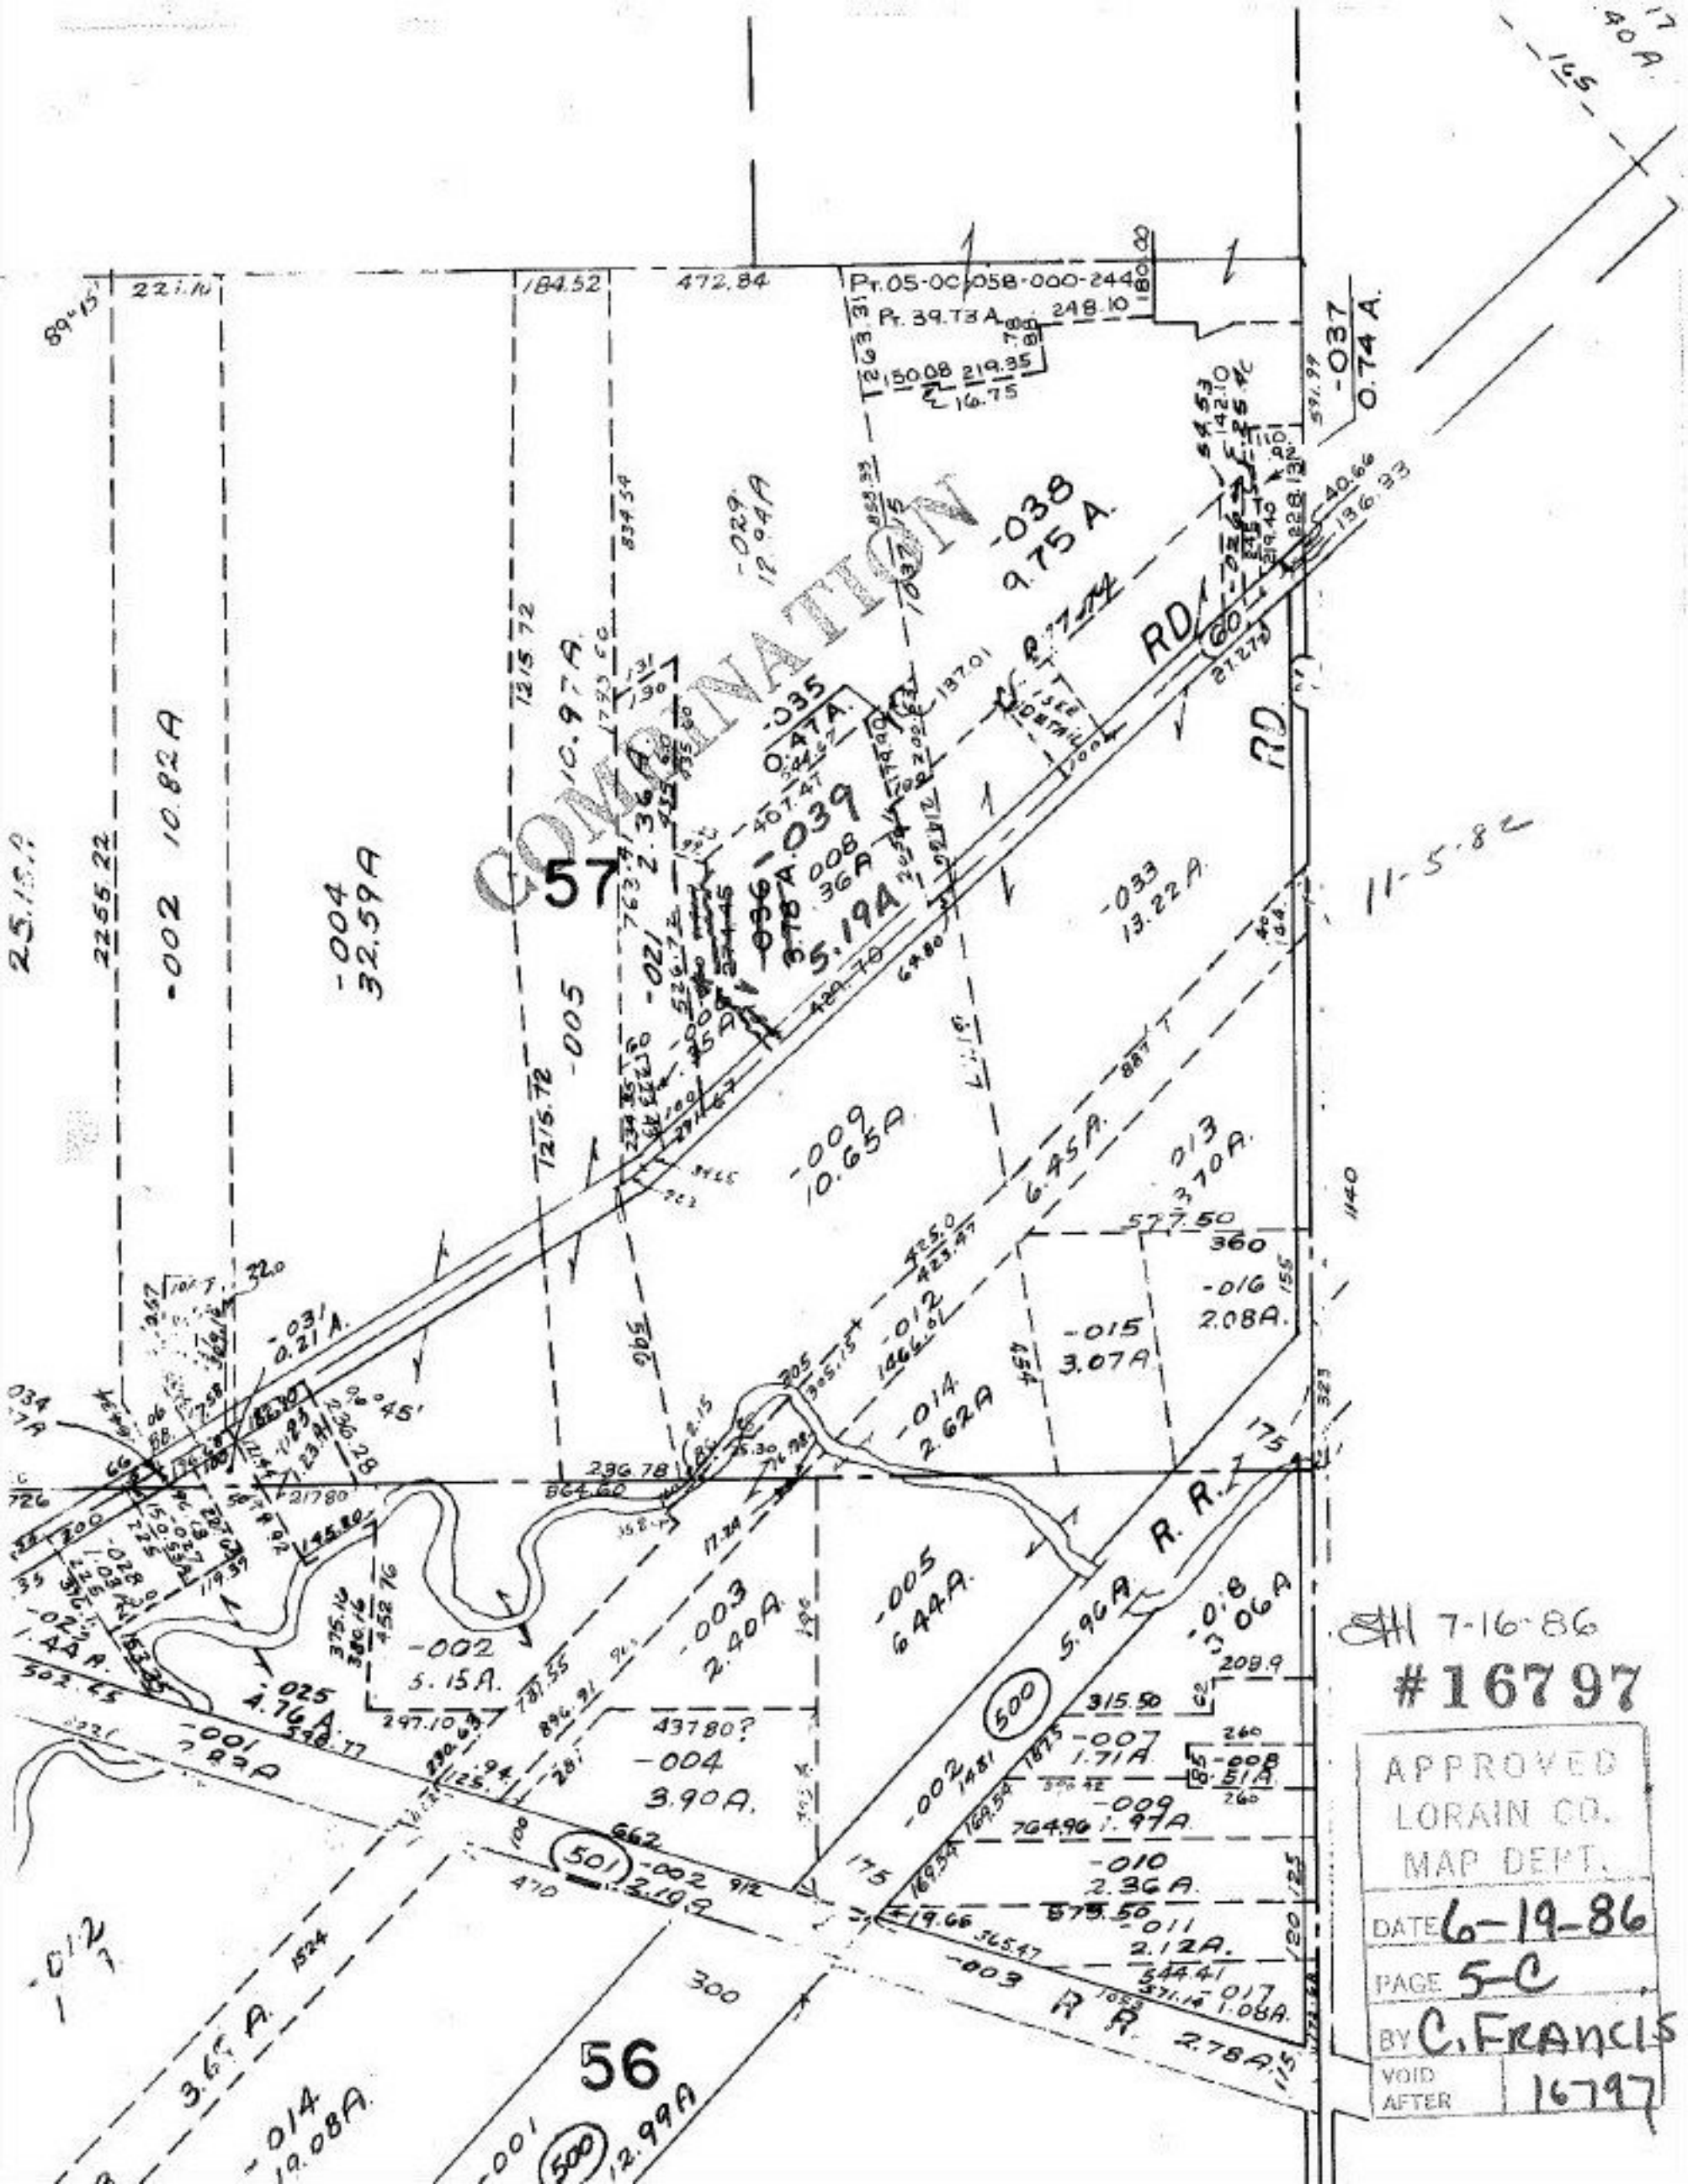

SH 7-16-86

#16797

APPROVED
LORAIN CO.
MAP DEPT.

DATE 6-19-86

PAGE 5-C

BY C. FRANCIS

VOID AFTER 16797