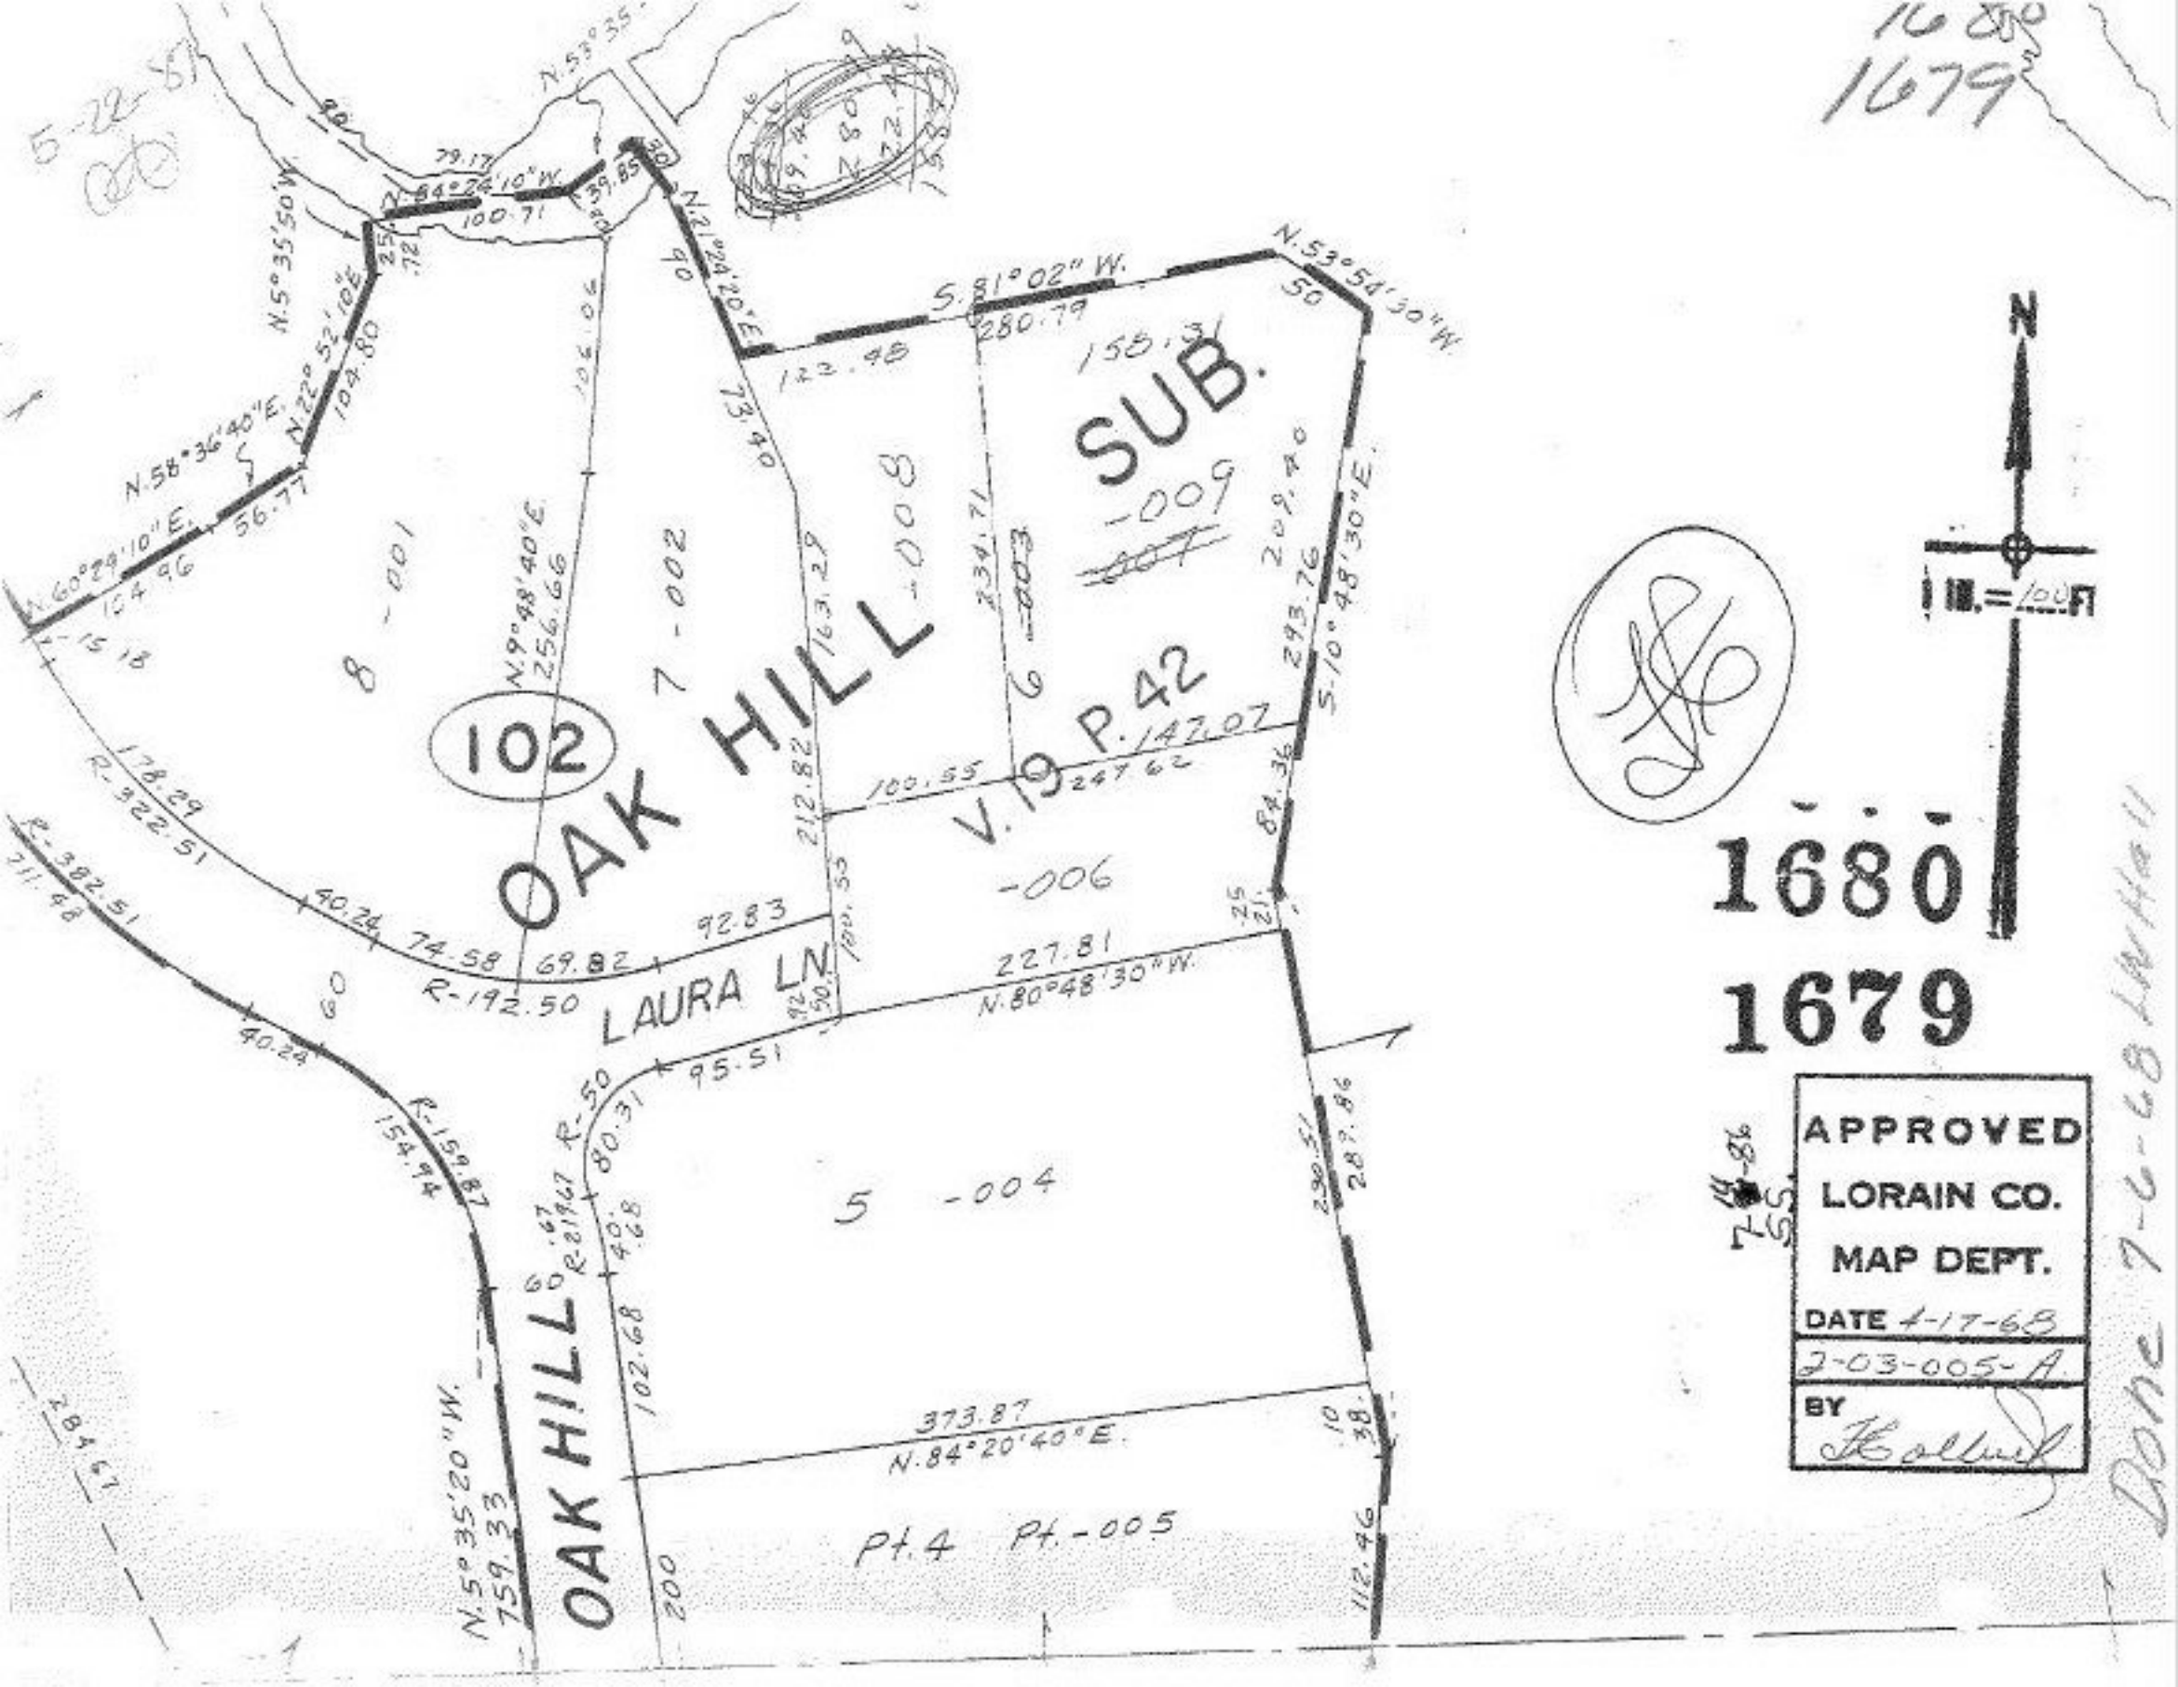
1680
1679
OAK HILL SUB.
V. 19 P. 42
-009
-008
-007
-006
-005
-004
-003
-002
-001
102
LAURA LN
OAK HILL
S. 81° 02" W.
280.79
N. 53° 54' 30" W.
N. 21° 24' 20" E.
73.40
N. 9° 48' 40" E.
256.66
N. 5° 35' 50" W.
N. 58° 36' 40" E.
N. 60° 29' 10" E.
104.96
N. 22° 52' 10" E.
104.80
S. 10° 48' 30" E.
293.76
209.40
N. 80° 48' 30" W.
227.81
R-192.50
R-322.51
178.29
74.58
69.82
92.83
40.24
R-382.51
211.48
R-159.87
154.94
R-50
80.31
95.51
102.68
373.87
N. 84° 20' 40" E.
N. 5° 35' 20" W.
759.33
284.67
Pt. 4
Pt. -005
APPROVED
LORAIN CO.
MAP DEPT.
DATE 4-17-68
2-03-005-A
BY
1" = 100 FT
Done 7-6-68