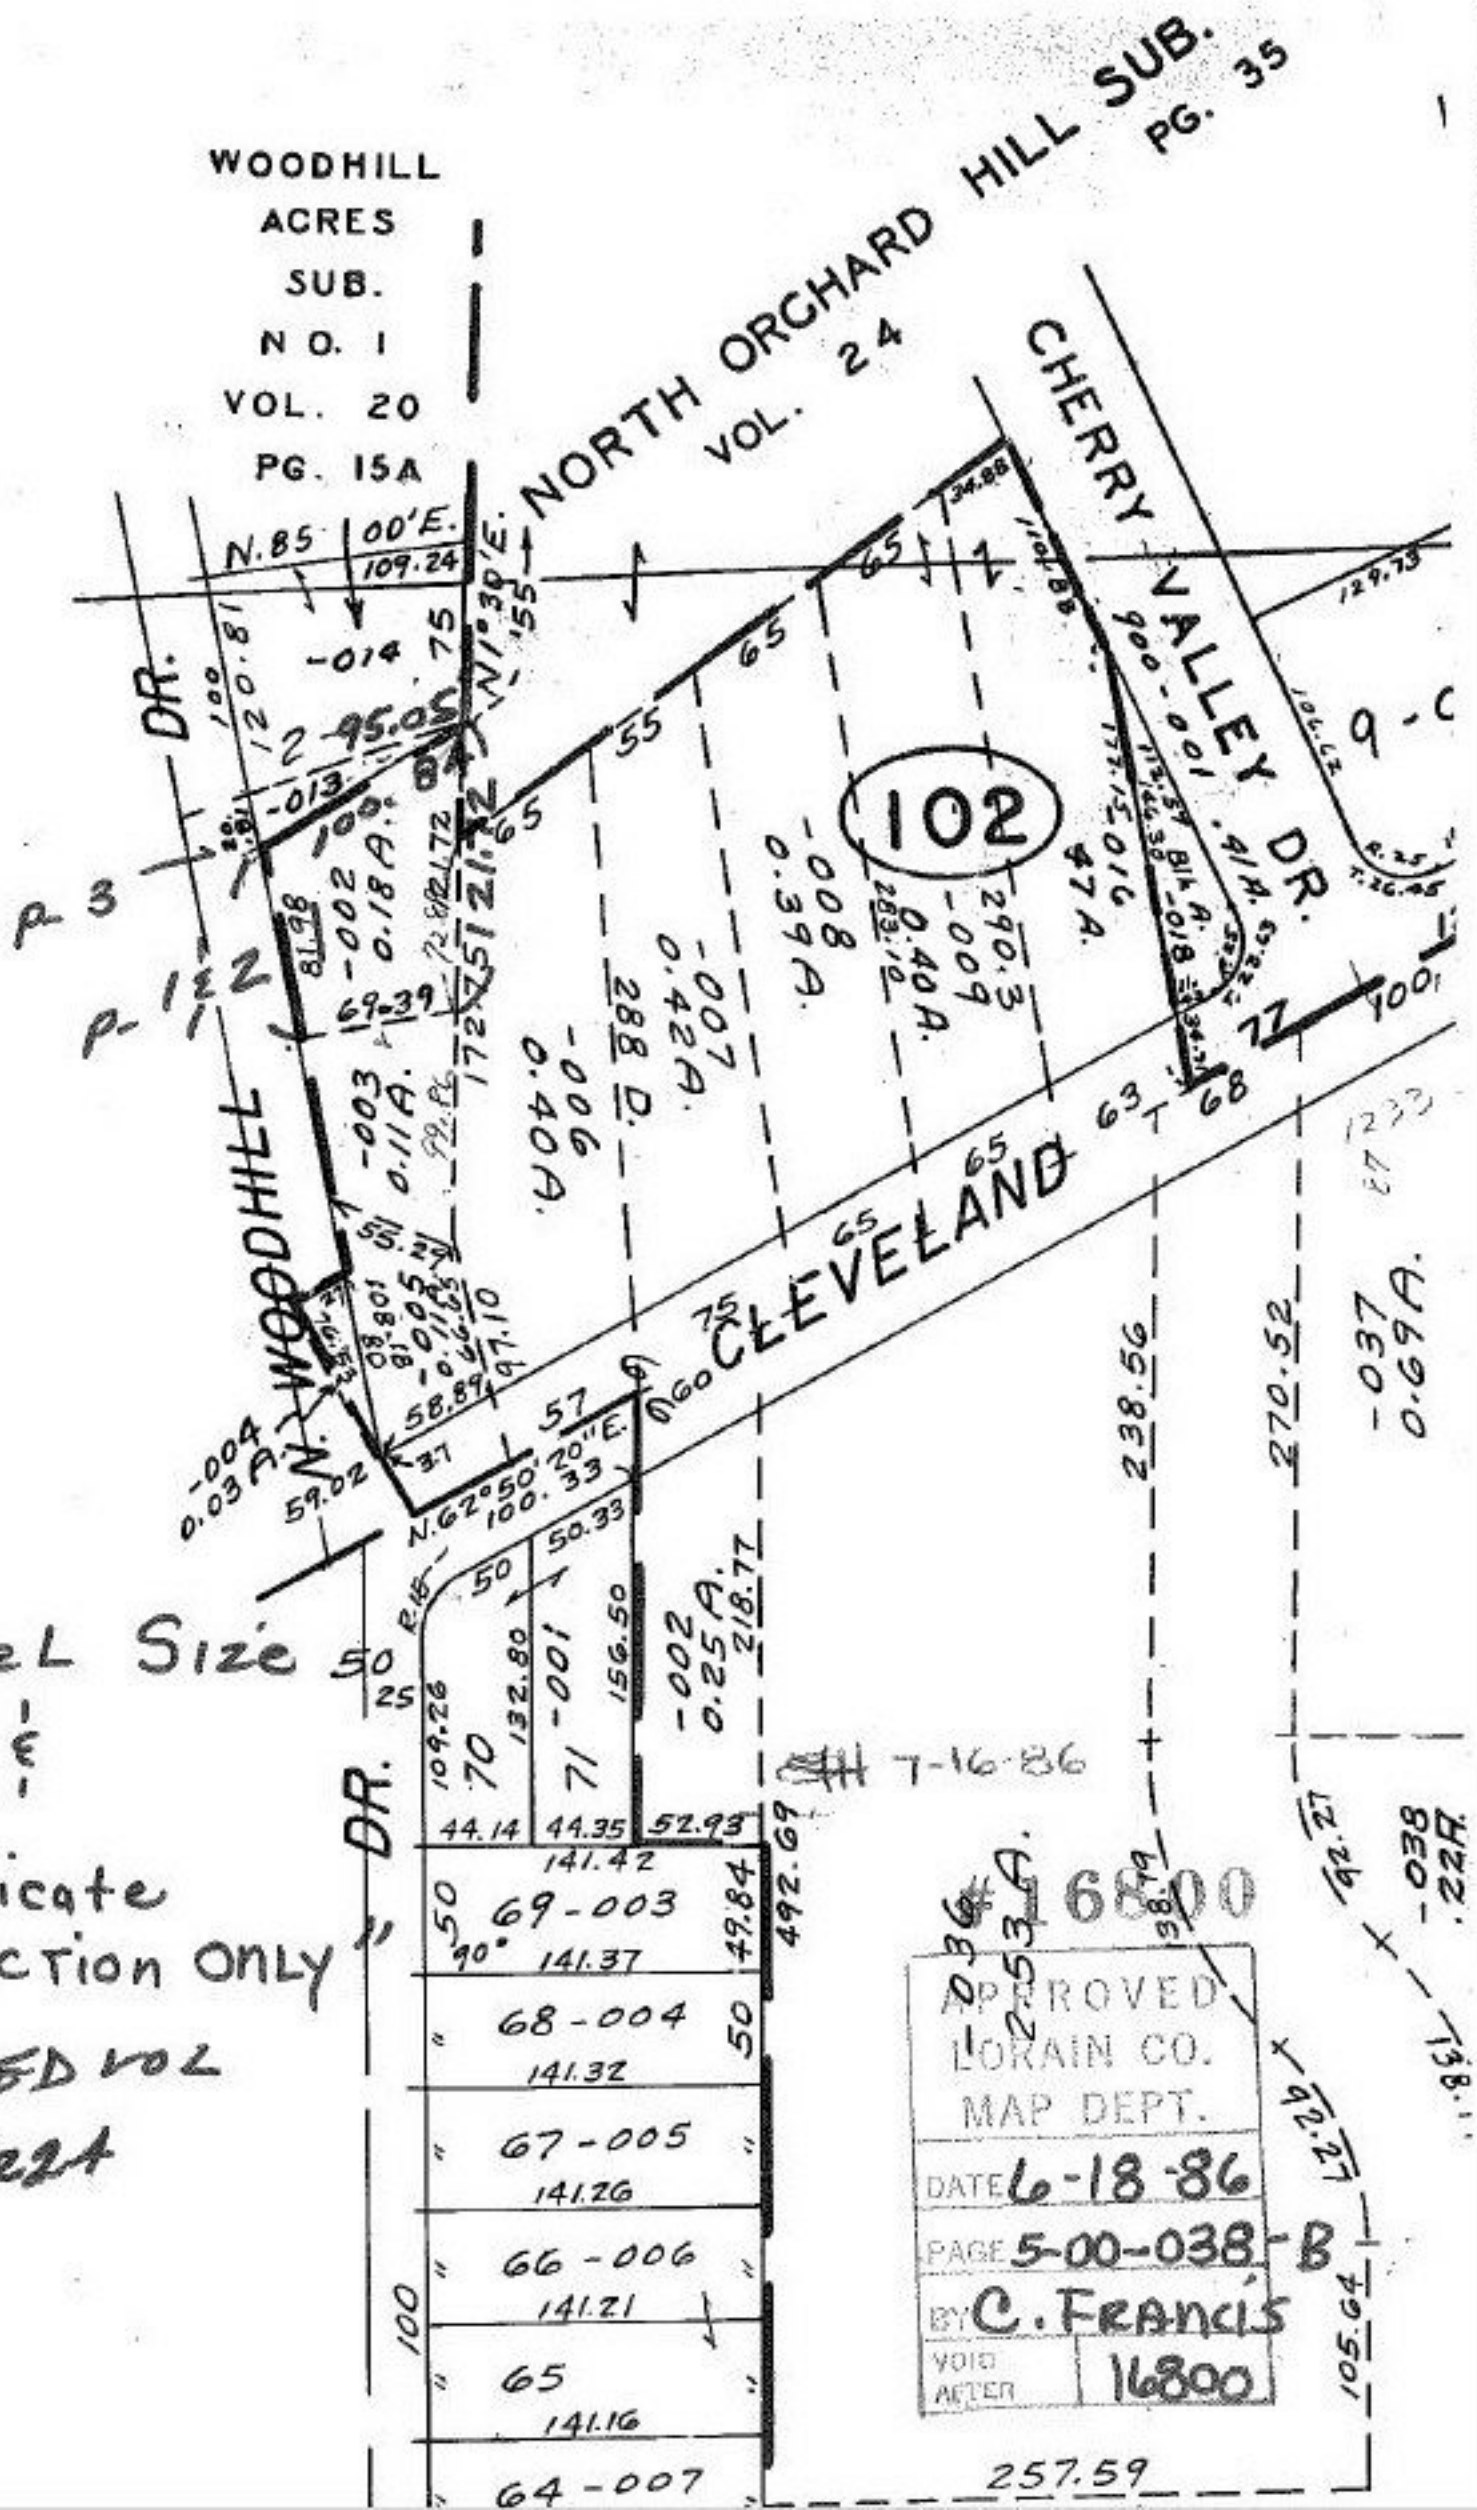

75.00
6.98
81.98
114.72
7

PARCEL SIZE
&
Duplicate
& Correction ONLY"

PER DEED VOL
963/224