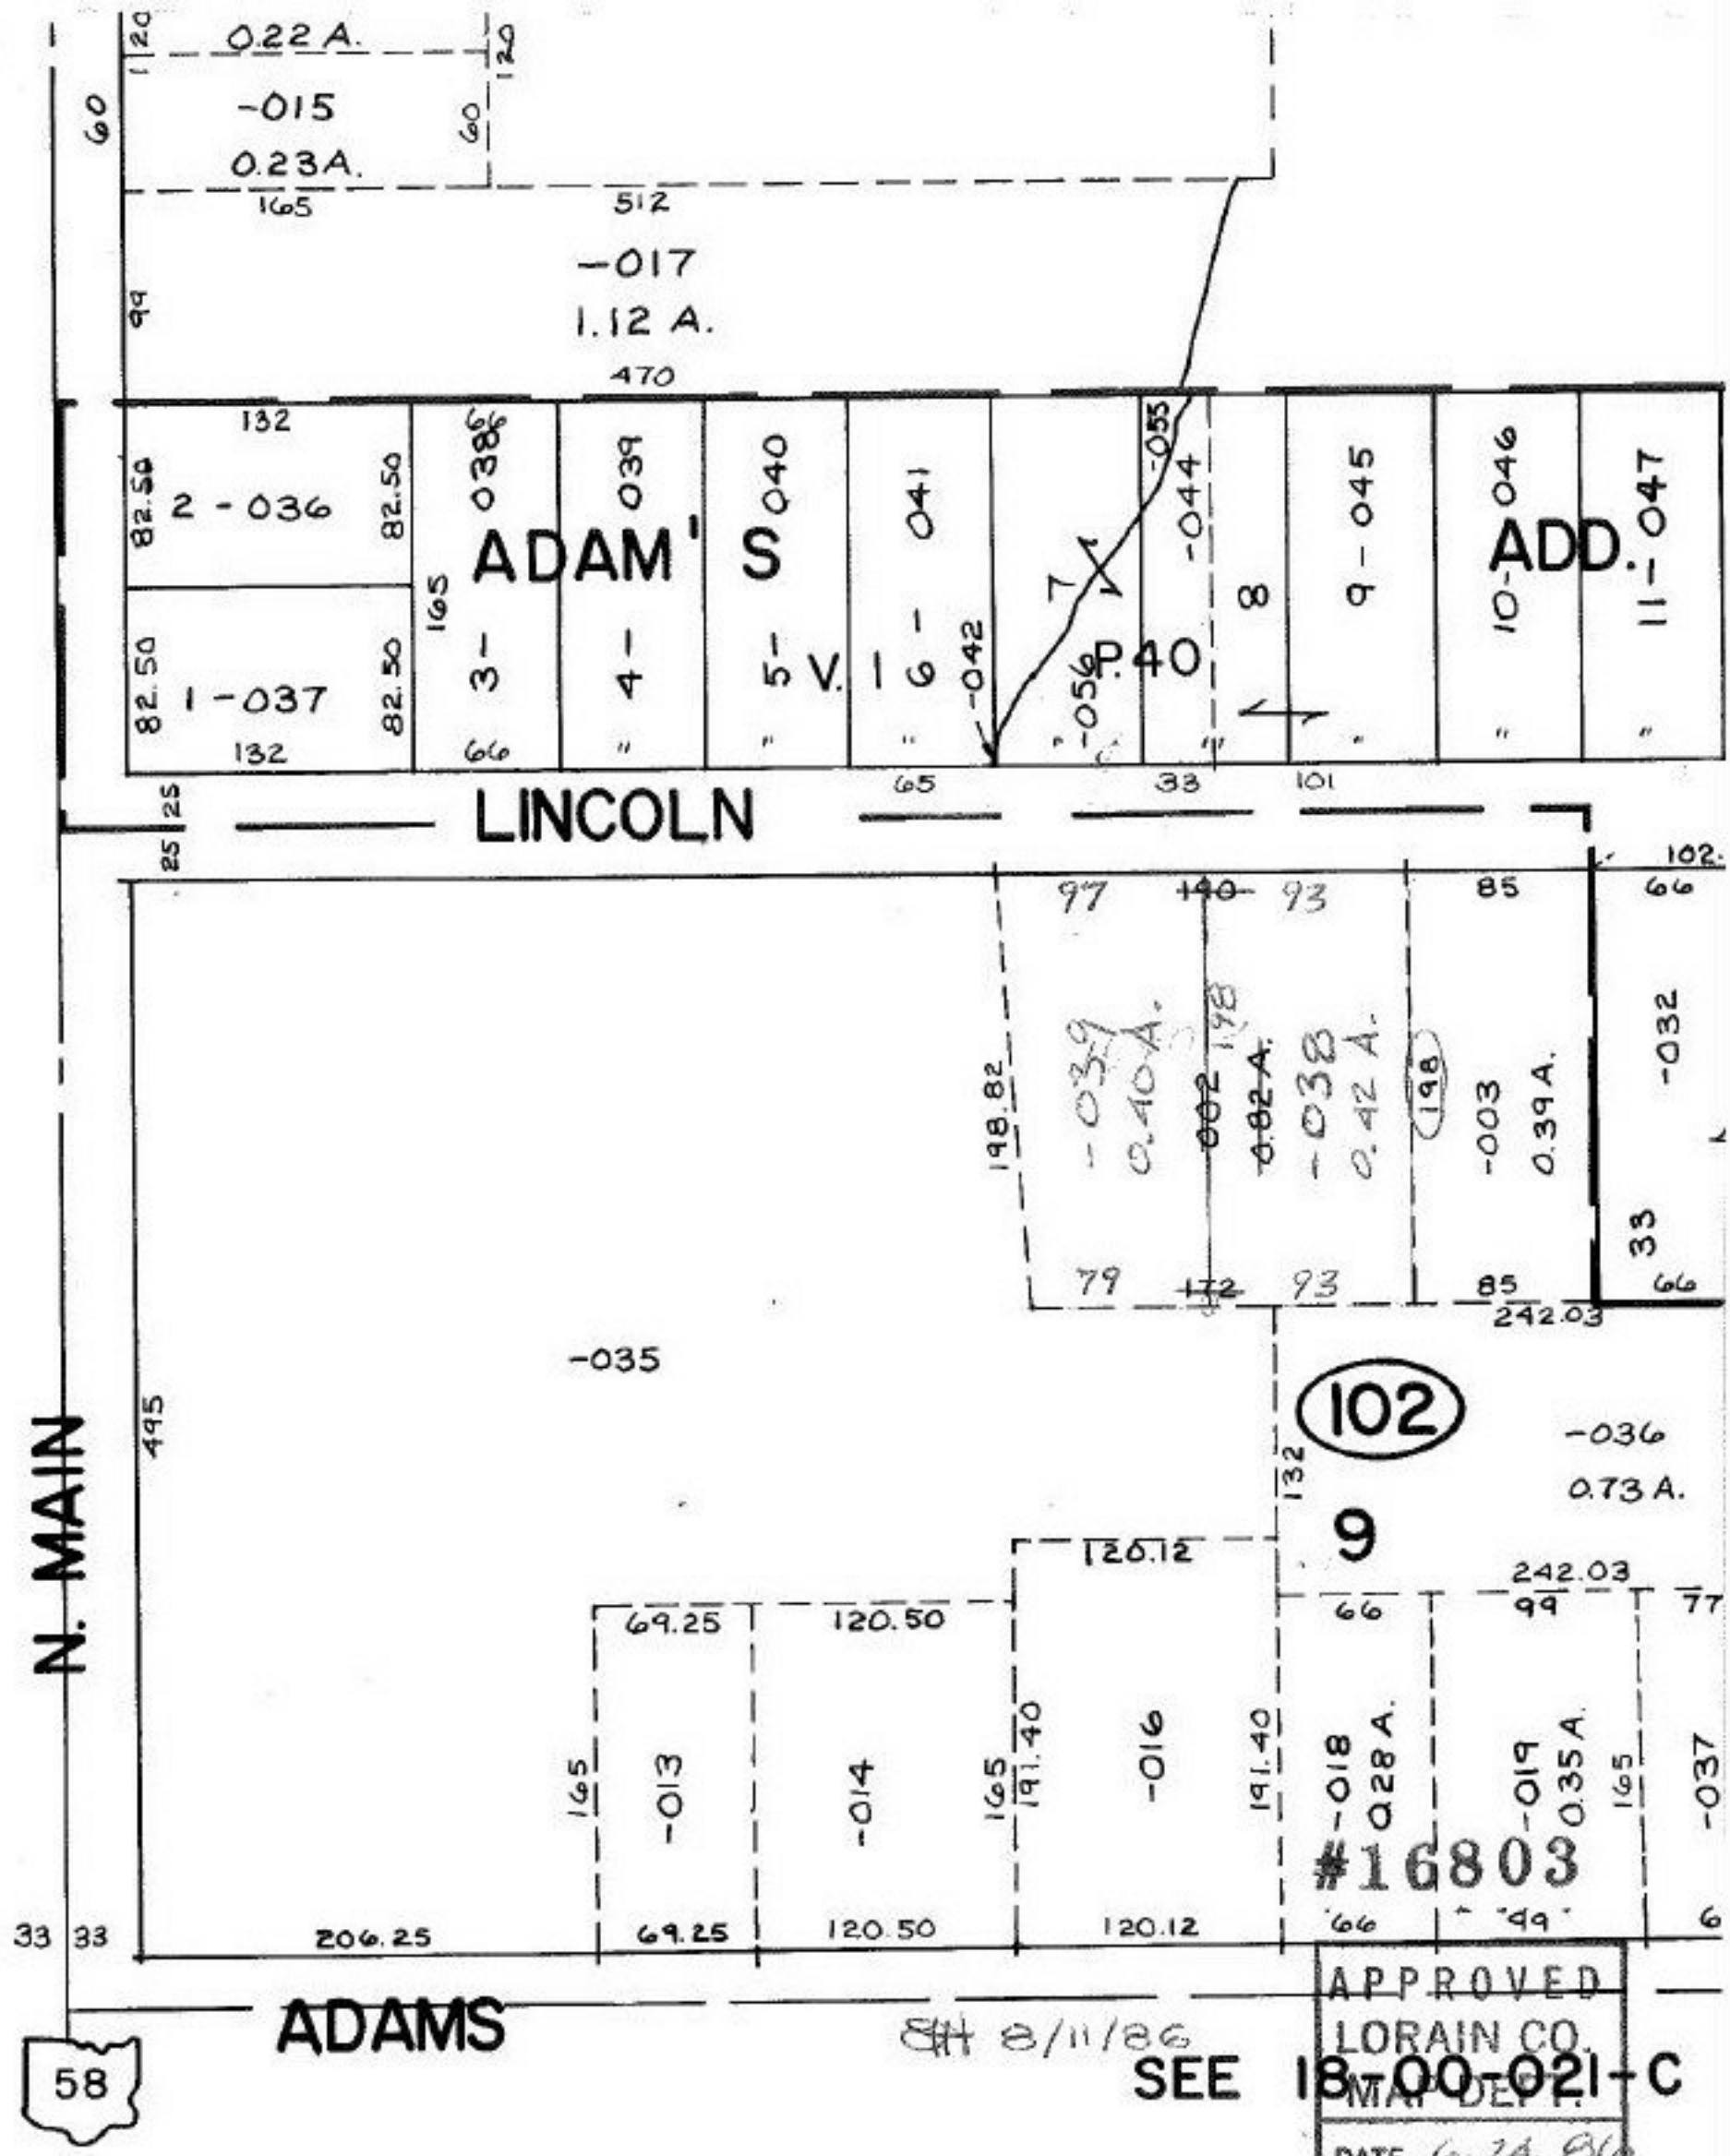
0.22 A.
-015
0.23A.
-017
1.12 A.
ADAM'S ADD.
V. 1 P. 40
2 - 036
1 - 037
3 - 038
4 - 039
5 - 040
6 - 041
7
8
9 - 045
10 - 046
11 - 047
-042
-044
-055
-056
LINCOLN
-039
0.40 A.
-038
0.42 A.
-003
0.39 A.
-032
-035
102
-036
0.73 A.
9
-013
-014
-016
-018
0.28 A.
-019
0.35 A.
-037
#16803
N. MAIN
ADAMS
58
SEE 18-00-021-C
APPROVED
LORAIN CO.
MAP DEPT.
DATE 6-24-86
PAGE 18-00-021-A
BY T. McNair
VOID AFTER