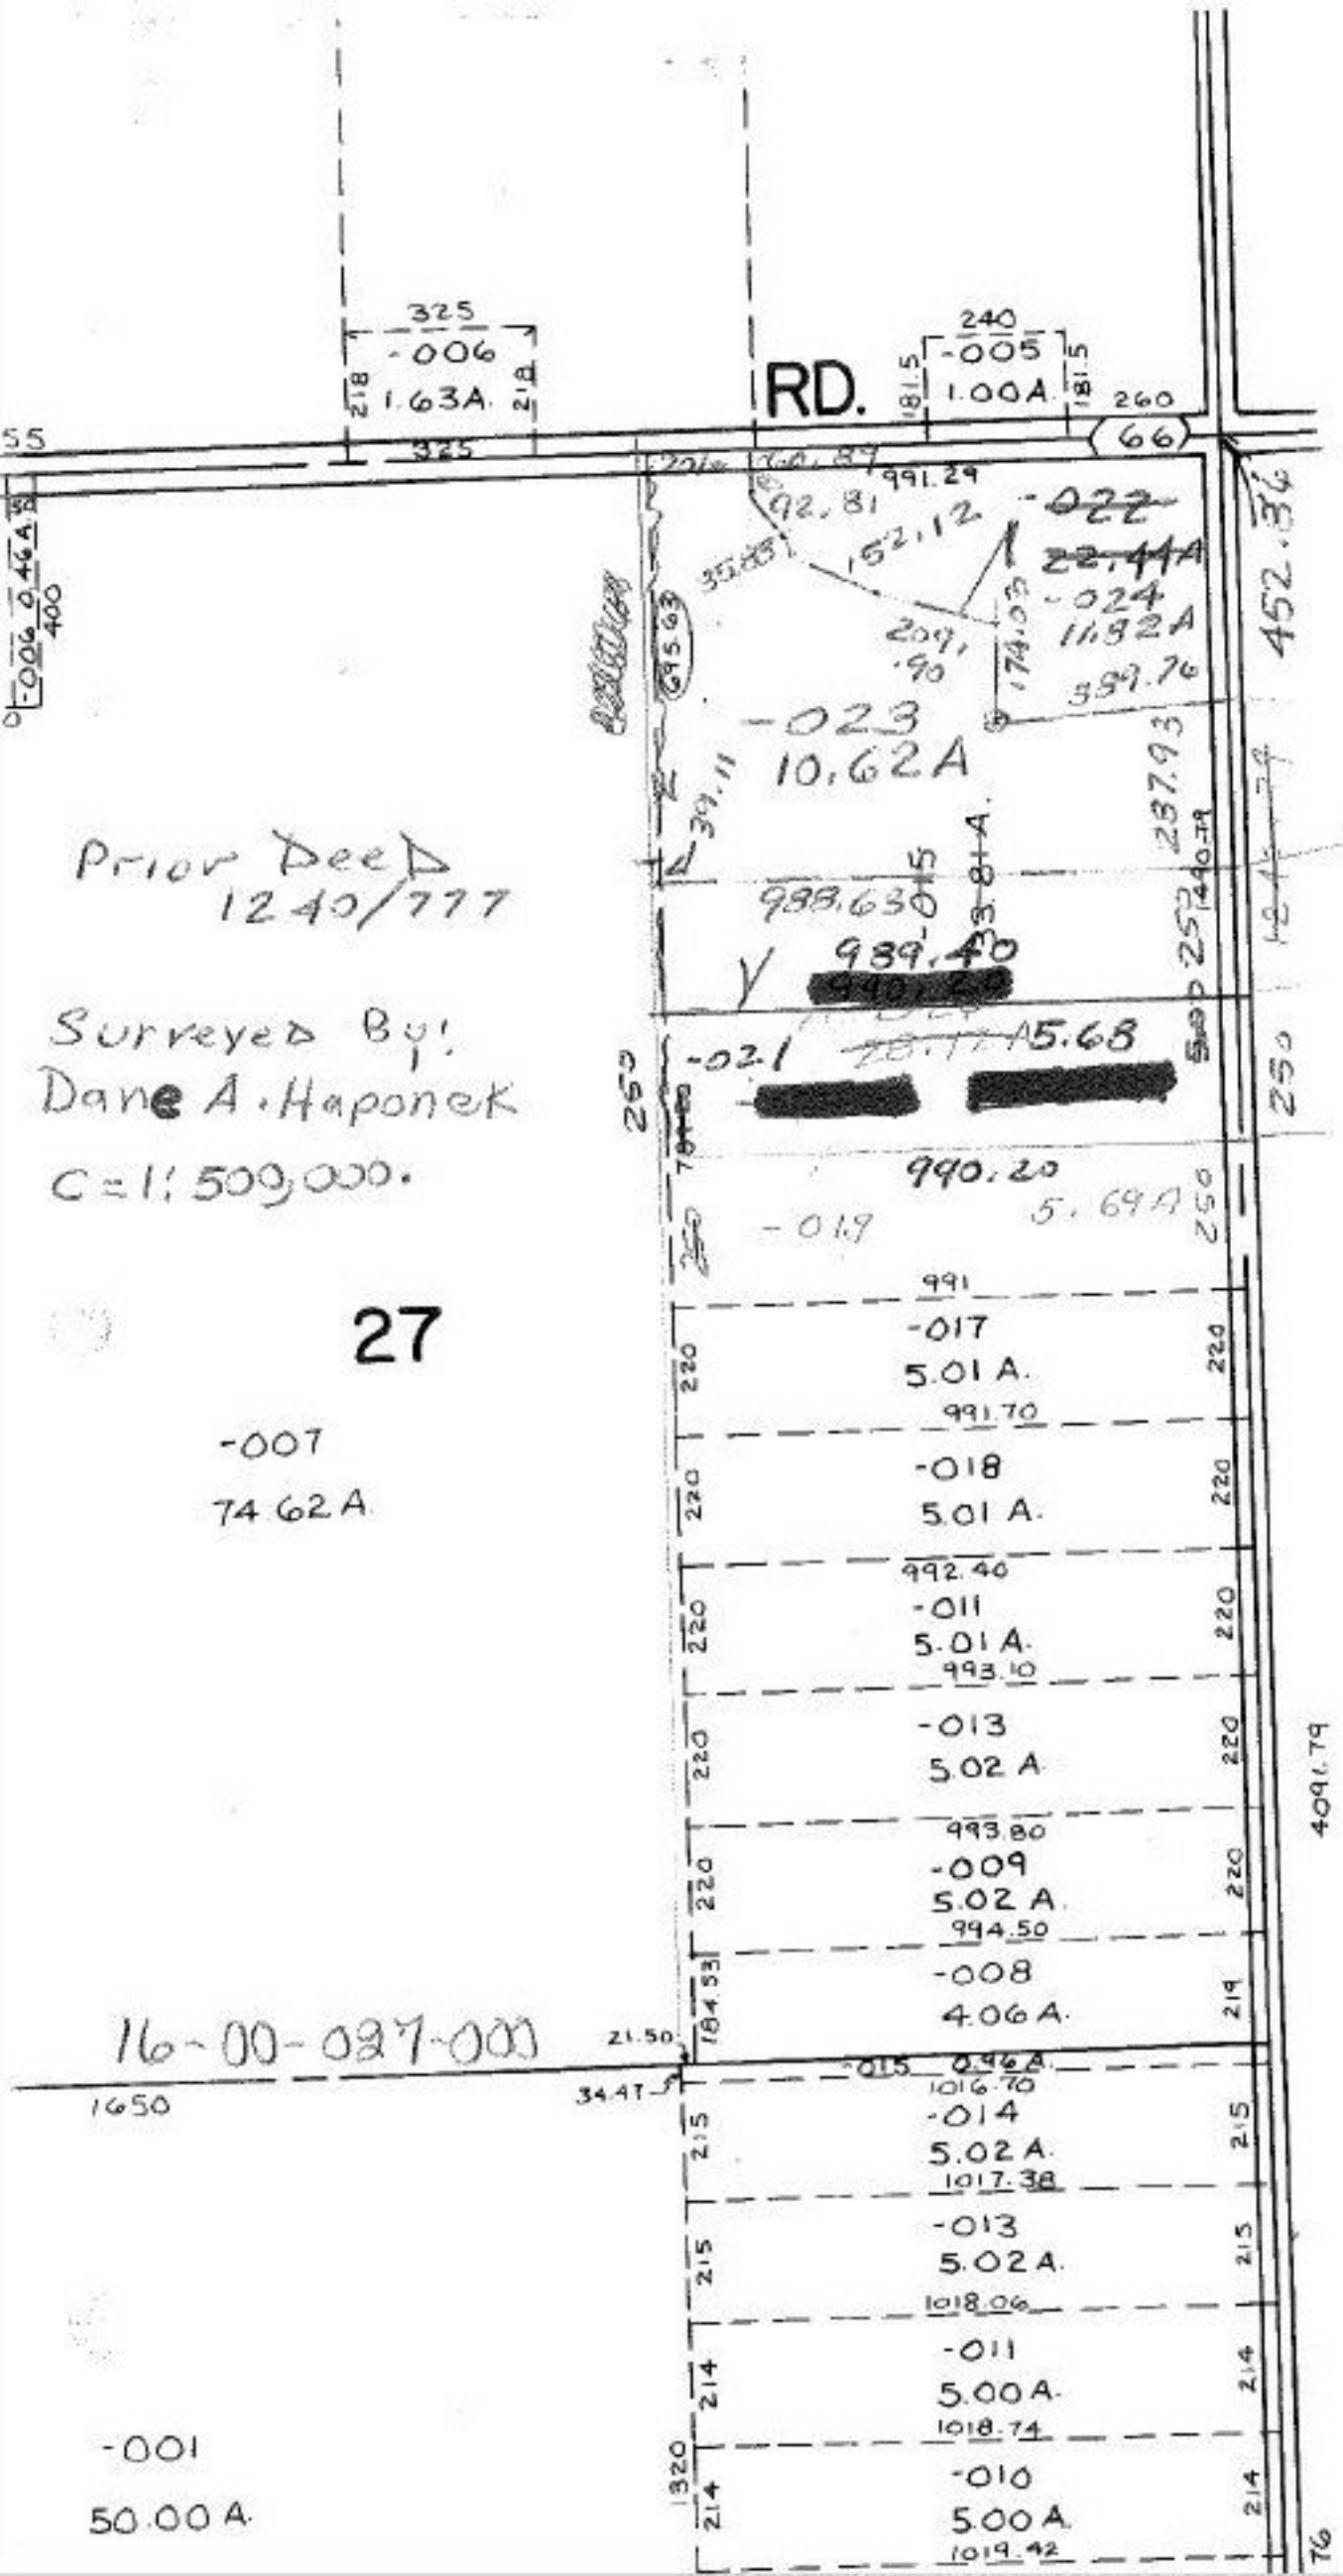

12-19-86
#16818

APPROVED
DRAIN CO.
MAP DEPT.
DATE 6-27-86
PAGE 16-C
BY C. Francis
VOID AFTER