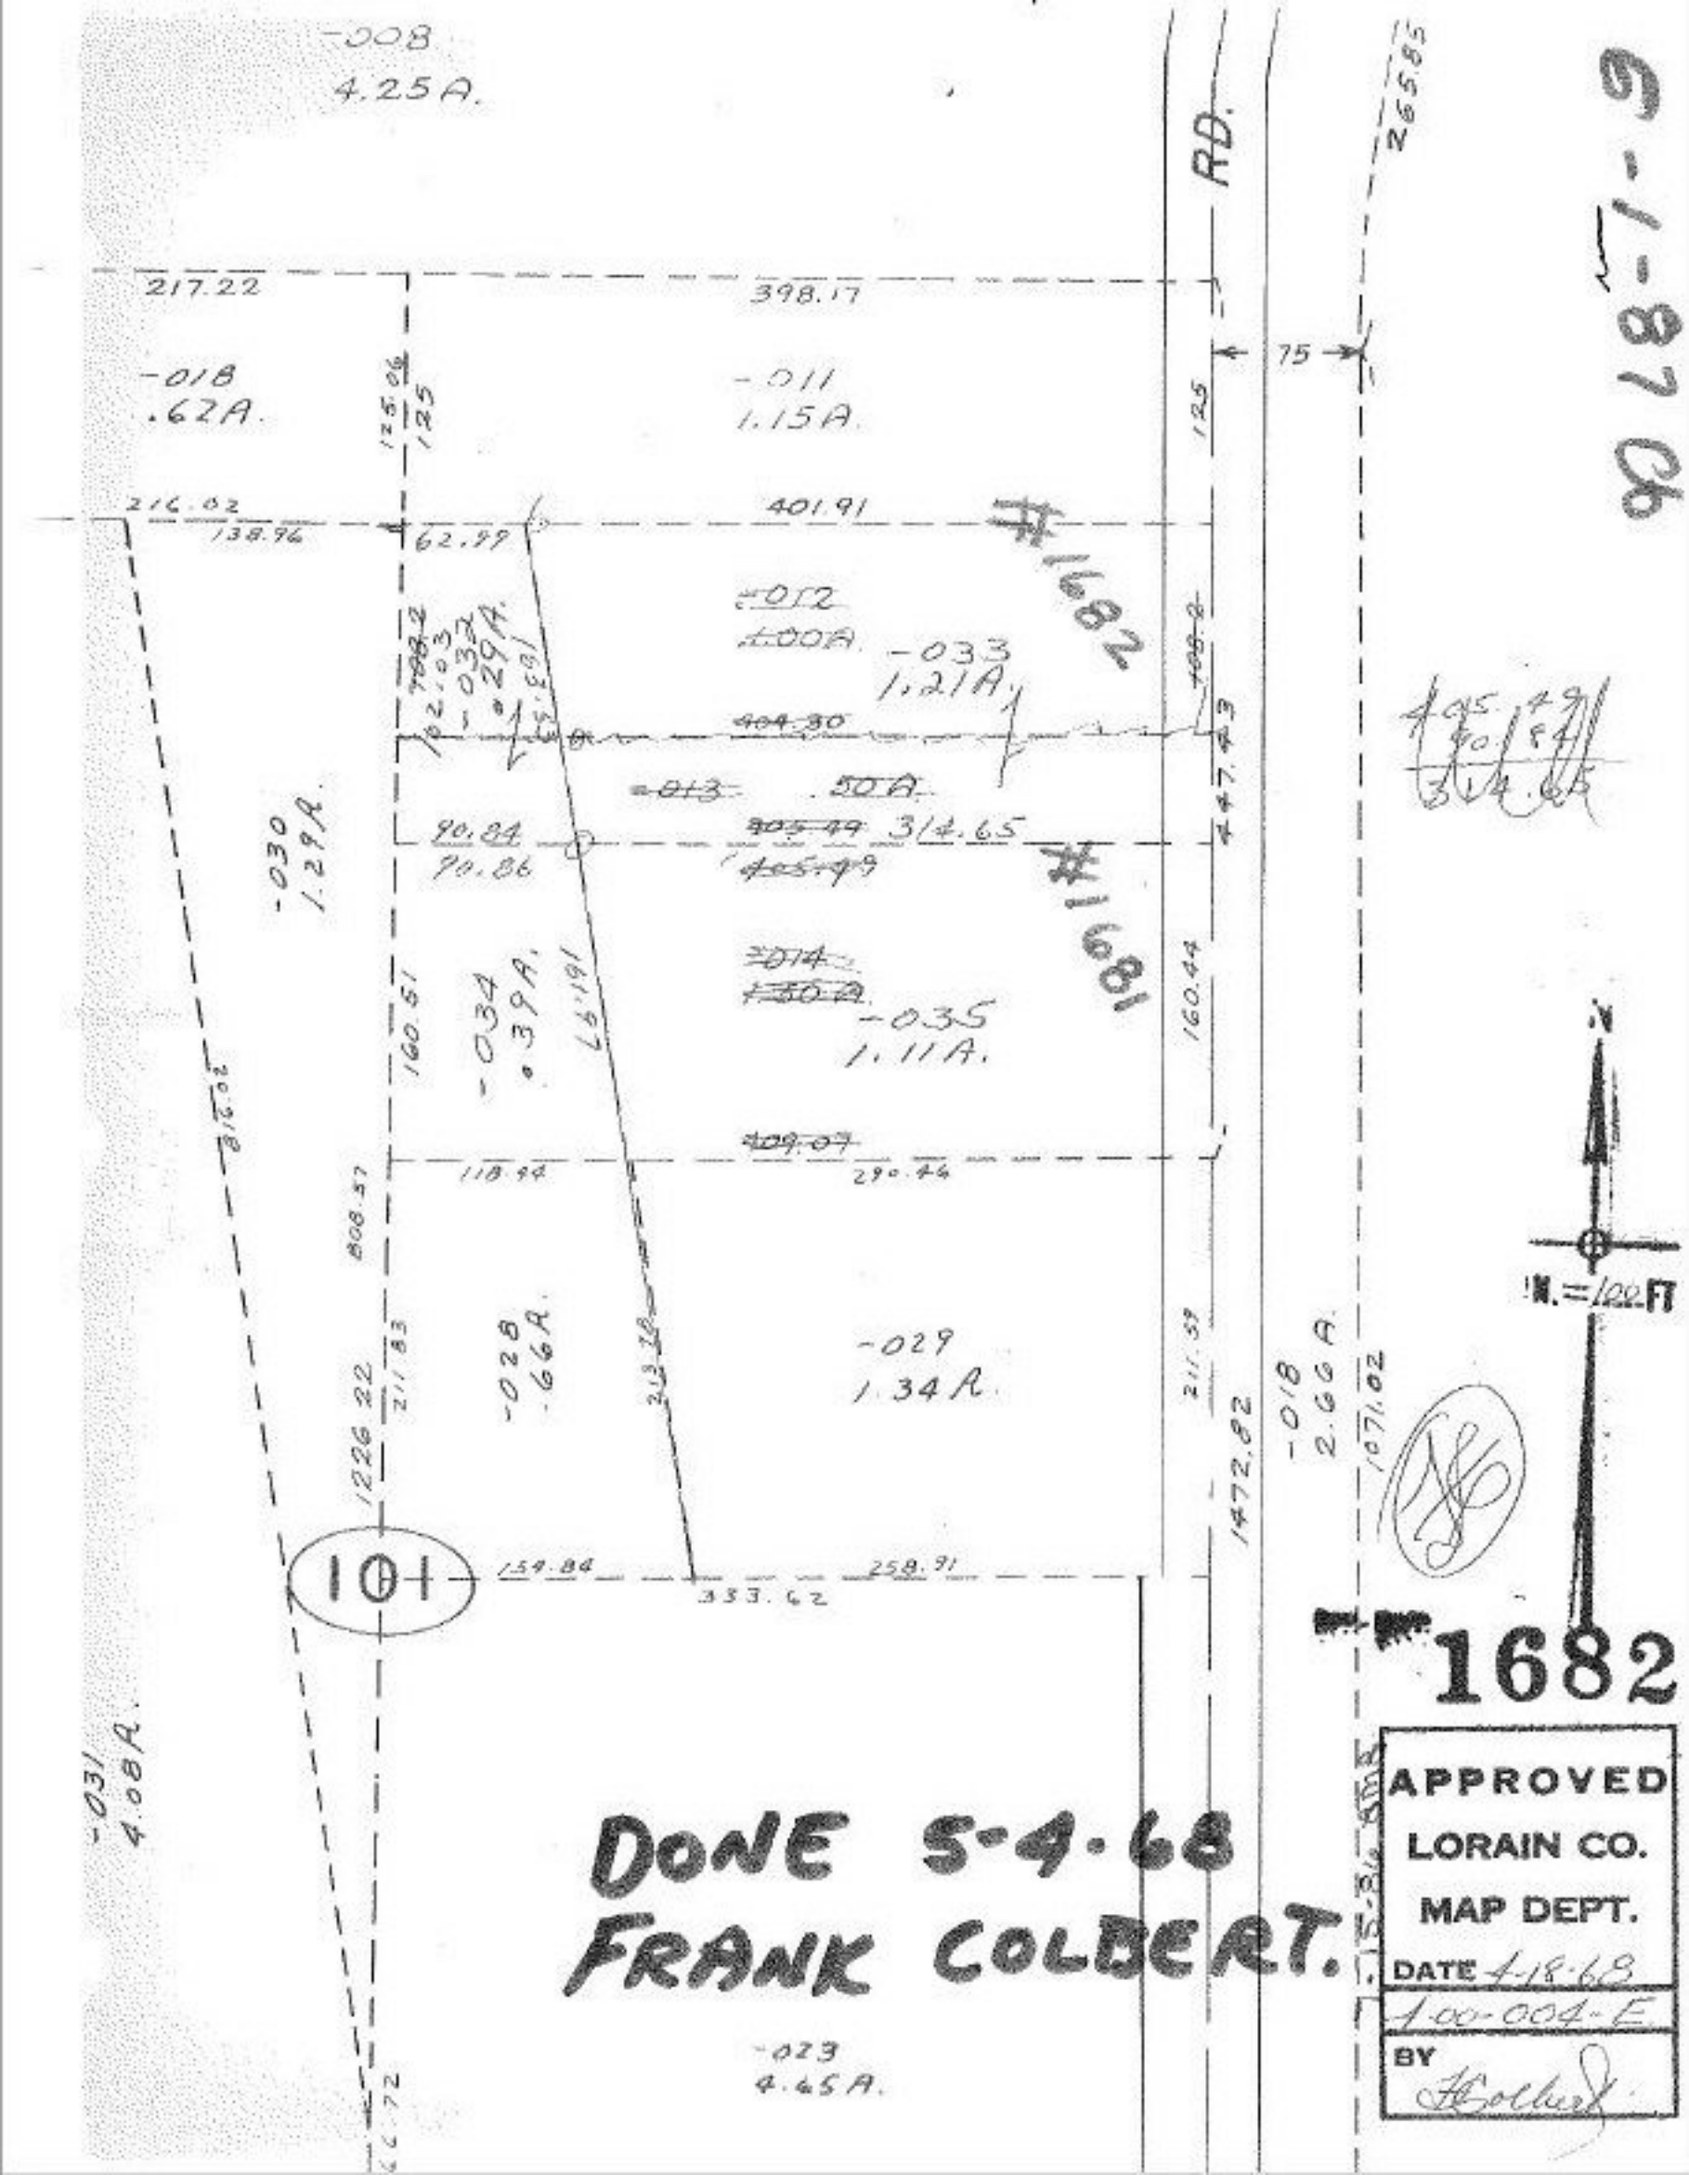

DONE 5-4-68
FRANK COLBERT.