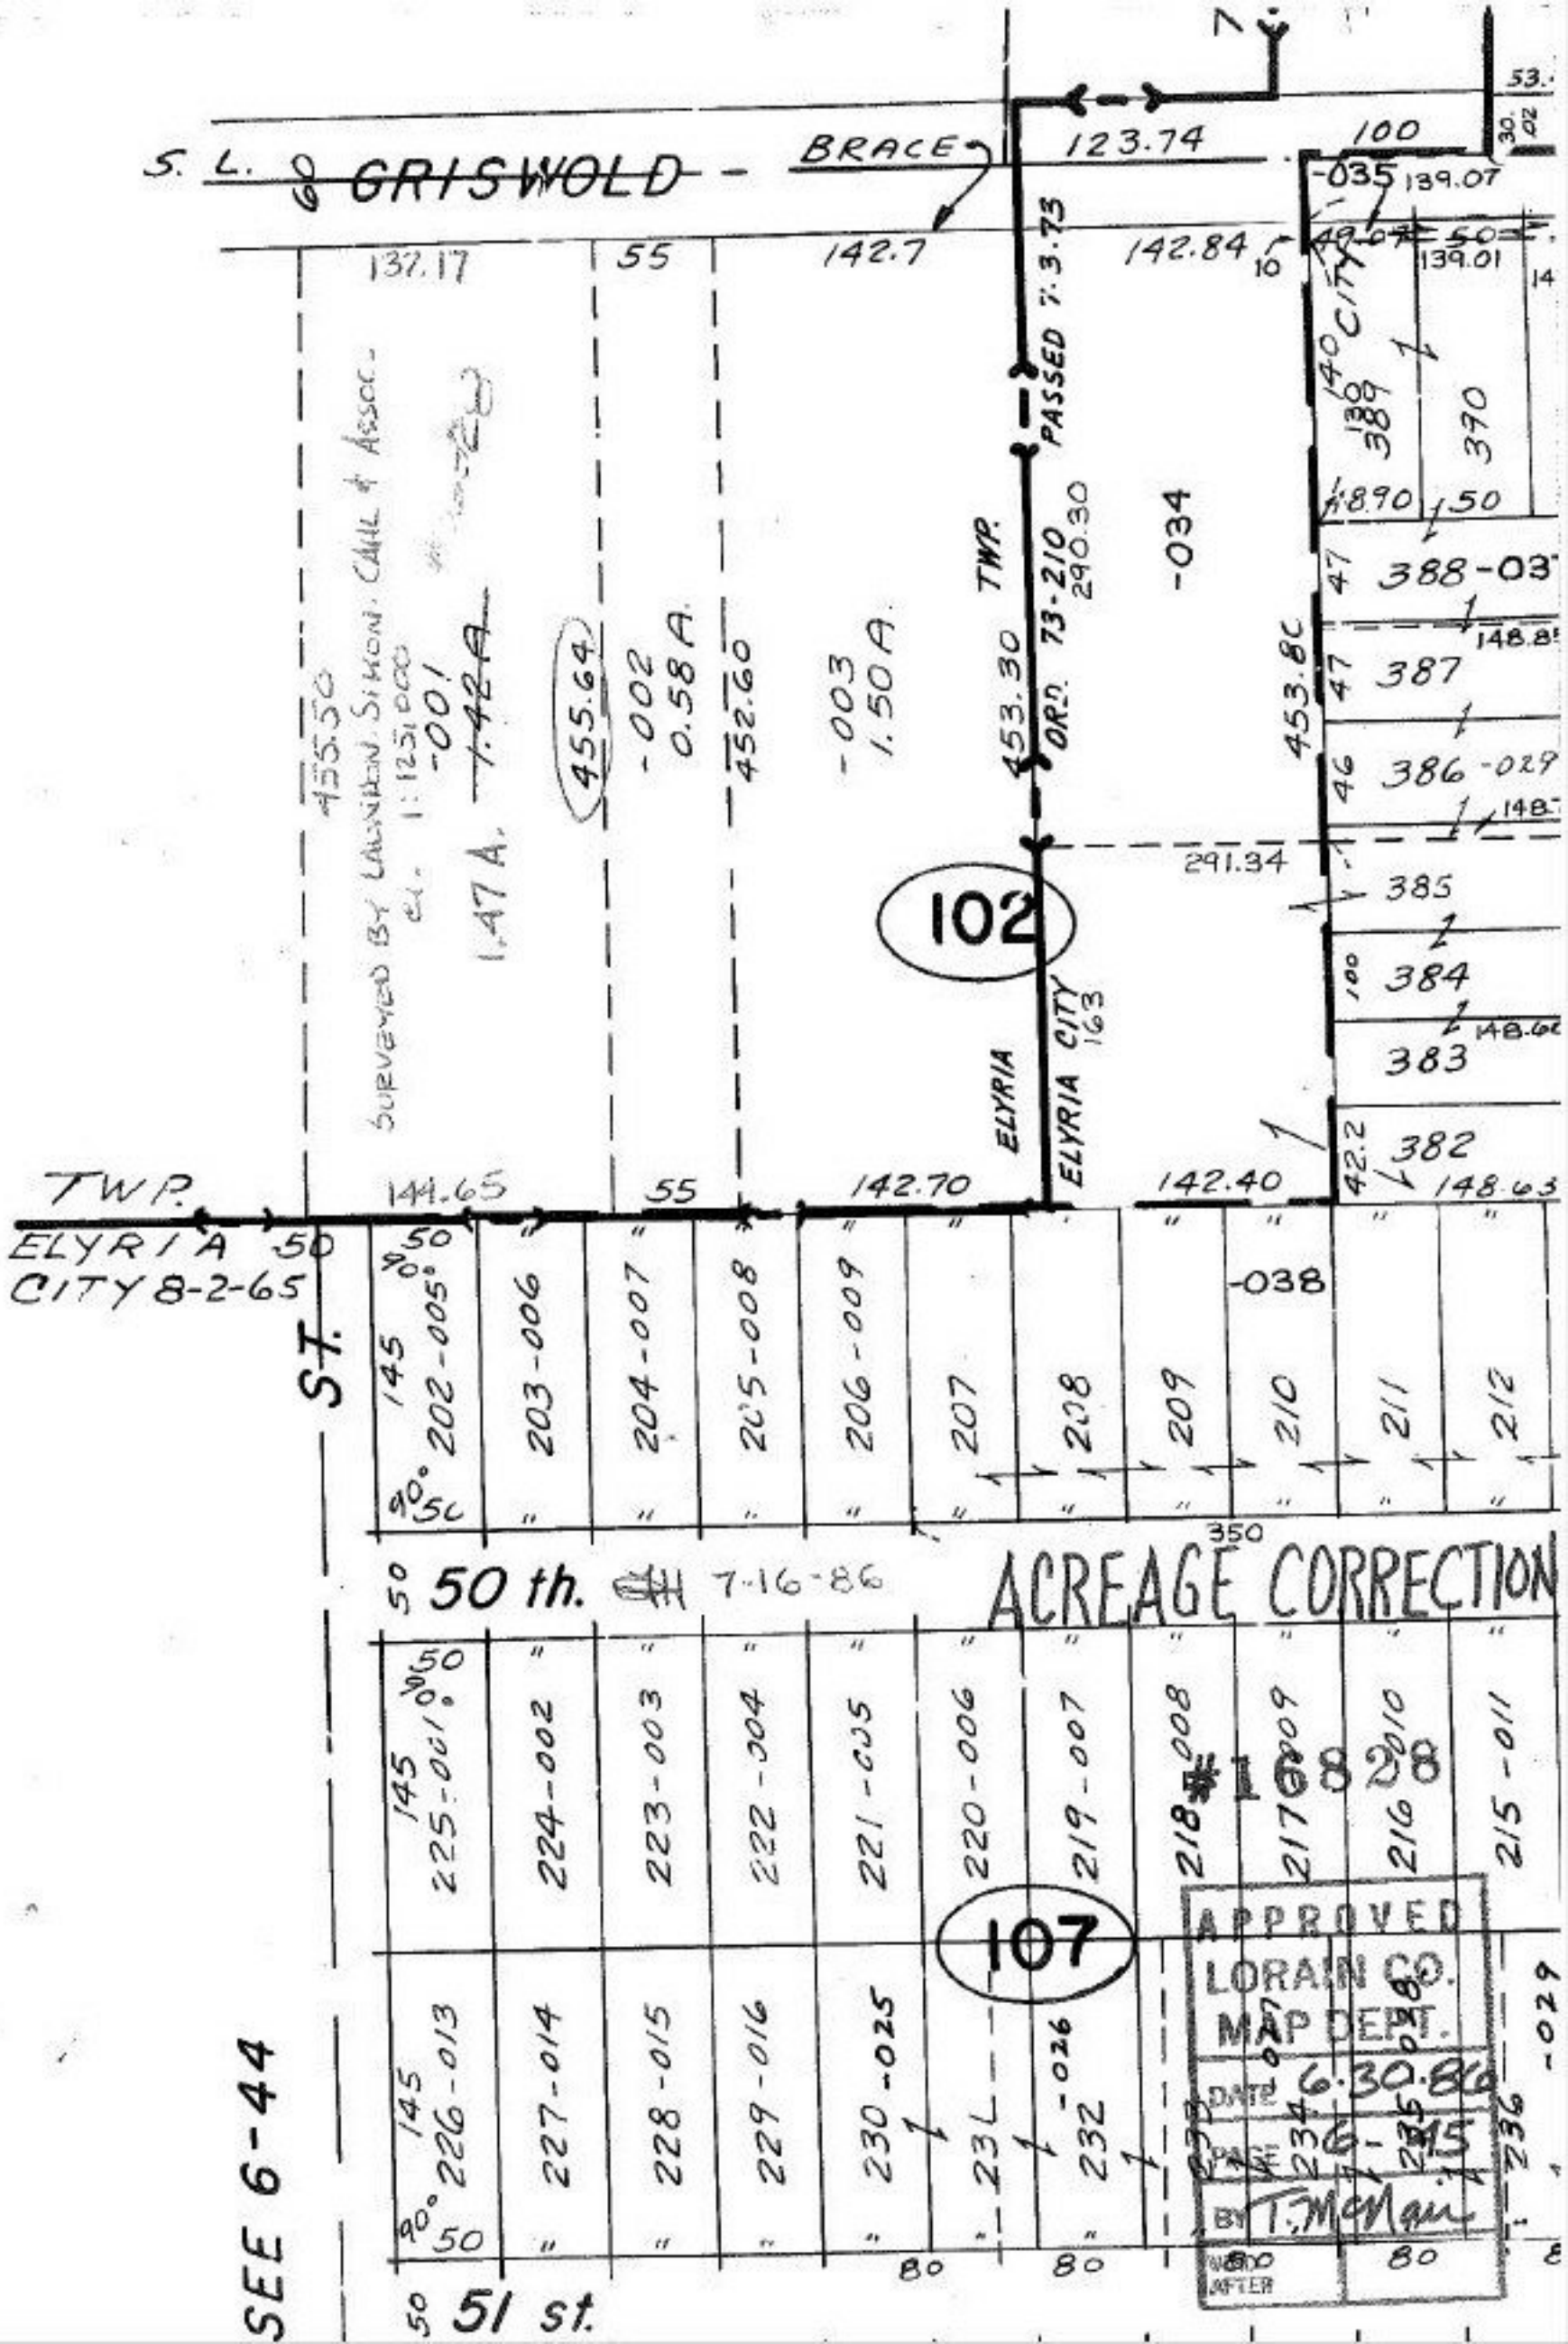
S. L. GRISWOLD
BRACE
123.74
100
-035
139.07
137.17
55
142.7
142.84
PASSED 7.3.73
CITY
389
390
-034
TWP.
ORD. 73-210
290.30
453.30
-002
0.58 A.
452.60
-003
1.50 A.
455.64
455.50
SURVEYED BY LAUNDON, SIMON, CAHL & ASSOC.
1:125,000
-001
1.47 A.
388-03
387
386-029
291.34
385
384
383
382
102
ELYRIA
ELYRIA CITY
163
TWP.
ELYRIA
CITY 8-2-65
144.65
55
142.70
142.40
148.63
-038
202-005
203-006
204-007
205-008
206-009
207
208
209
210
211
212
350
50 th.
7-16-86
ACREAGE CORRECTION
225-001
224-002
223-003
222-004
221-005
220-006
219-007
218-008
217-009
216-010
215-011
#16828
107
226-013
227-014
228-015
229-016
230-025
231
232
-026
234
235
236
-029
SEE 6-44
51 st.
APPROVED
LORAIN CO.
MAP DEPT.
DATE 6.30.86
PAGE 6-45
BY T. McNair
WORD AFTER