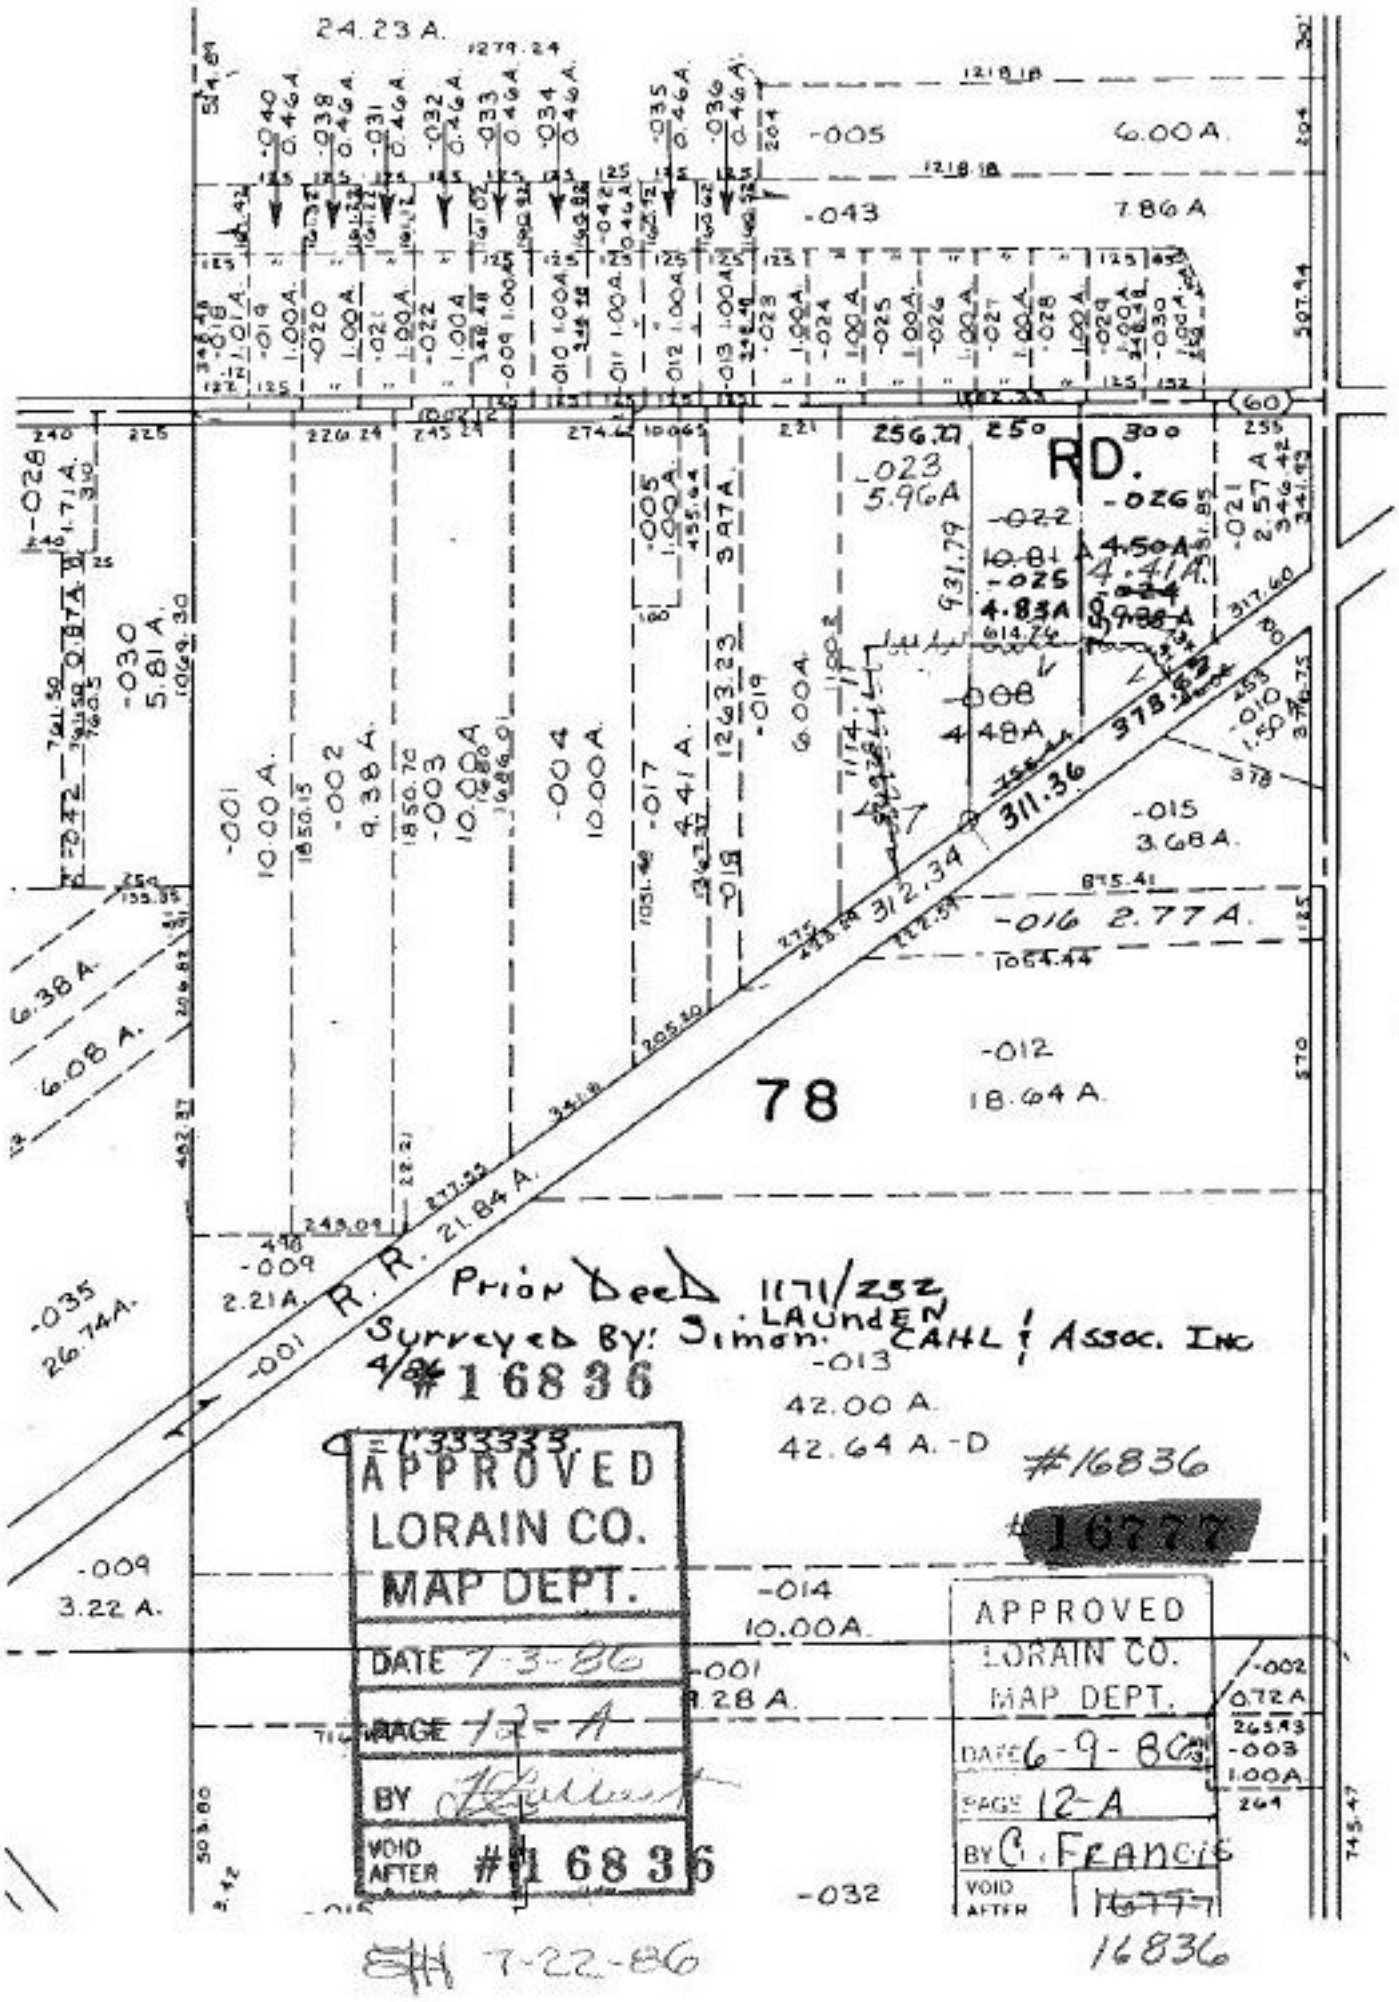
24.23 A.
-005
6.00 A.
-043
7.86 A
RD.
-026
-022
-025
-024
-023
5.96A
-021
2.57 A
-030
5.81 A.
-001
10.00 A.
-002
9.38 A.
-003
10.00A
-004
10.00A.
-017
4.41 A.
-019
6.00A.
-008
4.48A
-015
3.68A.
-016 2.77A.
-012
18.64 A.
78
6.38 A.
6.08 A.
-035
26.74A.
-009
2.21A.
R.R. 21.84 A.
-009
3.22 A.
-014
10.00A.
-001
9.28 A.
-013
42.00 A.
42.64 A.-D
-032
-002
0.72A
-003
1.00A
Prior Deed 1171/232
Surveyed By: Simon: LAUNDEN CAHL & Assoc. Inc
#16836
#16777
APPROVED
LORAIN CO.
MAP DEPT.
DATE 7-3-86
PAGE 12-A
BY
VOID AFTER #16836
APPROVED
LORAIN CO.
MAP DEPT.
DATE 6-9-86
PAGE 12-A
BY C. FRANCIS
VOID AFTER
7-22-86
16836