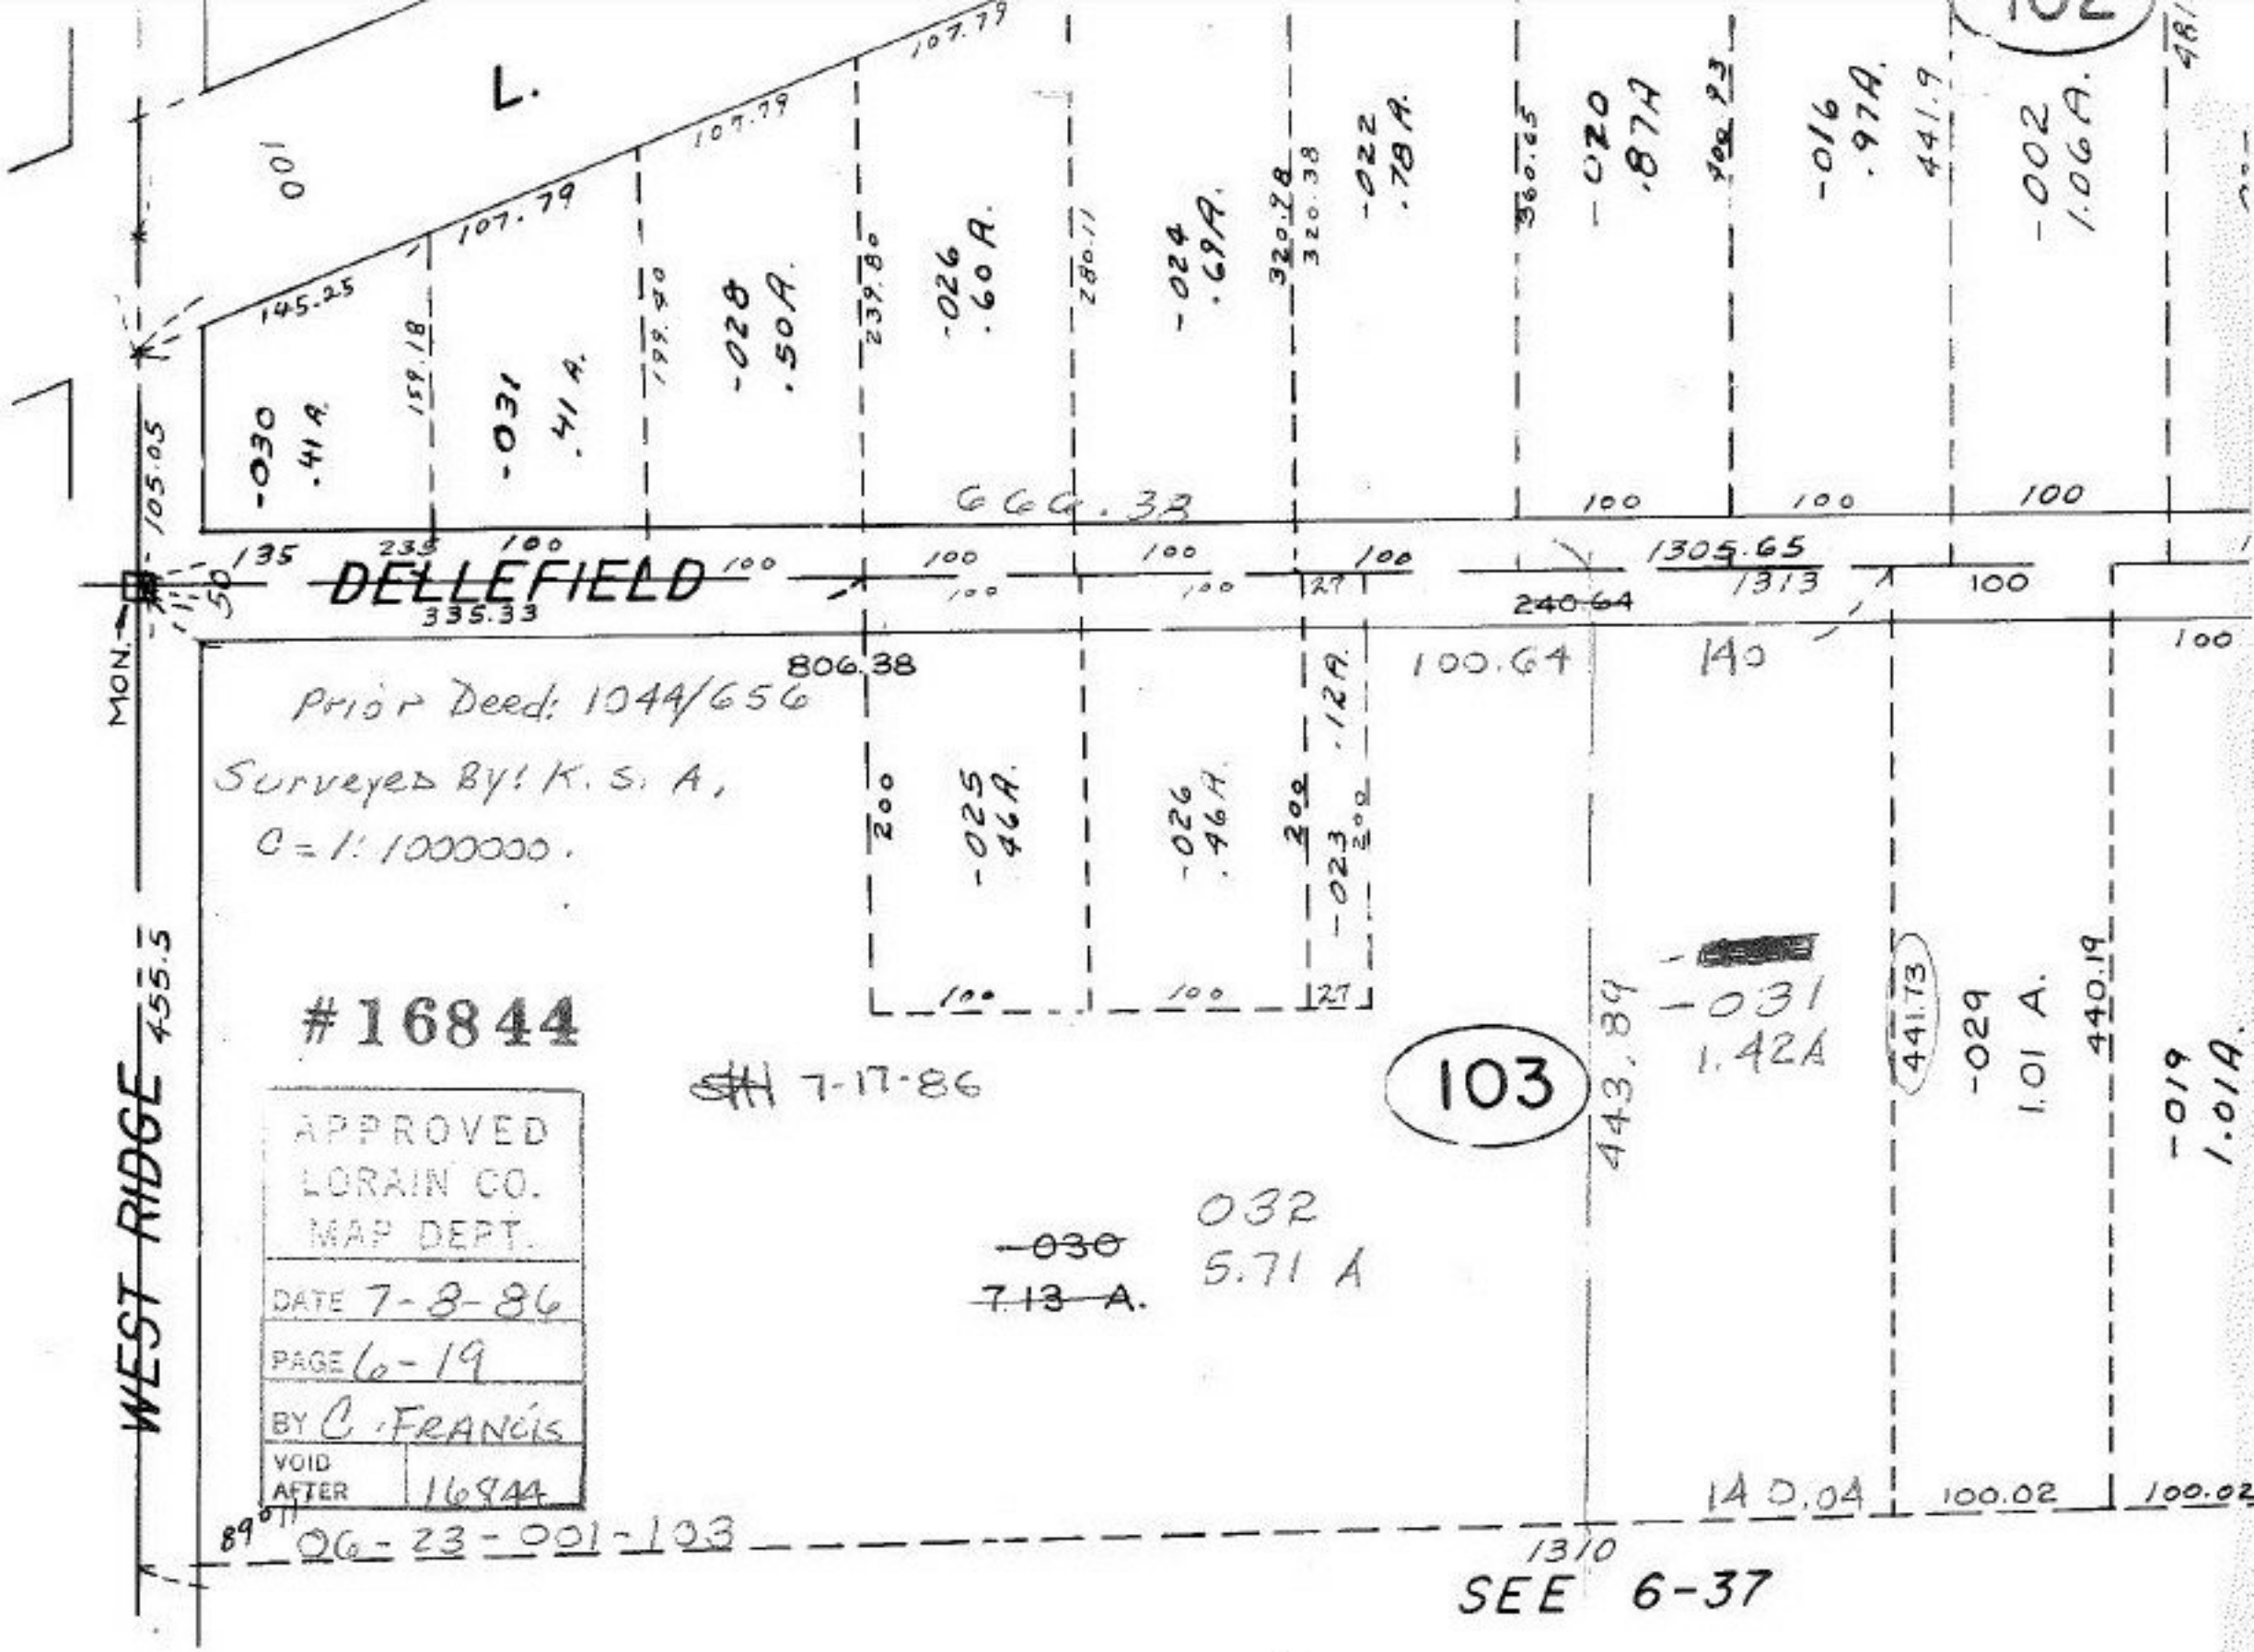

L.
DELLEFIELD
WEST RIDGE
MON.
Prior Deed: 1044/656
Surveyed By: K. S. A.
C = 1:1000000.
#16844
APPROVED
LORAIN CO.
MAP DEPT.
DATE 7-8-86
PAGE 6-19
BY C. FRANCIS
VOID AFTER 16844
7-17-86
103
-030 .41 A.
-031 .41 A.
-028 .50 A.
-026 .60 A.
-024 .69 A.
-022 .78 A.
-020 .87 A
-016 .97 A.
-002 1.06 A.
-025 .46 A.
-026 .46 A.
-023 .12 A.
-031 1.42 A
-029 1.01 A.
-019 1.01 A.
-030 7.13 A.
032 5.71 A
666.38
806.38
1305.65
1313
240.64
100.64
140
443.89
441.73
440.19
140.04
100.02
1310
06-23-001-103
SEE 6-37