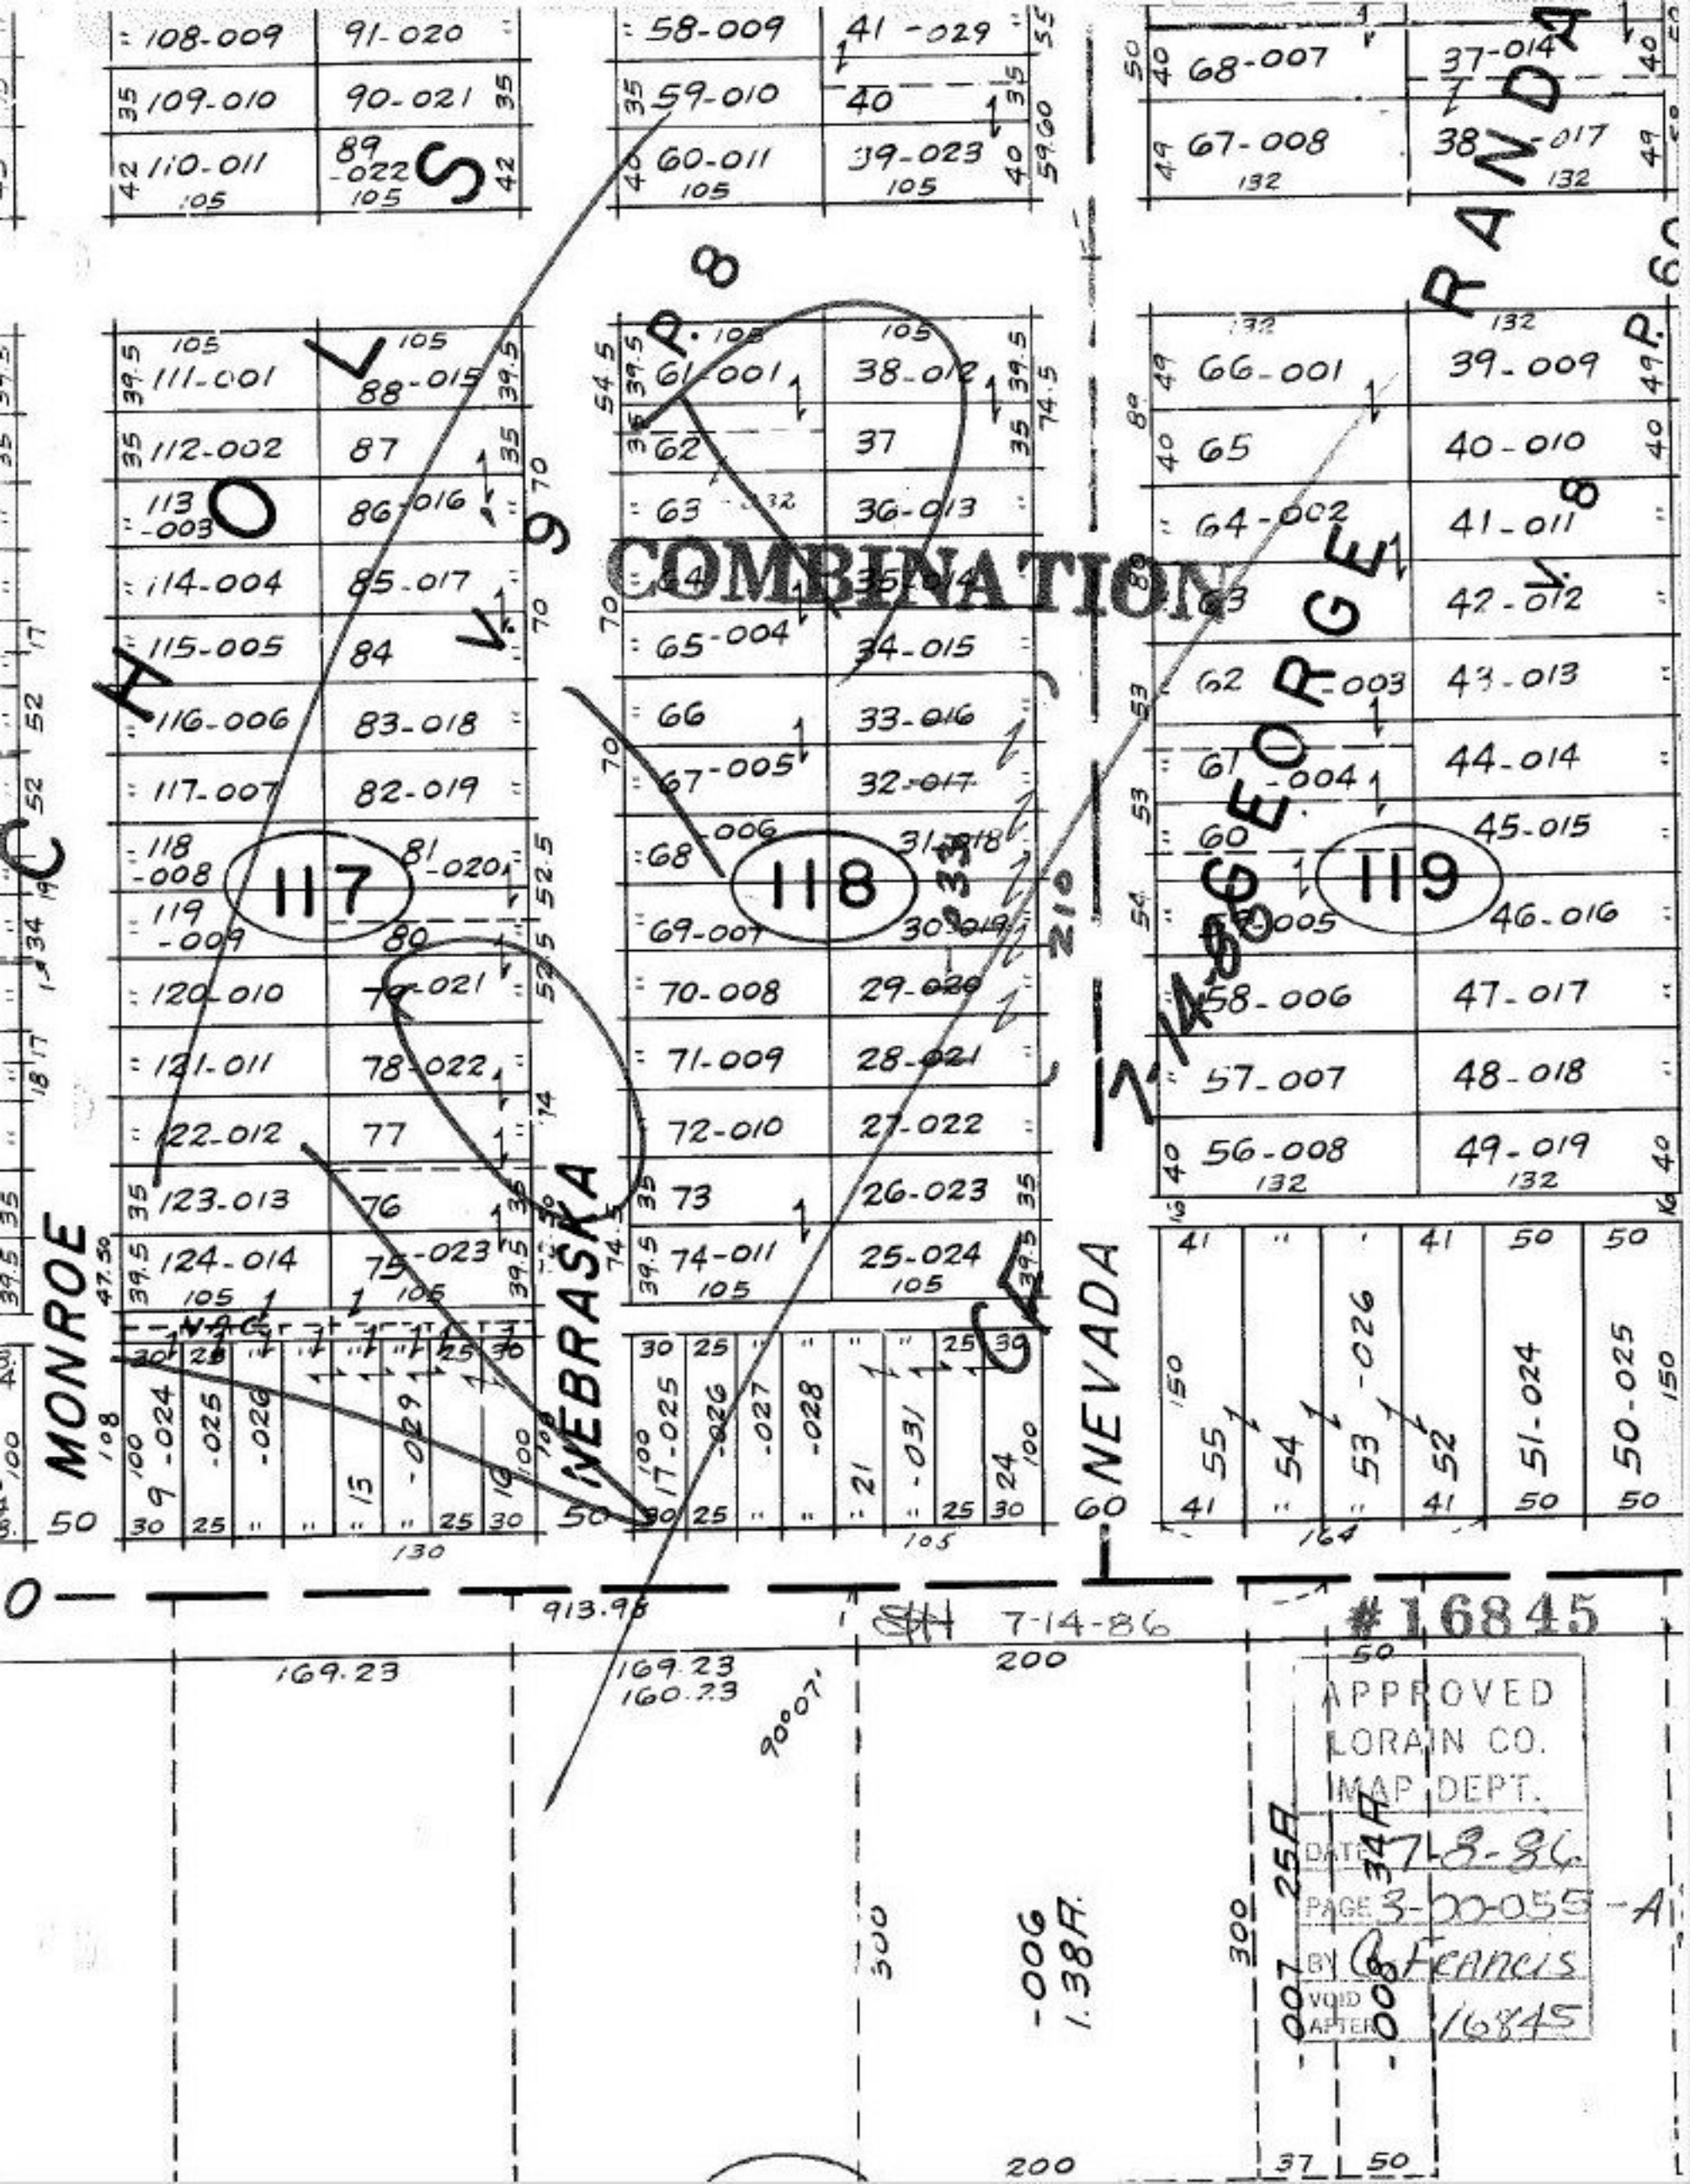
COMBINATION
117
118
119
MONROE
NEBRASKA
NEVADA
GEORGE
RANDA
V. 9
V. 8
P. 8
P. 60
7-14-86
#16845
APPROVED
LORAIN CO.
MAP DEPT.
DATE 7-8-86
PAGE 3-00-055-A
BY C. Francis
VOID AFTER 16845
913.98
169.23
169.23
160.23
200
300
-006
1.38A.
-007 25A
-008 34A