00-076-A

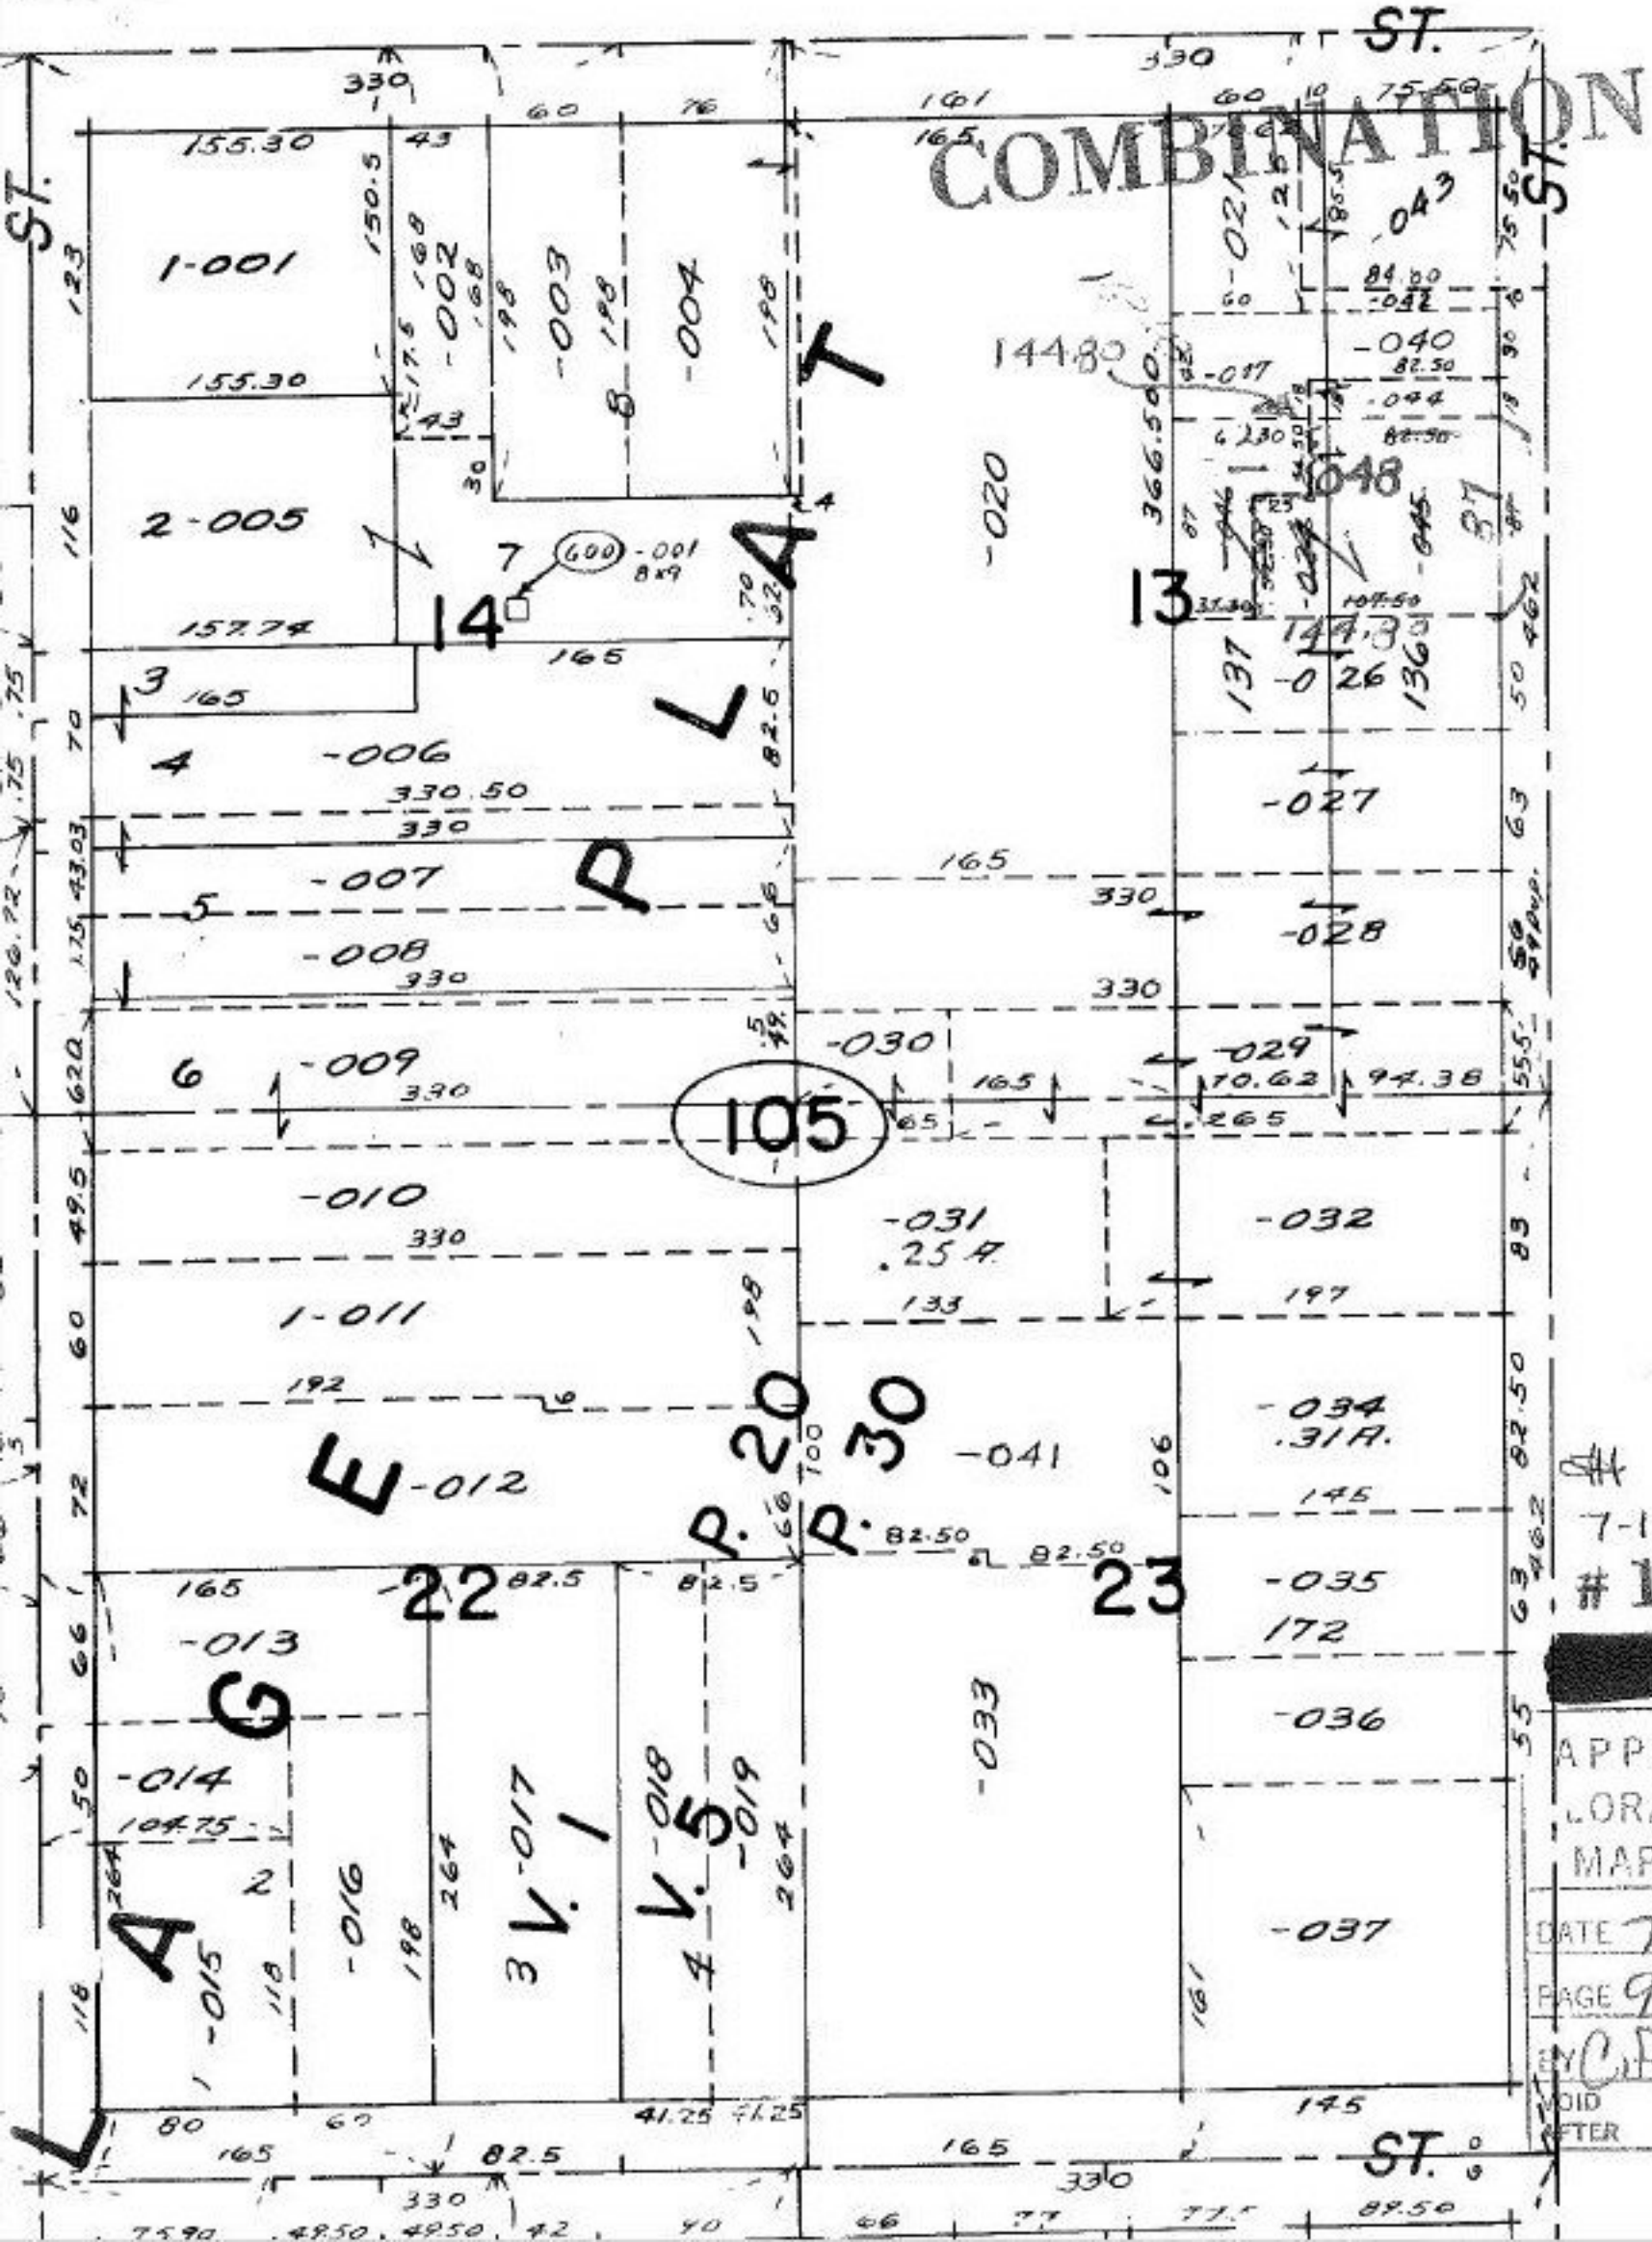

7-17-86

#16848

[redacted]

APPROVED
LORAIN CO.
MAP DEPT.

DATE 7-14-86

PAGE 9-00-086-A

BY C. Francis

VOID AFTER 16848