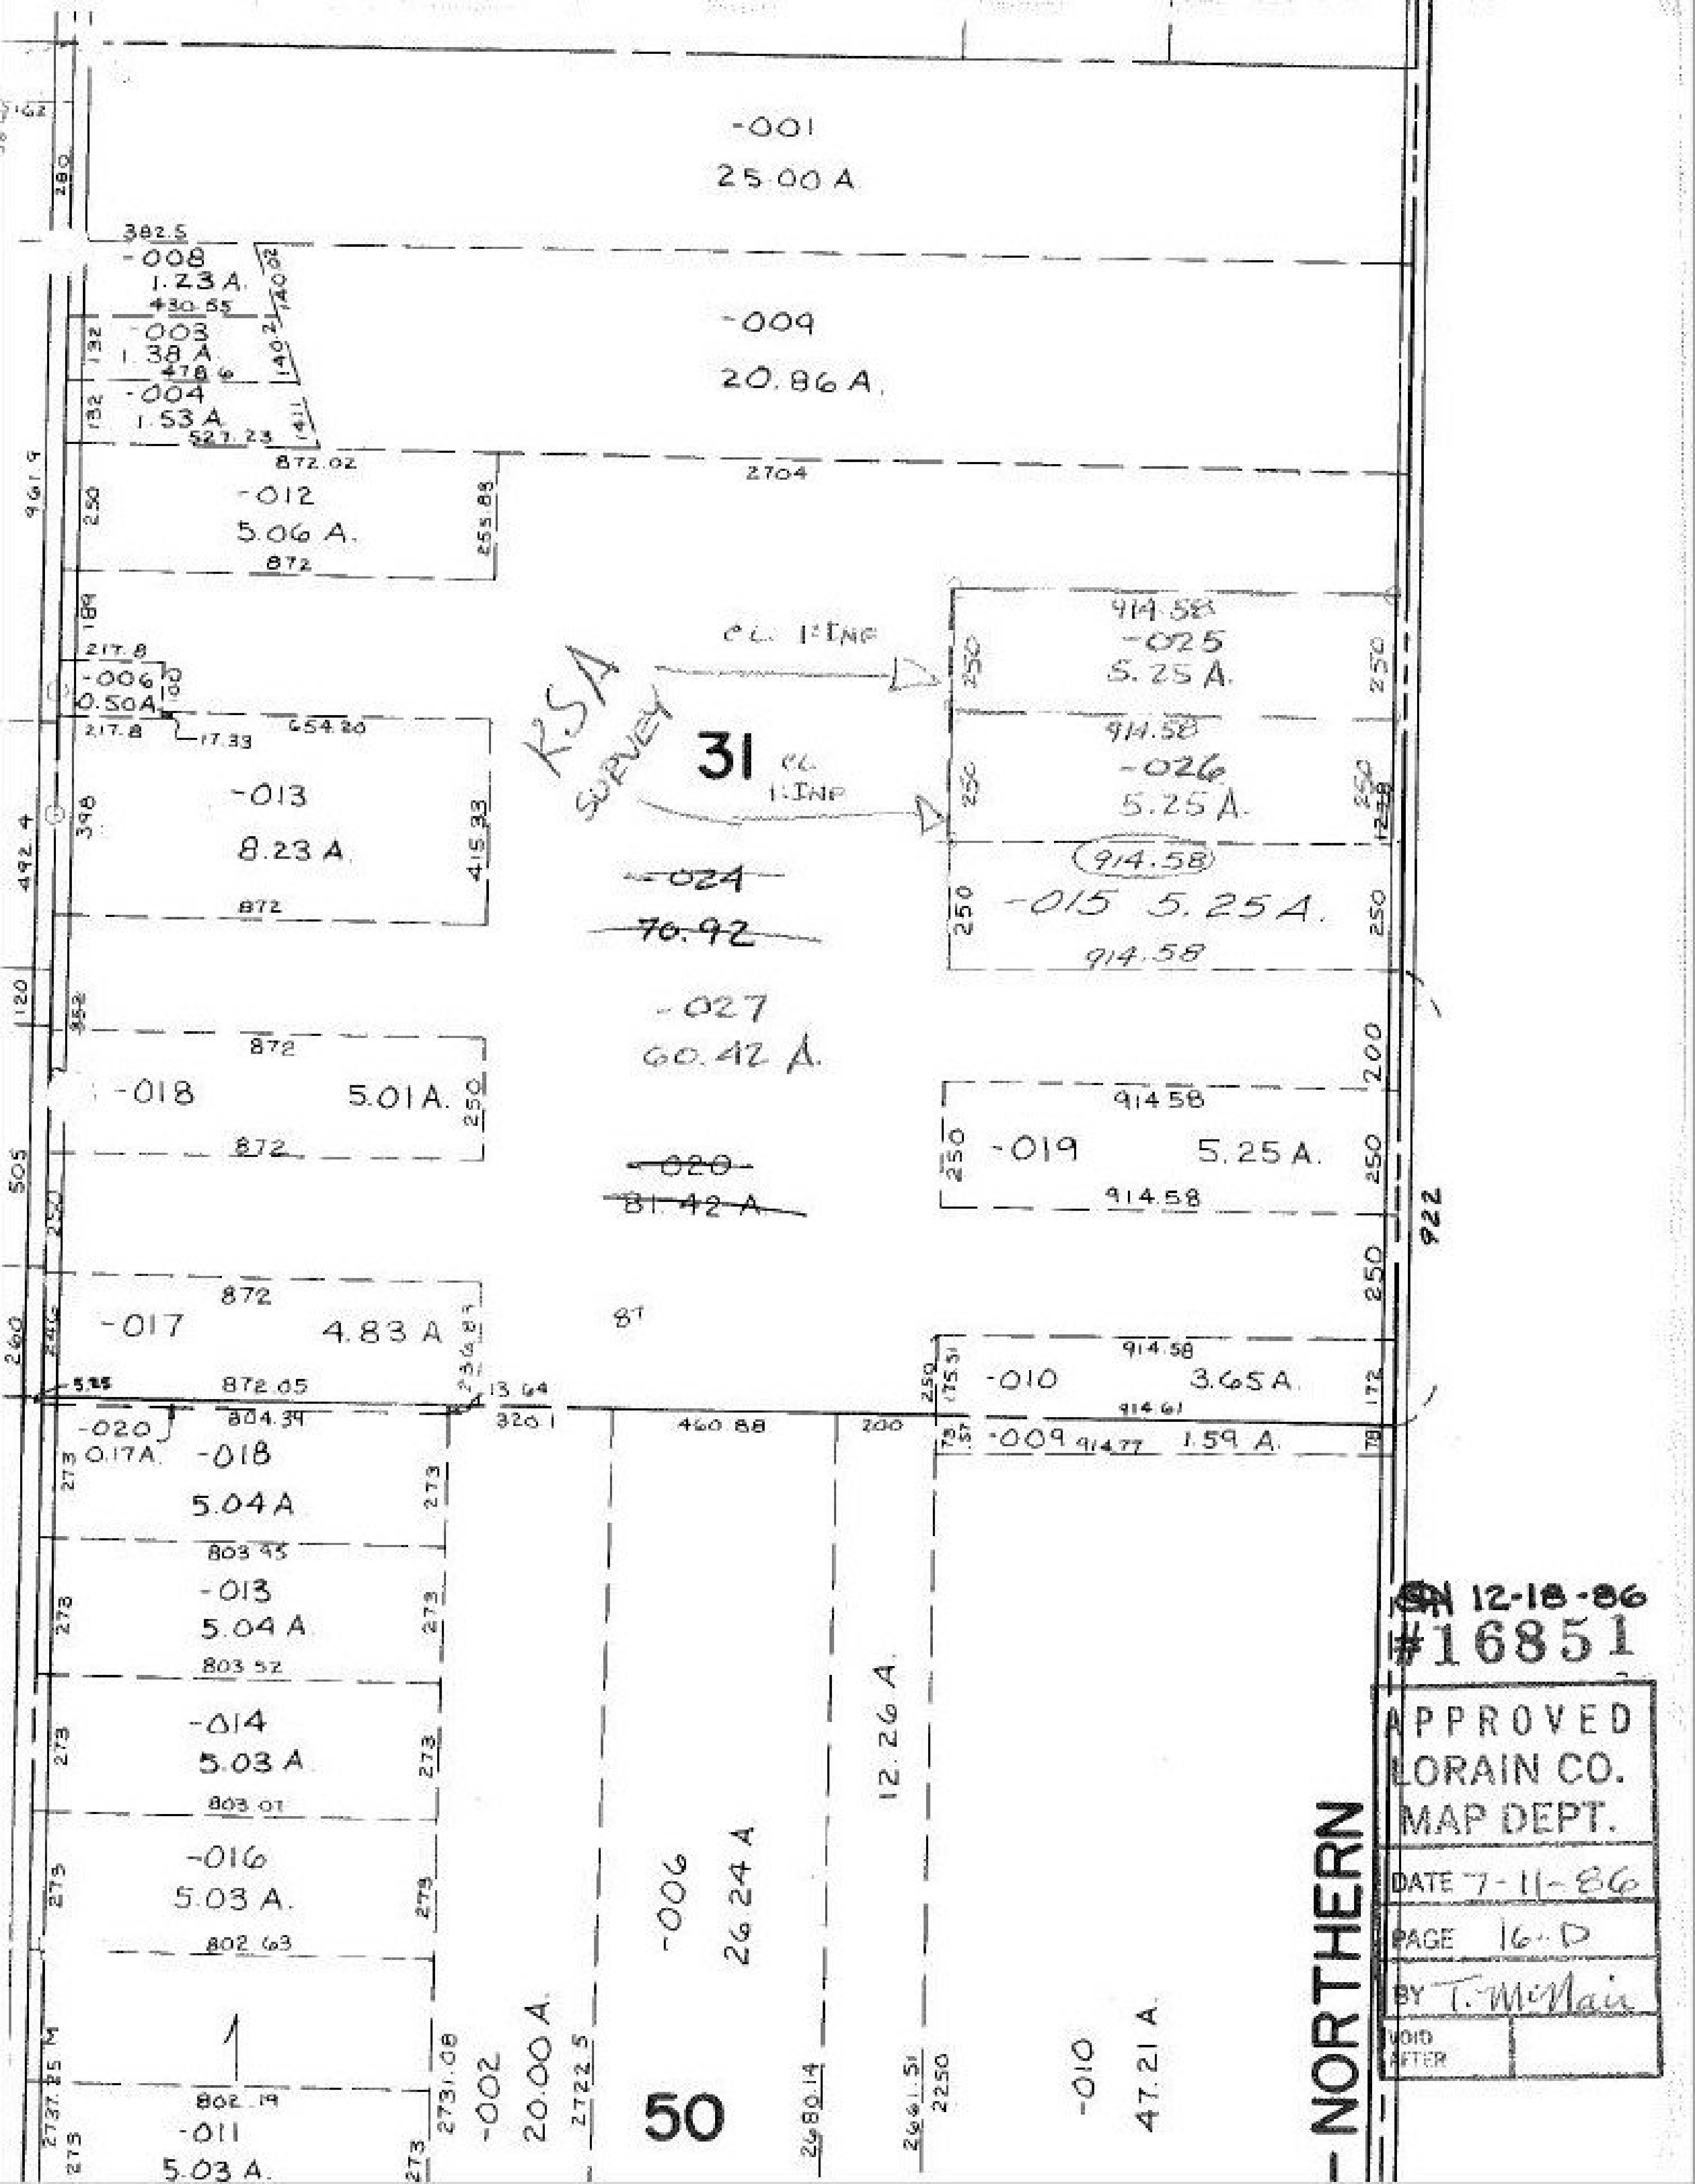
-001
25.00 A
-008
1.23 A.
-003
1.38 A
-004
1.53 A
-009
20.86 A.
-012
5.06 A.
2704
-006
0.50A
-013
8.23 A
-025
5.25 A.
-026
5.25 A.
-015 5.25 A.
914.58
31
RSA SURVEY
cl. 1-Inp
-024
70.92
-027
60.42 A.
-020
81.42 A.
-018
5.01A.
-019
5.25 A.
-017
4.83 A
-010
3.65 A.
-009
1.59 A.
922
-020
0.17A.
-018
5.04 A
-013
5.04 A
-014
5.03 A
-016
5.03 A.
-011
5.03 A.
-002
20.00 A.
-006
26.24 A
12.26 A.
-010
47.21 A.
50
NORTHERN
12-18-86
#16851
APPROVED
LORAIN CO.
MAP DEPT.
DATE 7-11-86
PAGE 16-D
BY T. McNair
VOID
AFTER