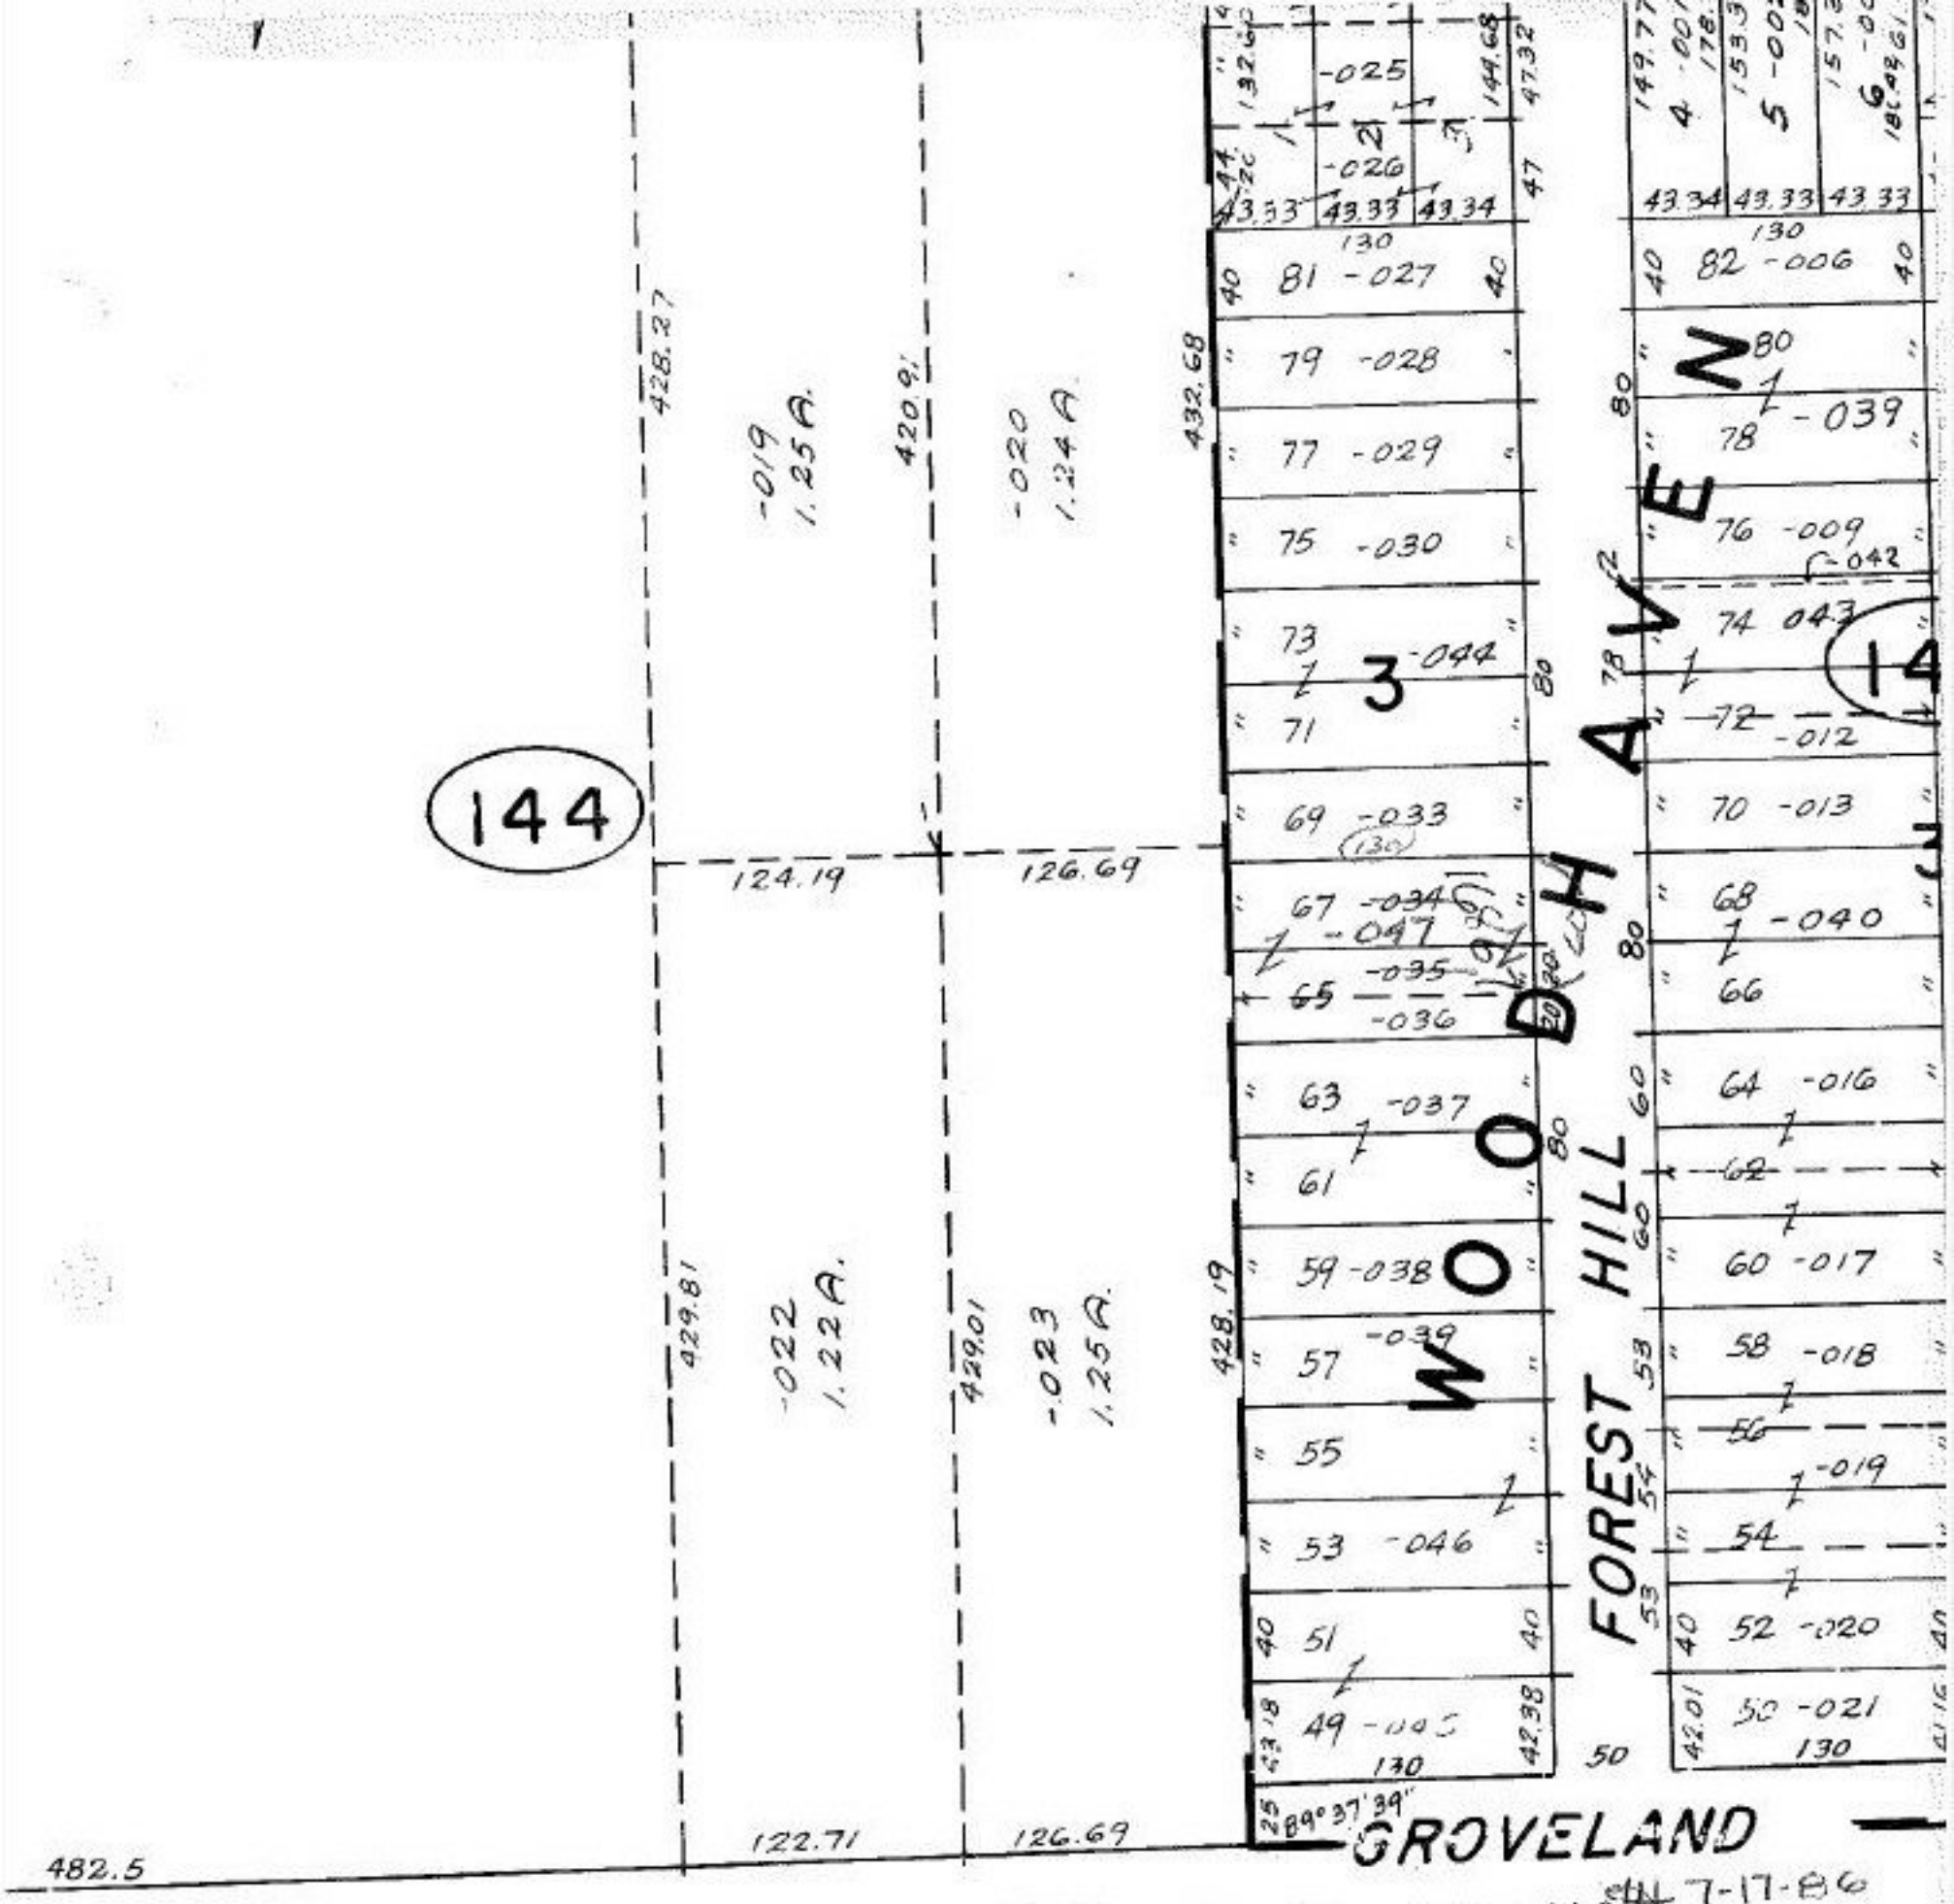

SEE 4-00-018-H 7-17-86

#16867

LAKE CITY

COMBINATION

APPROVED
LORAIN CO.
MAP DEPT.
DATE 7-15-86
PAGE 4-00-018-D
BY T. McNair
VOID AFTER

E 1/2