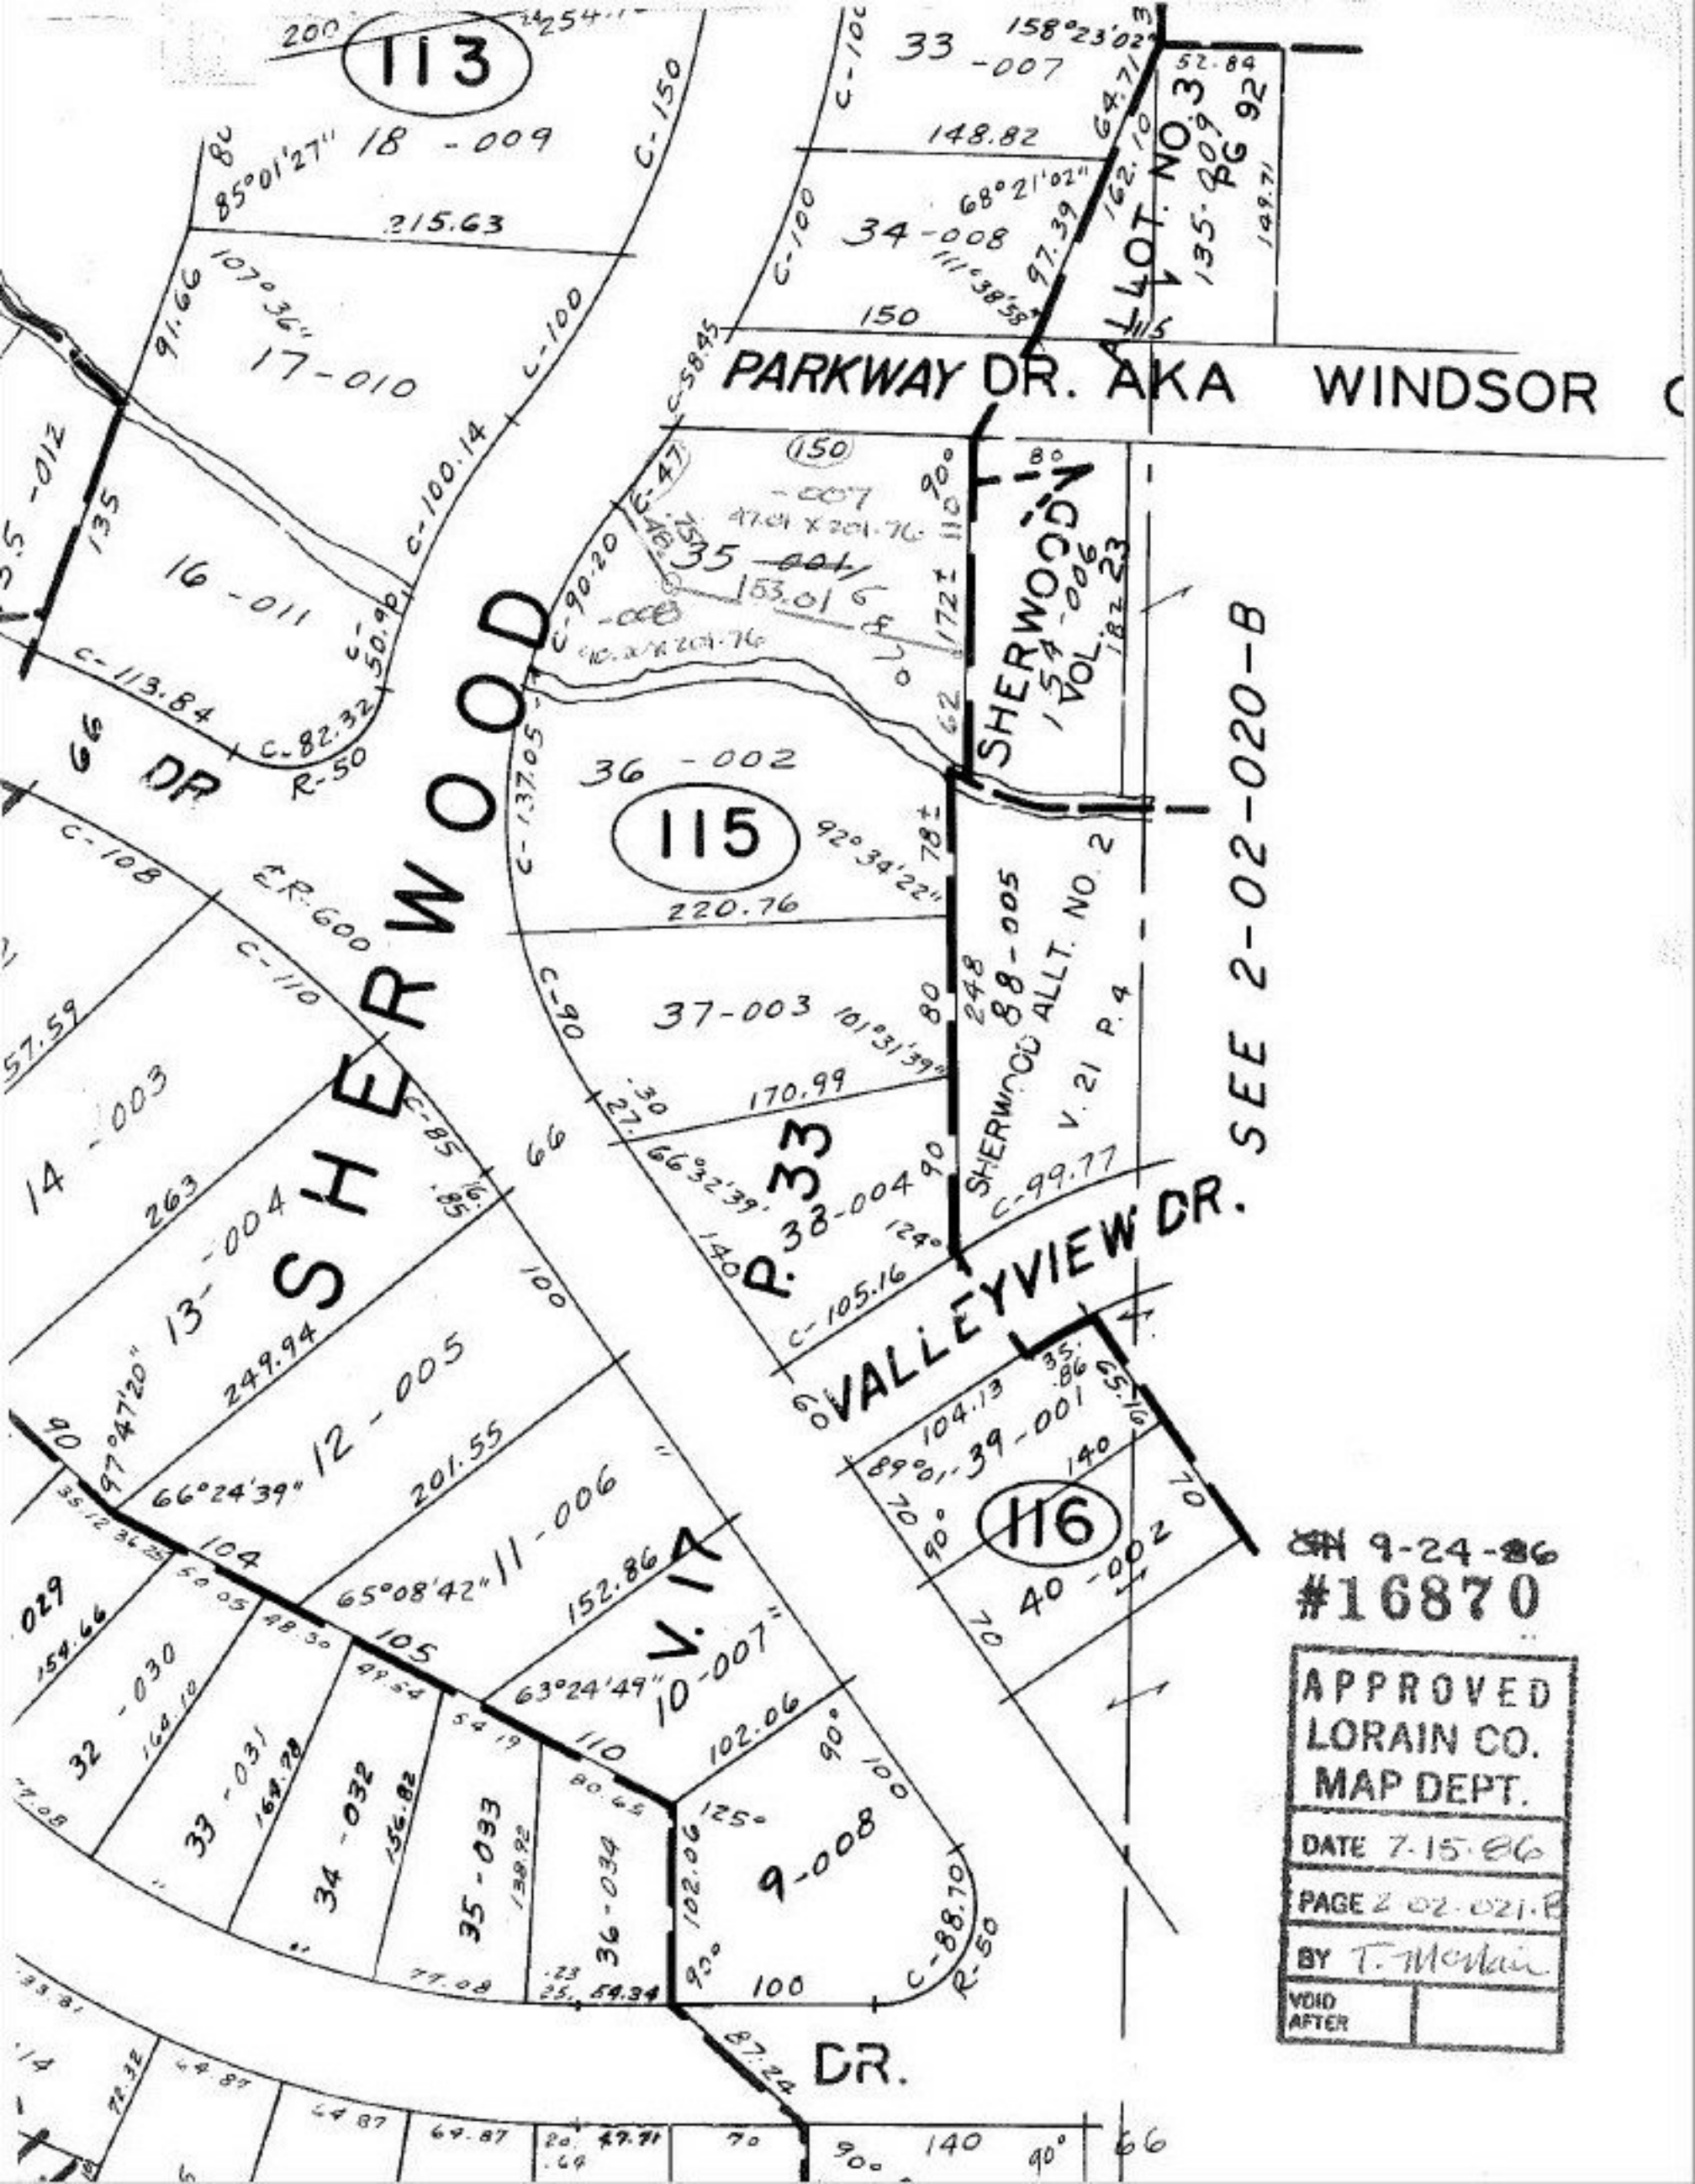

9-24-86
#16870

APPROVED
LORAIN CO.
MAP DEPT.
DATE 7-15-86
PAGE 2-02-021-B
BY T. McNair
VOID AFTER