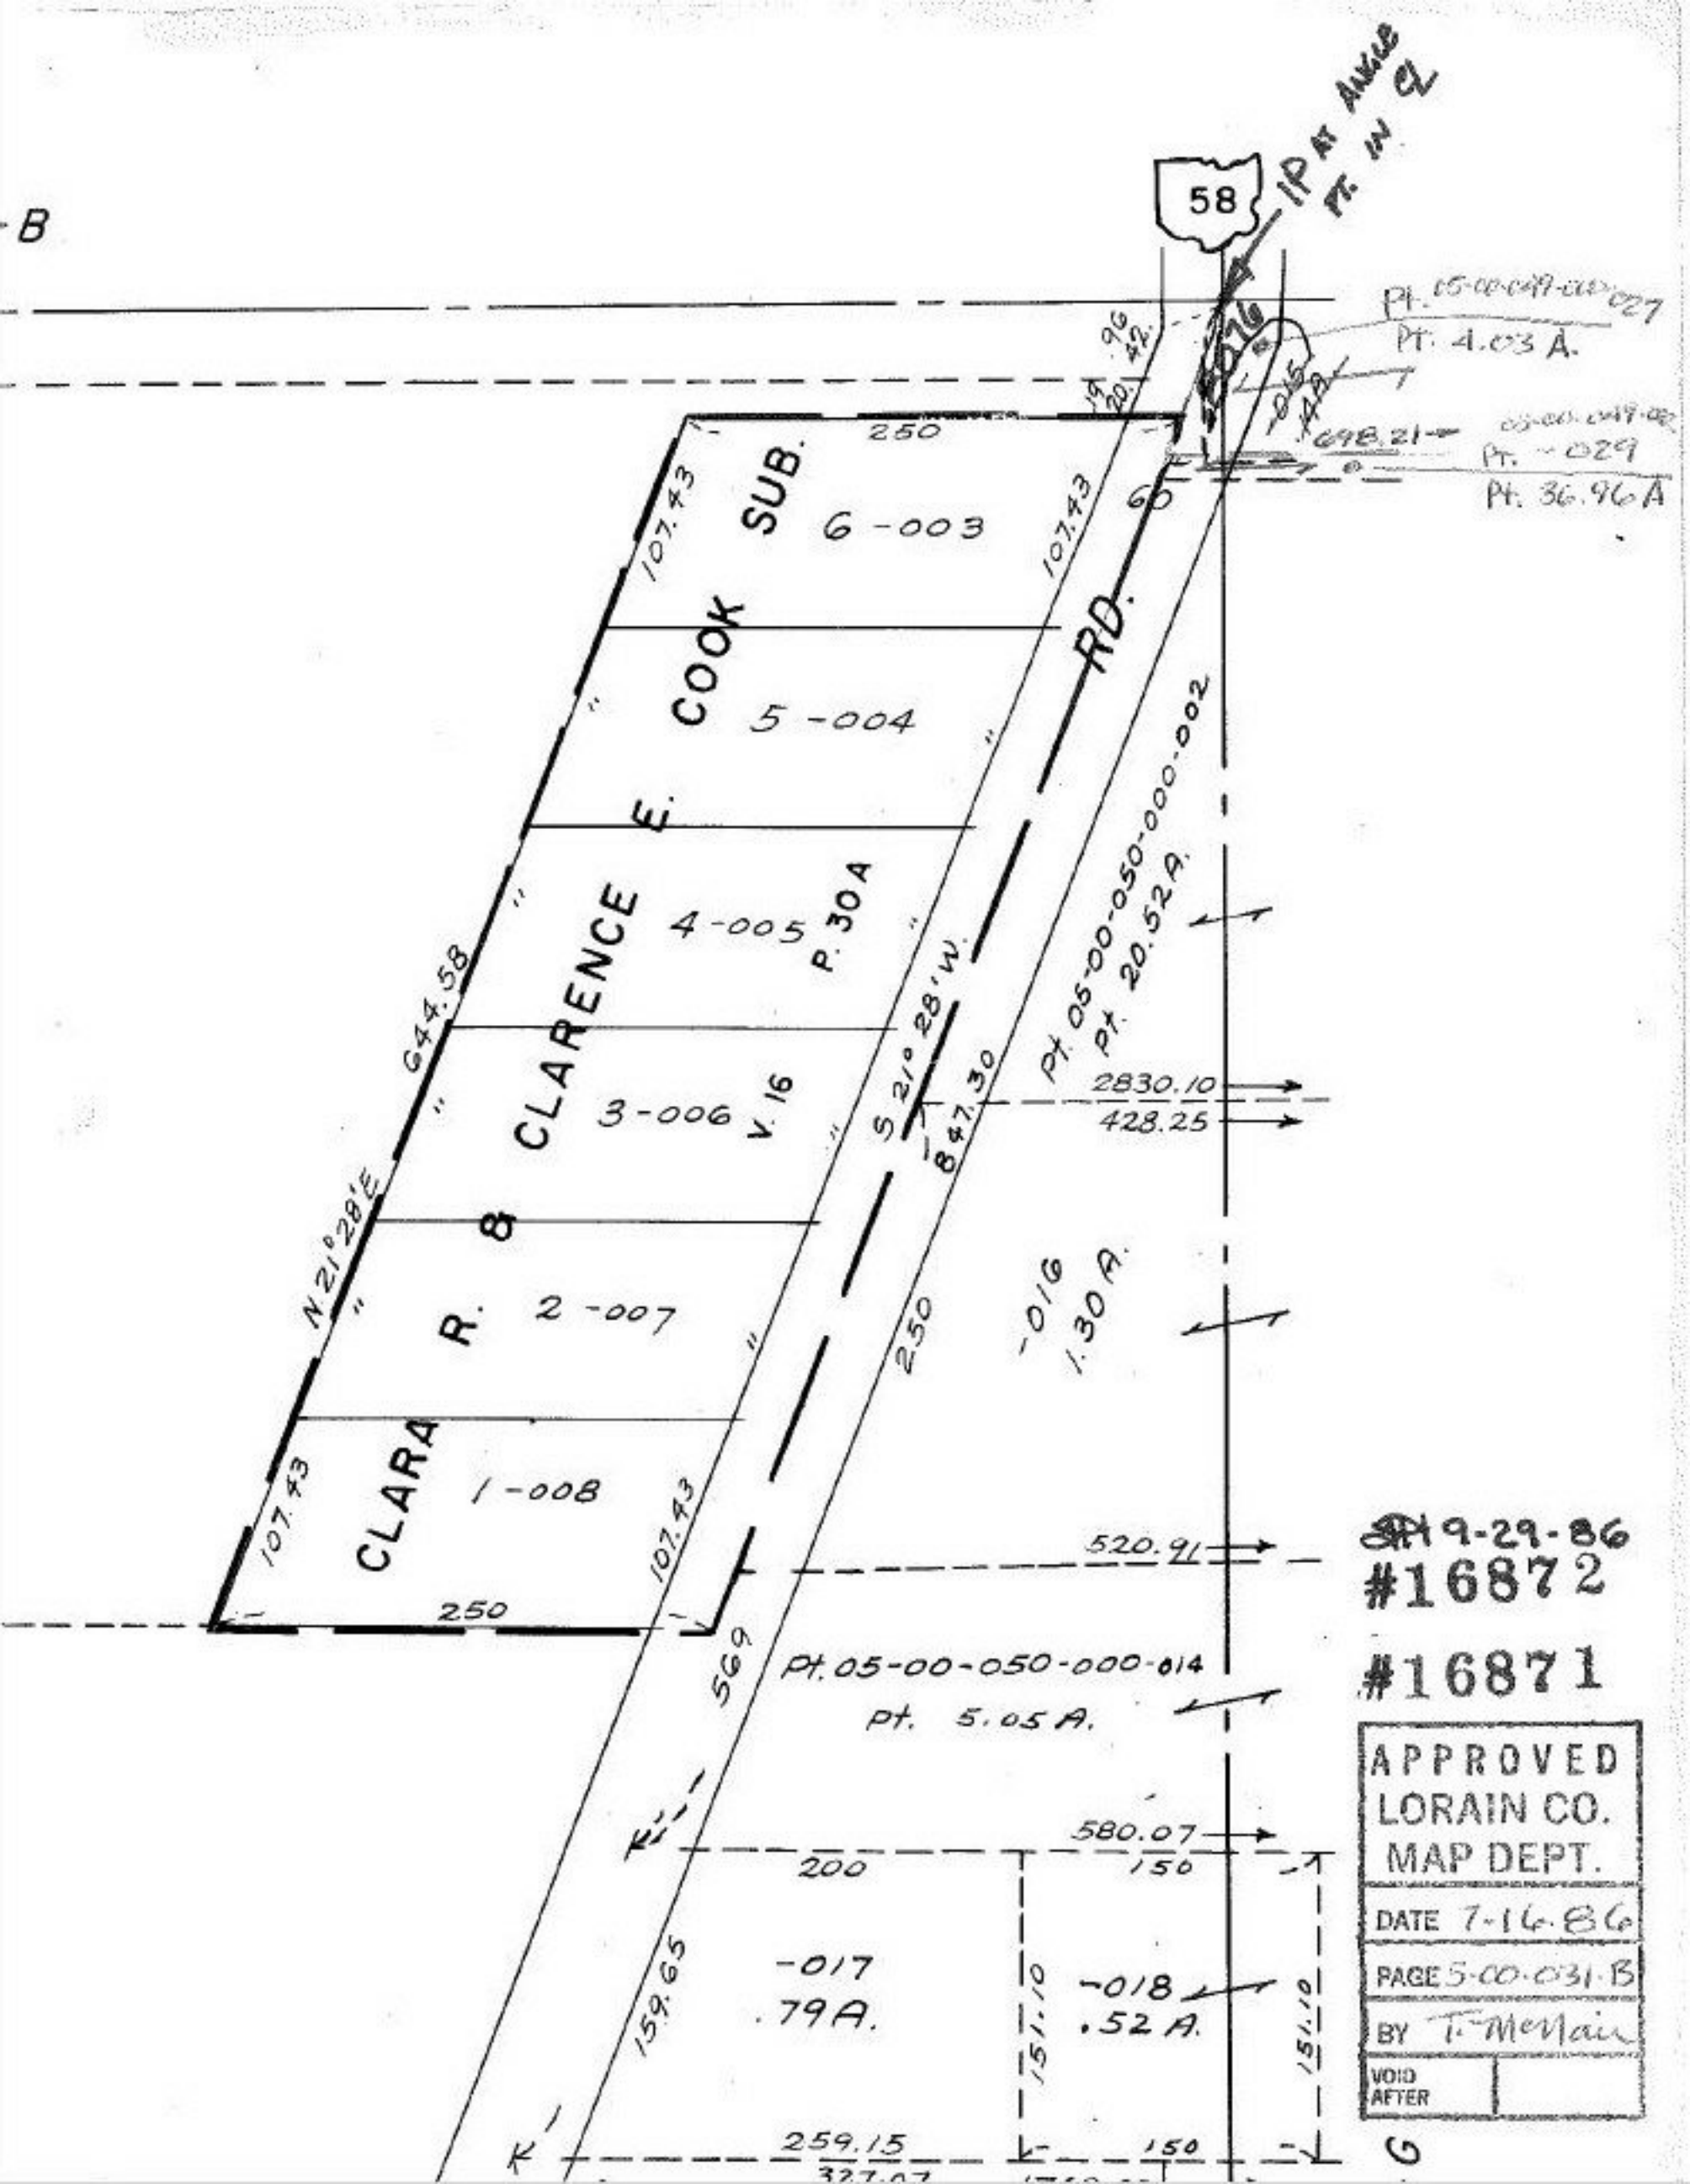

9-29-86
#16872
#16871

APPROVED
LORAIN CO.
MAP DEPT.
DATE 7-16-86
PAGE 5-00-031-B
BY T. McNair
VOID AFTER