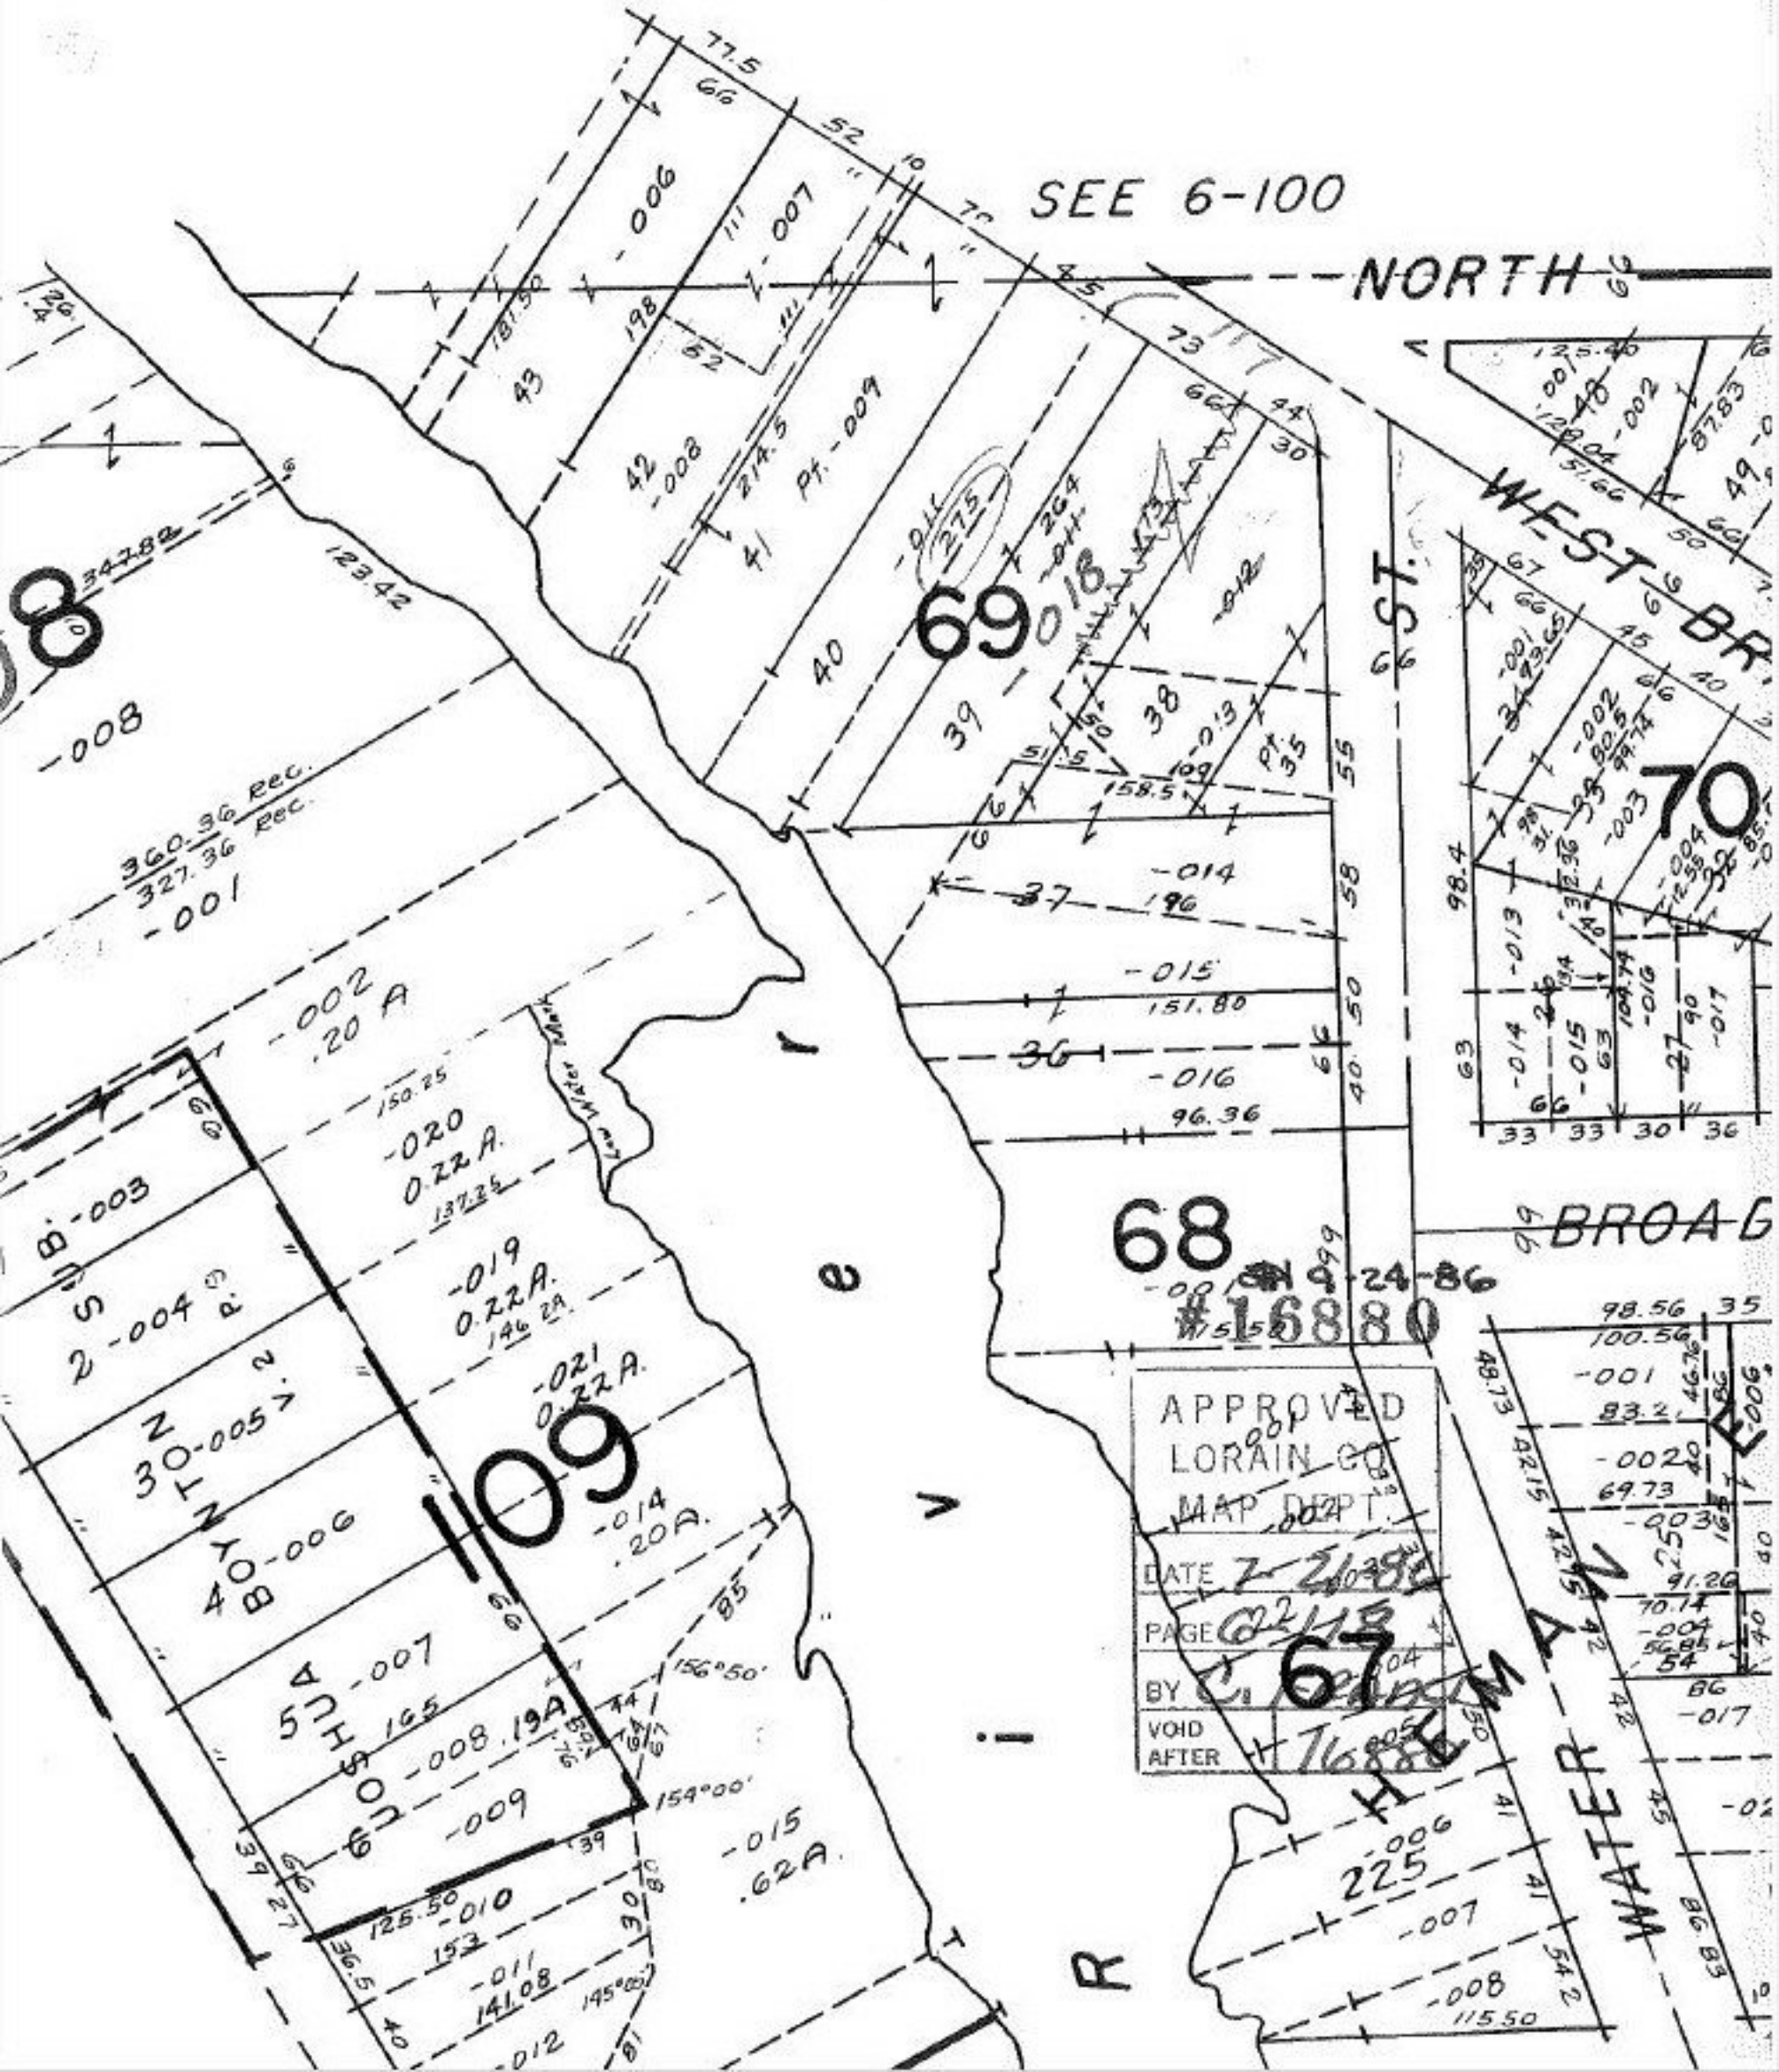
SEE 6-100
NORTH
WEST BR
ST.
BROAD
WATER
HEMAN
69
68
67
109
70
#16880
APPROVED
LORAIN CO.
MAP DEPT.
DATE
PAGE
BY
VOID
AFTER
360.36 Rec.
327.36 Rec.
Low Water Mark