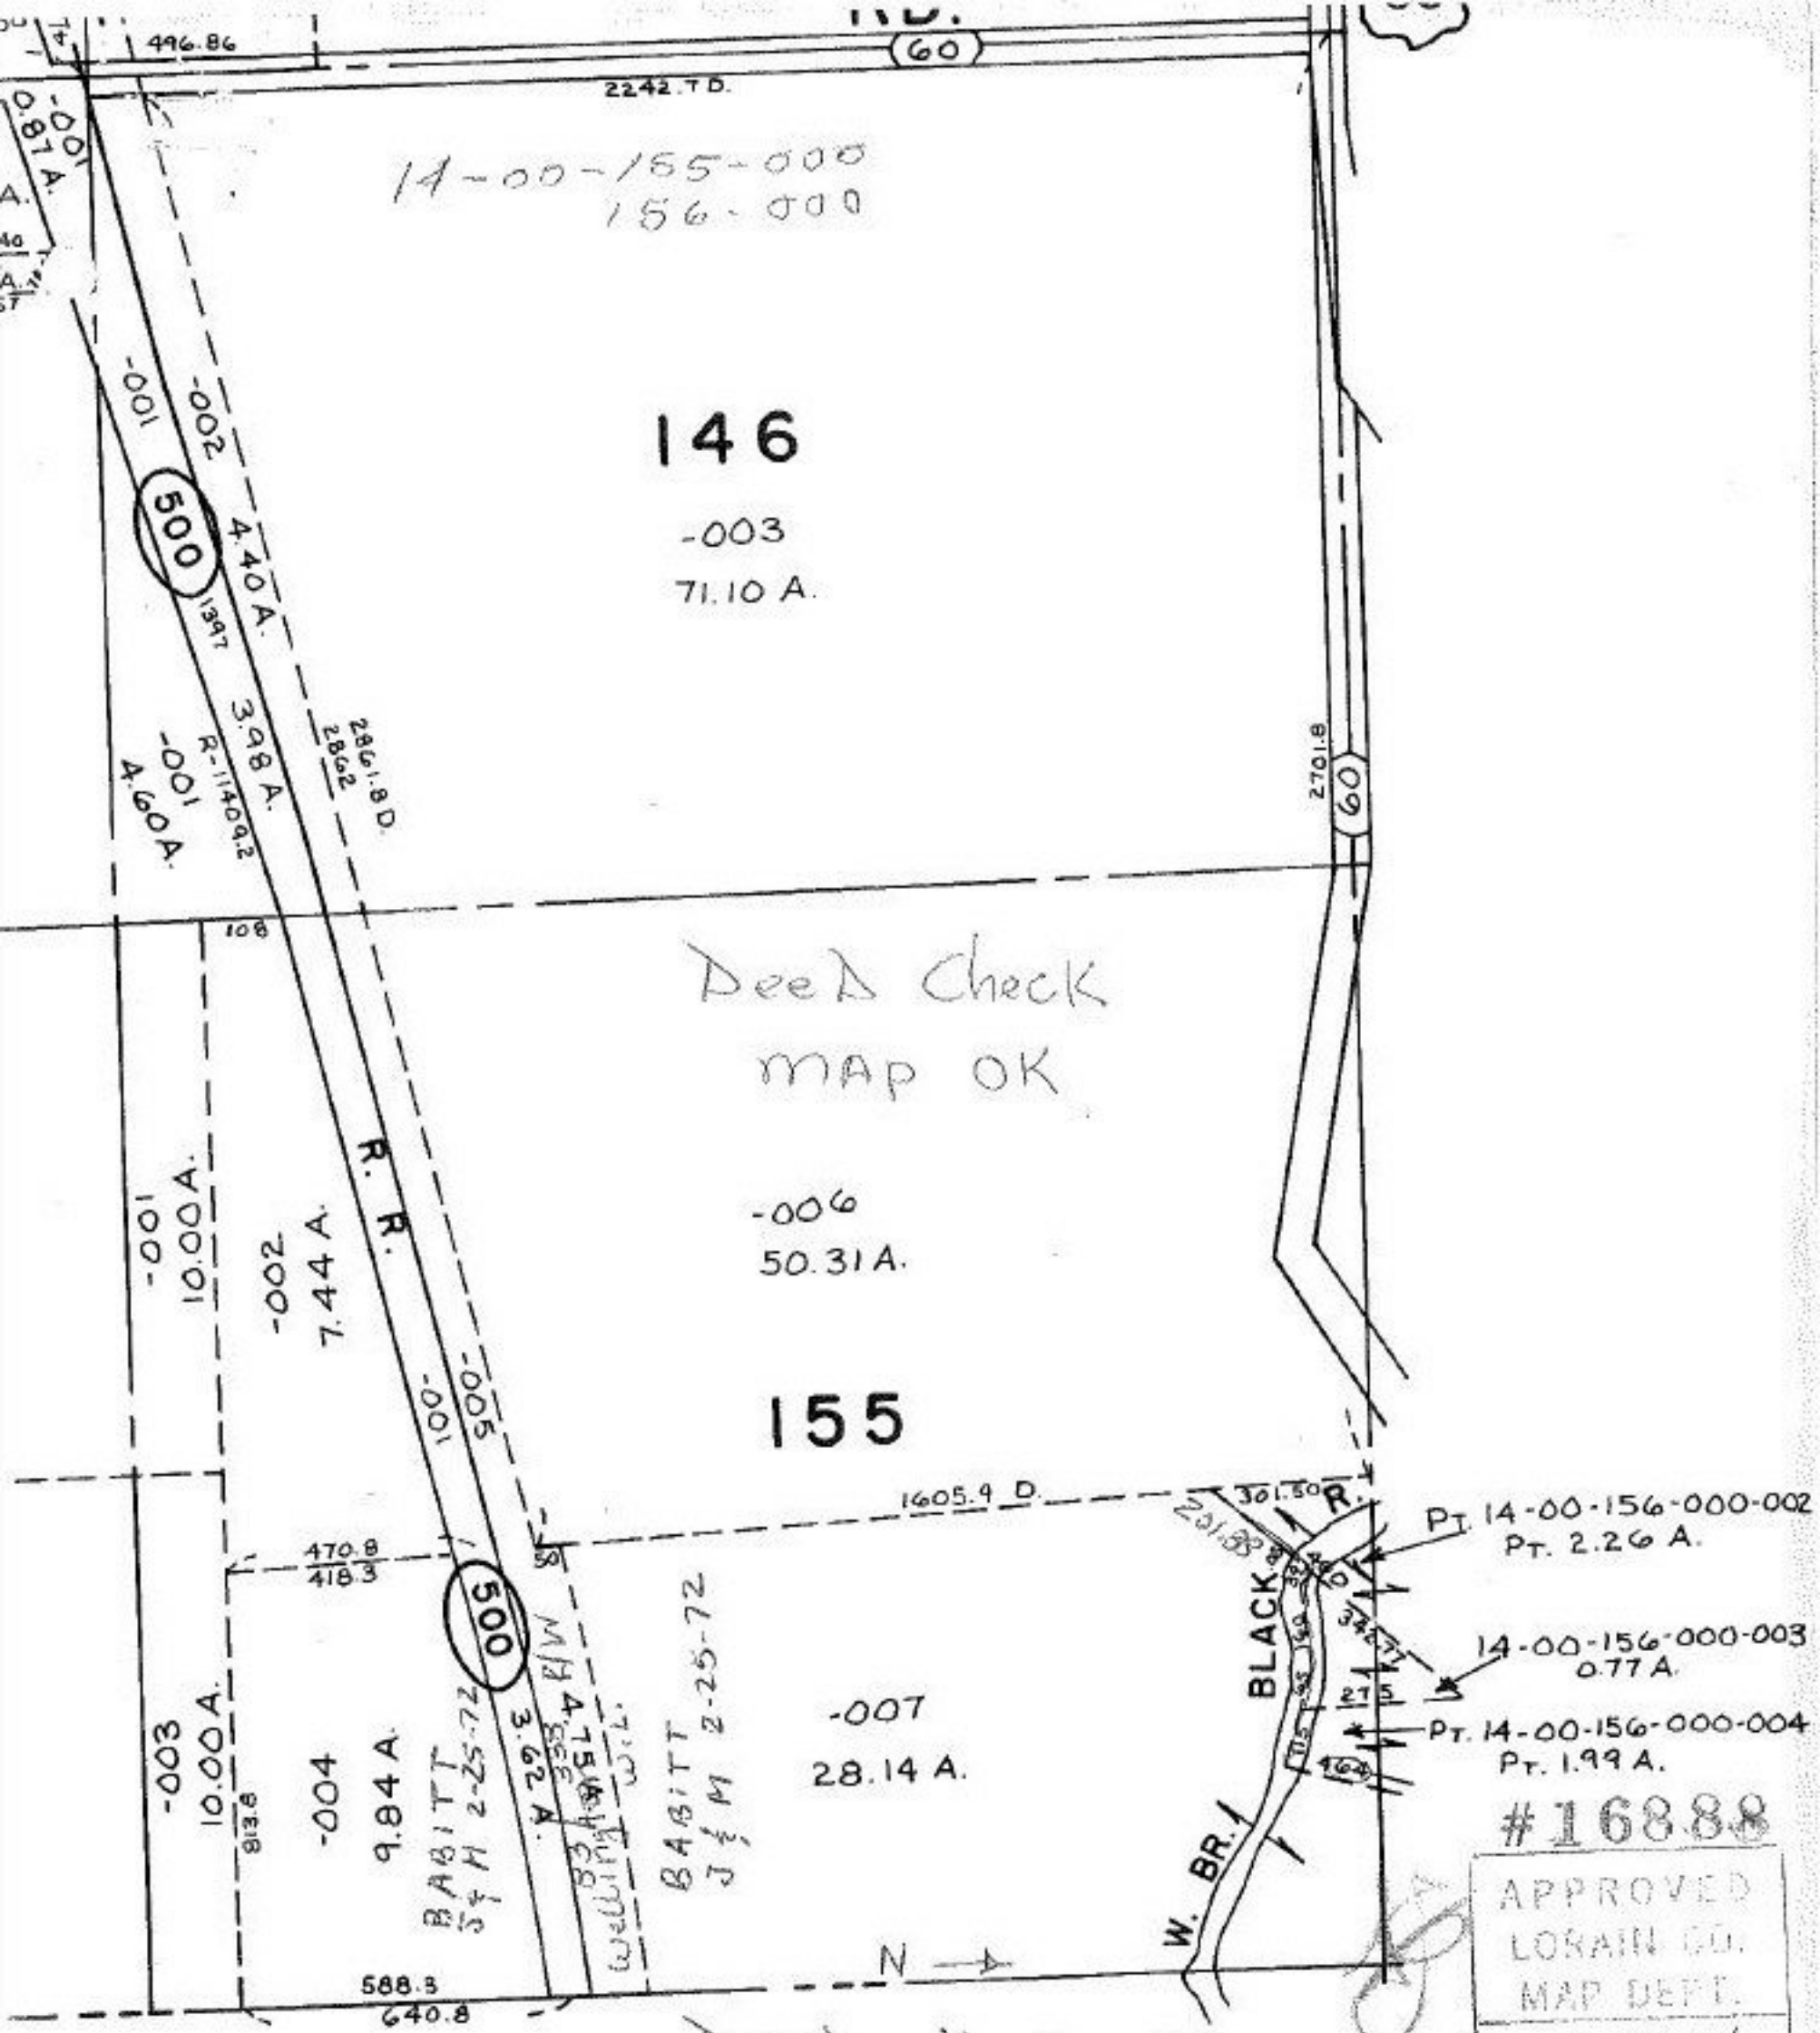

#16888

APPROVED
LORAIN CO.
MAP DEPT.
DATE 7-23-86
PAGE REVISED
BY 7-21-86 C. Francis
VOID AFTER 16888

Deed Needs To
be rewritten
Deed not clear

14-F

3

93, 94, 95, 106, 107, 108, 113, 114, 115,
4, 135, 146, 147, 148, 153, 154, 155

14-F