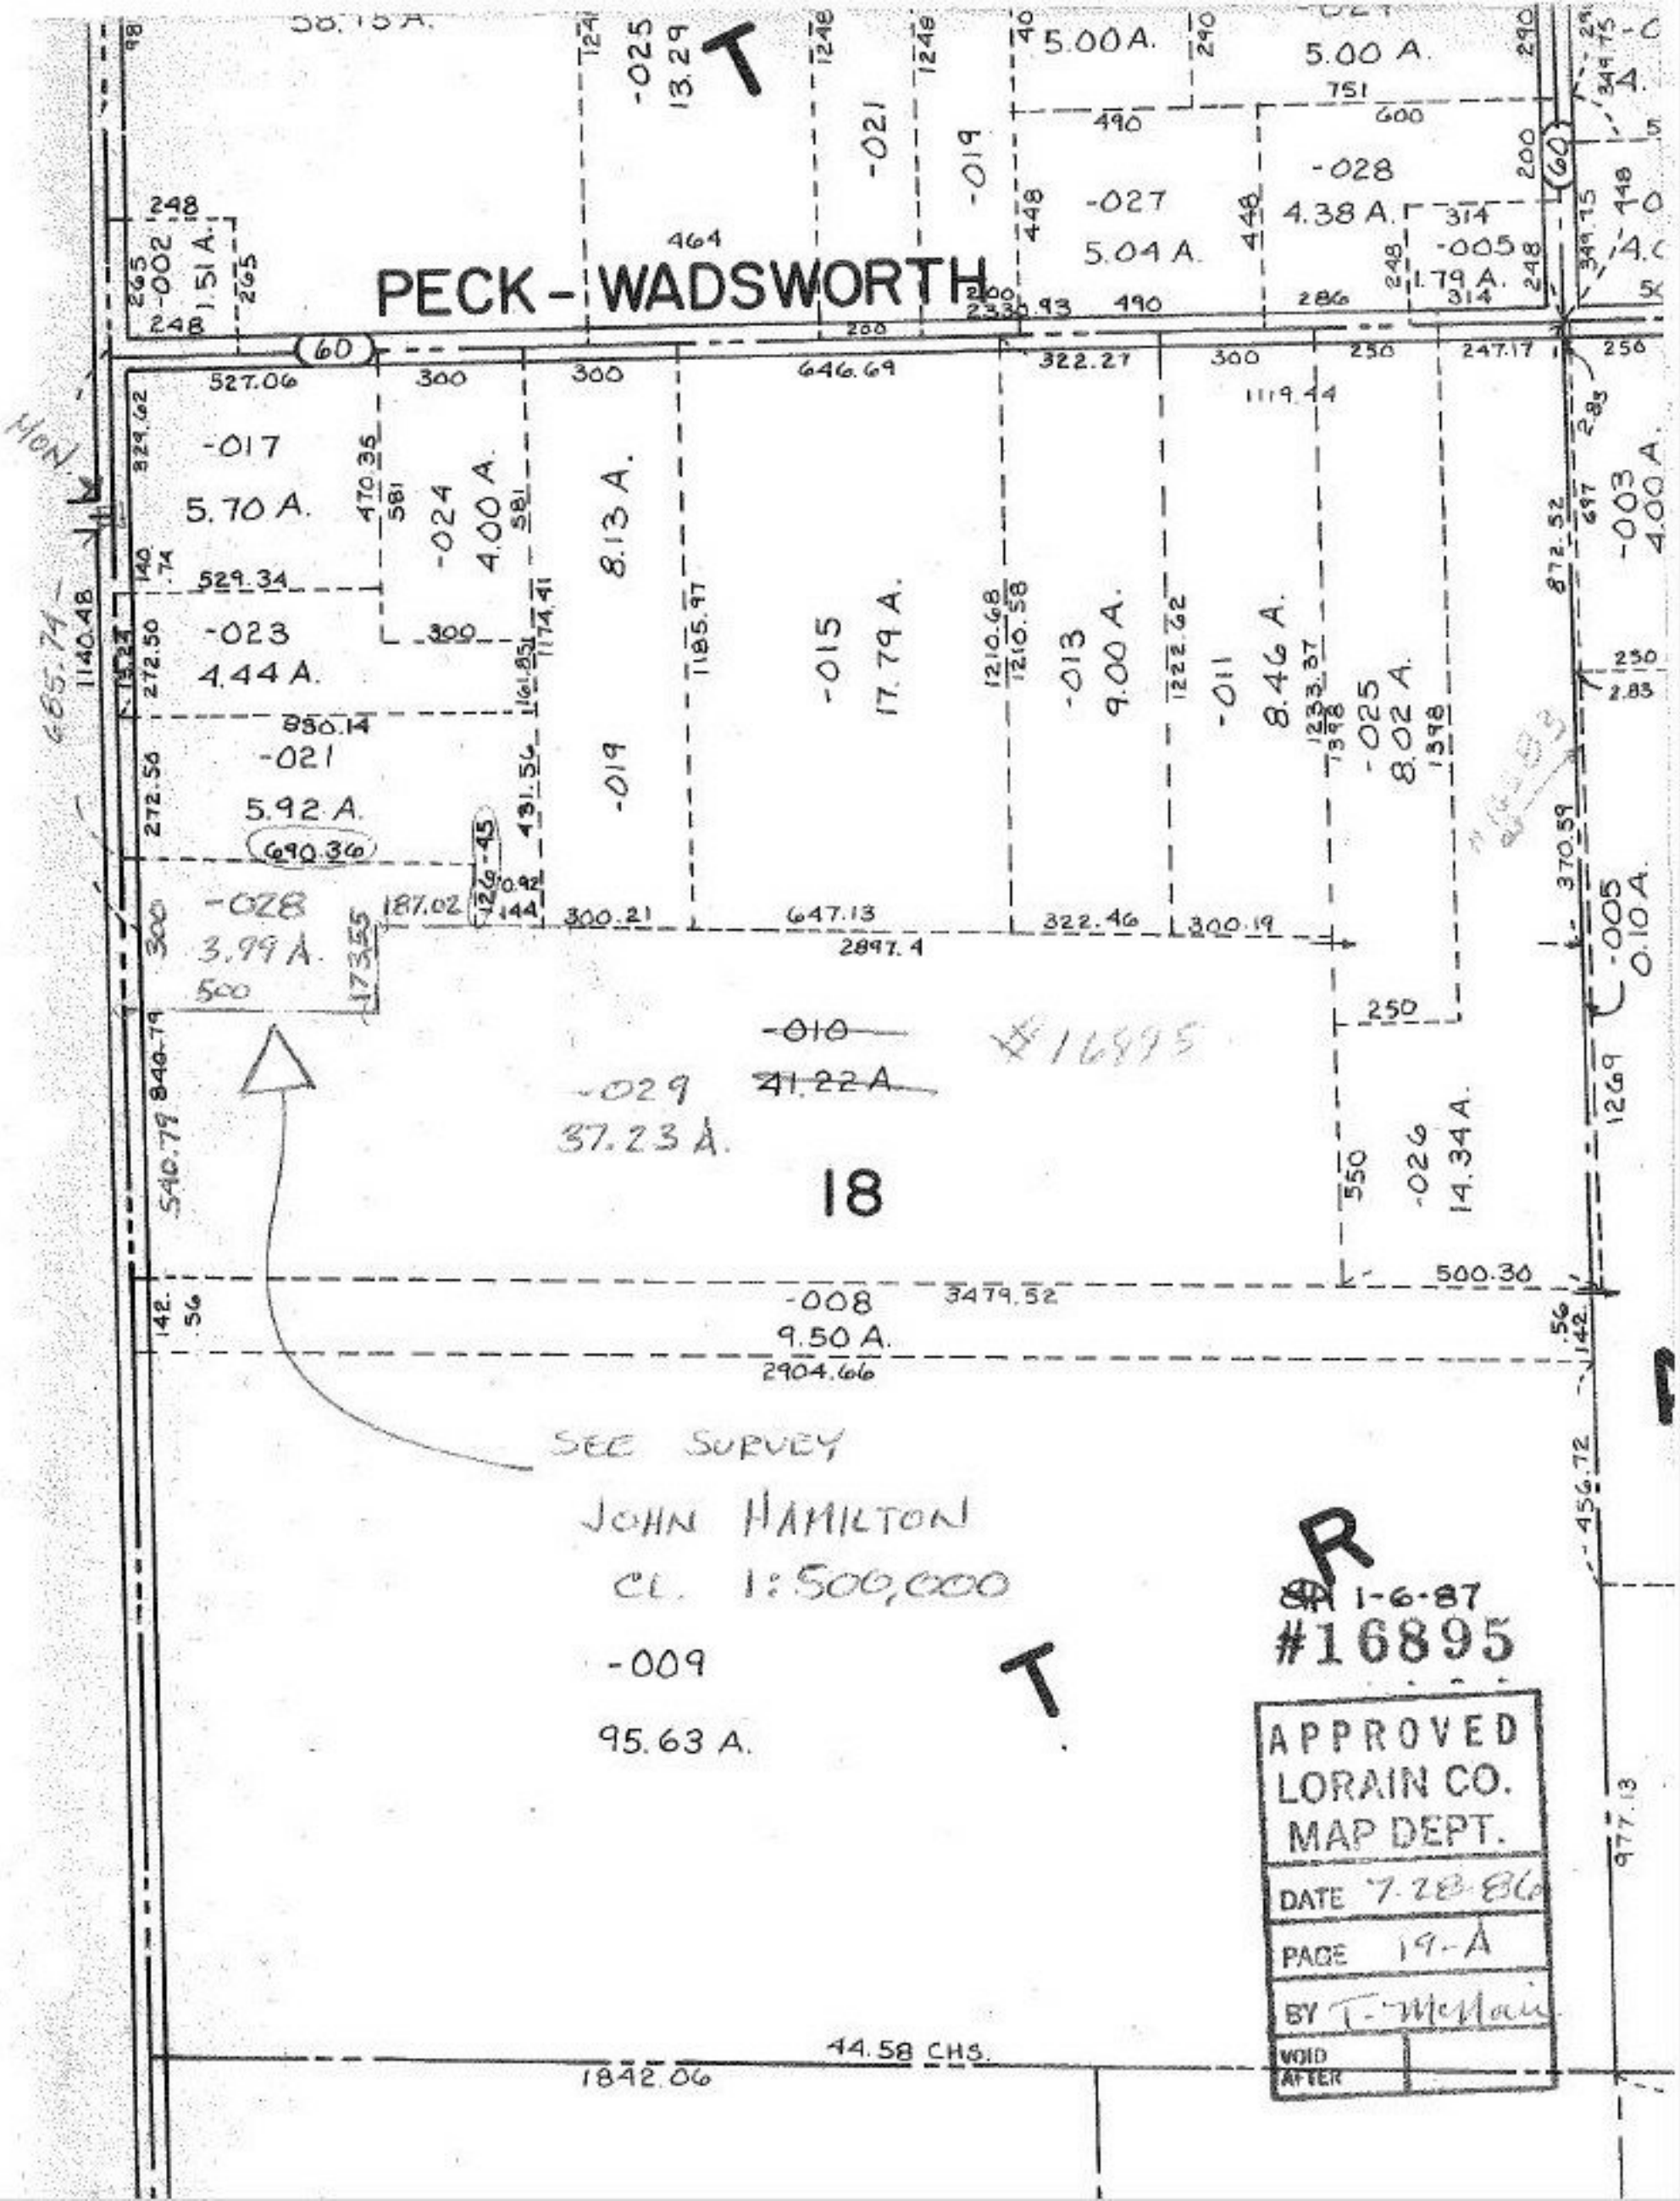
PECK - WADSWORTH
-025
13.29
-021
-019
5.00 A.
5.00 A.
-027
5.04 A.
-028
4.38 A.
-005
1.79 A.
-002
1.51 A.
-017
5.70 A.
-024
4.00 A.
8.13 A.
-015
17.79 A.
-013
9.00 A.
-011
8.46 A.
-025
8.02 A.
-003
4.00 A.
-023
4.44 A.
-021
5.92 A.
-028
3.99 A.
-019
-010
41.22 A.
-029
37.23 A.
18
-026
14.34 A.
-005
0.10 A.
-008
9.50 A.
-009
95.63 A.
SEE SURVEY
JOHN HAMILTON
CL. 1:500,000
#16895
1-6-87
#16895
APPROVED
LORAIN CO.
MAP DEPT.
DATE 7-28-86
PAGE 19-A
BY T. McNair
VOID
AFTER
44.58 CHS.
1842.06
MON.
685.74
540.79
1140.48
2904.66
3479.52
500.30
977.13
456.72
1269
370.59
872.52
1119.44
646.69
322.27
527.06
529.34
830.14
690.36
187.02
300.21
647.13
322.46
300.19
2897.4
2330.93
1185.97
1174.41
1210.68
1210.58
1222.62
1233.37
1398
1174.41
1161.85
431.56
1140.48
272.50
272.56
300
500
550
250
200
490
286
314
751
600
464
248
265
300
250
247.17
1269
2.83
1.74
1.45
0.92
144
173.55
142.56
142.56