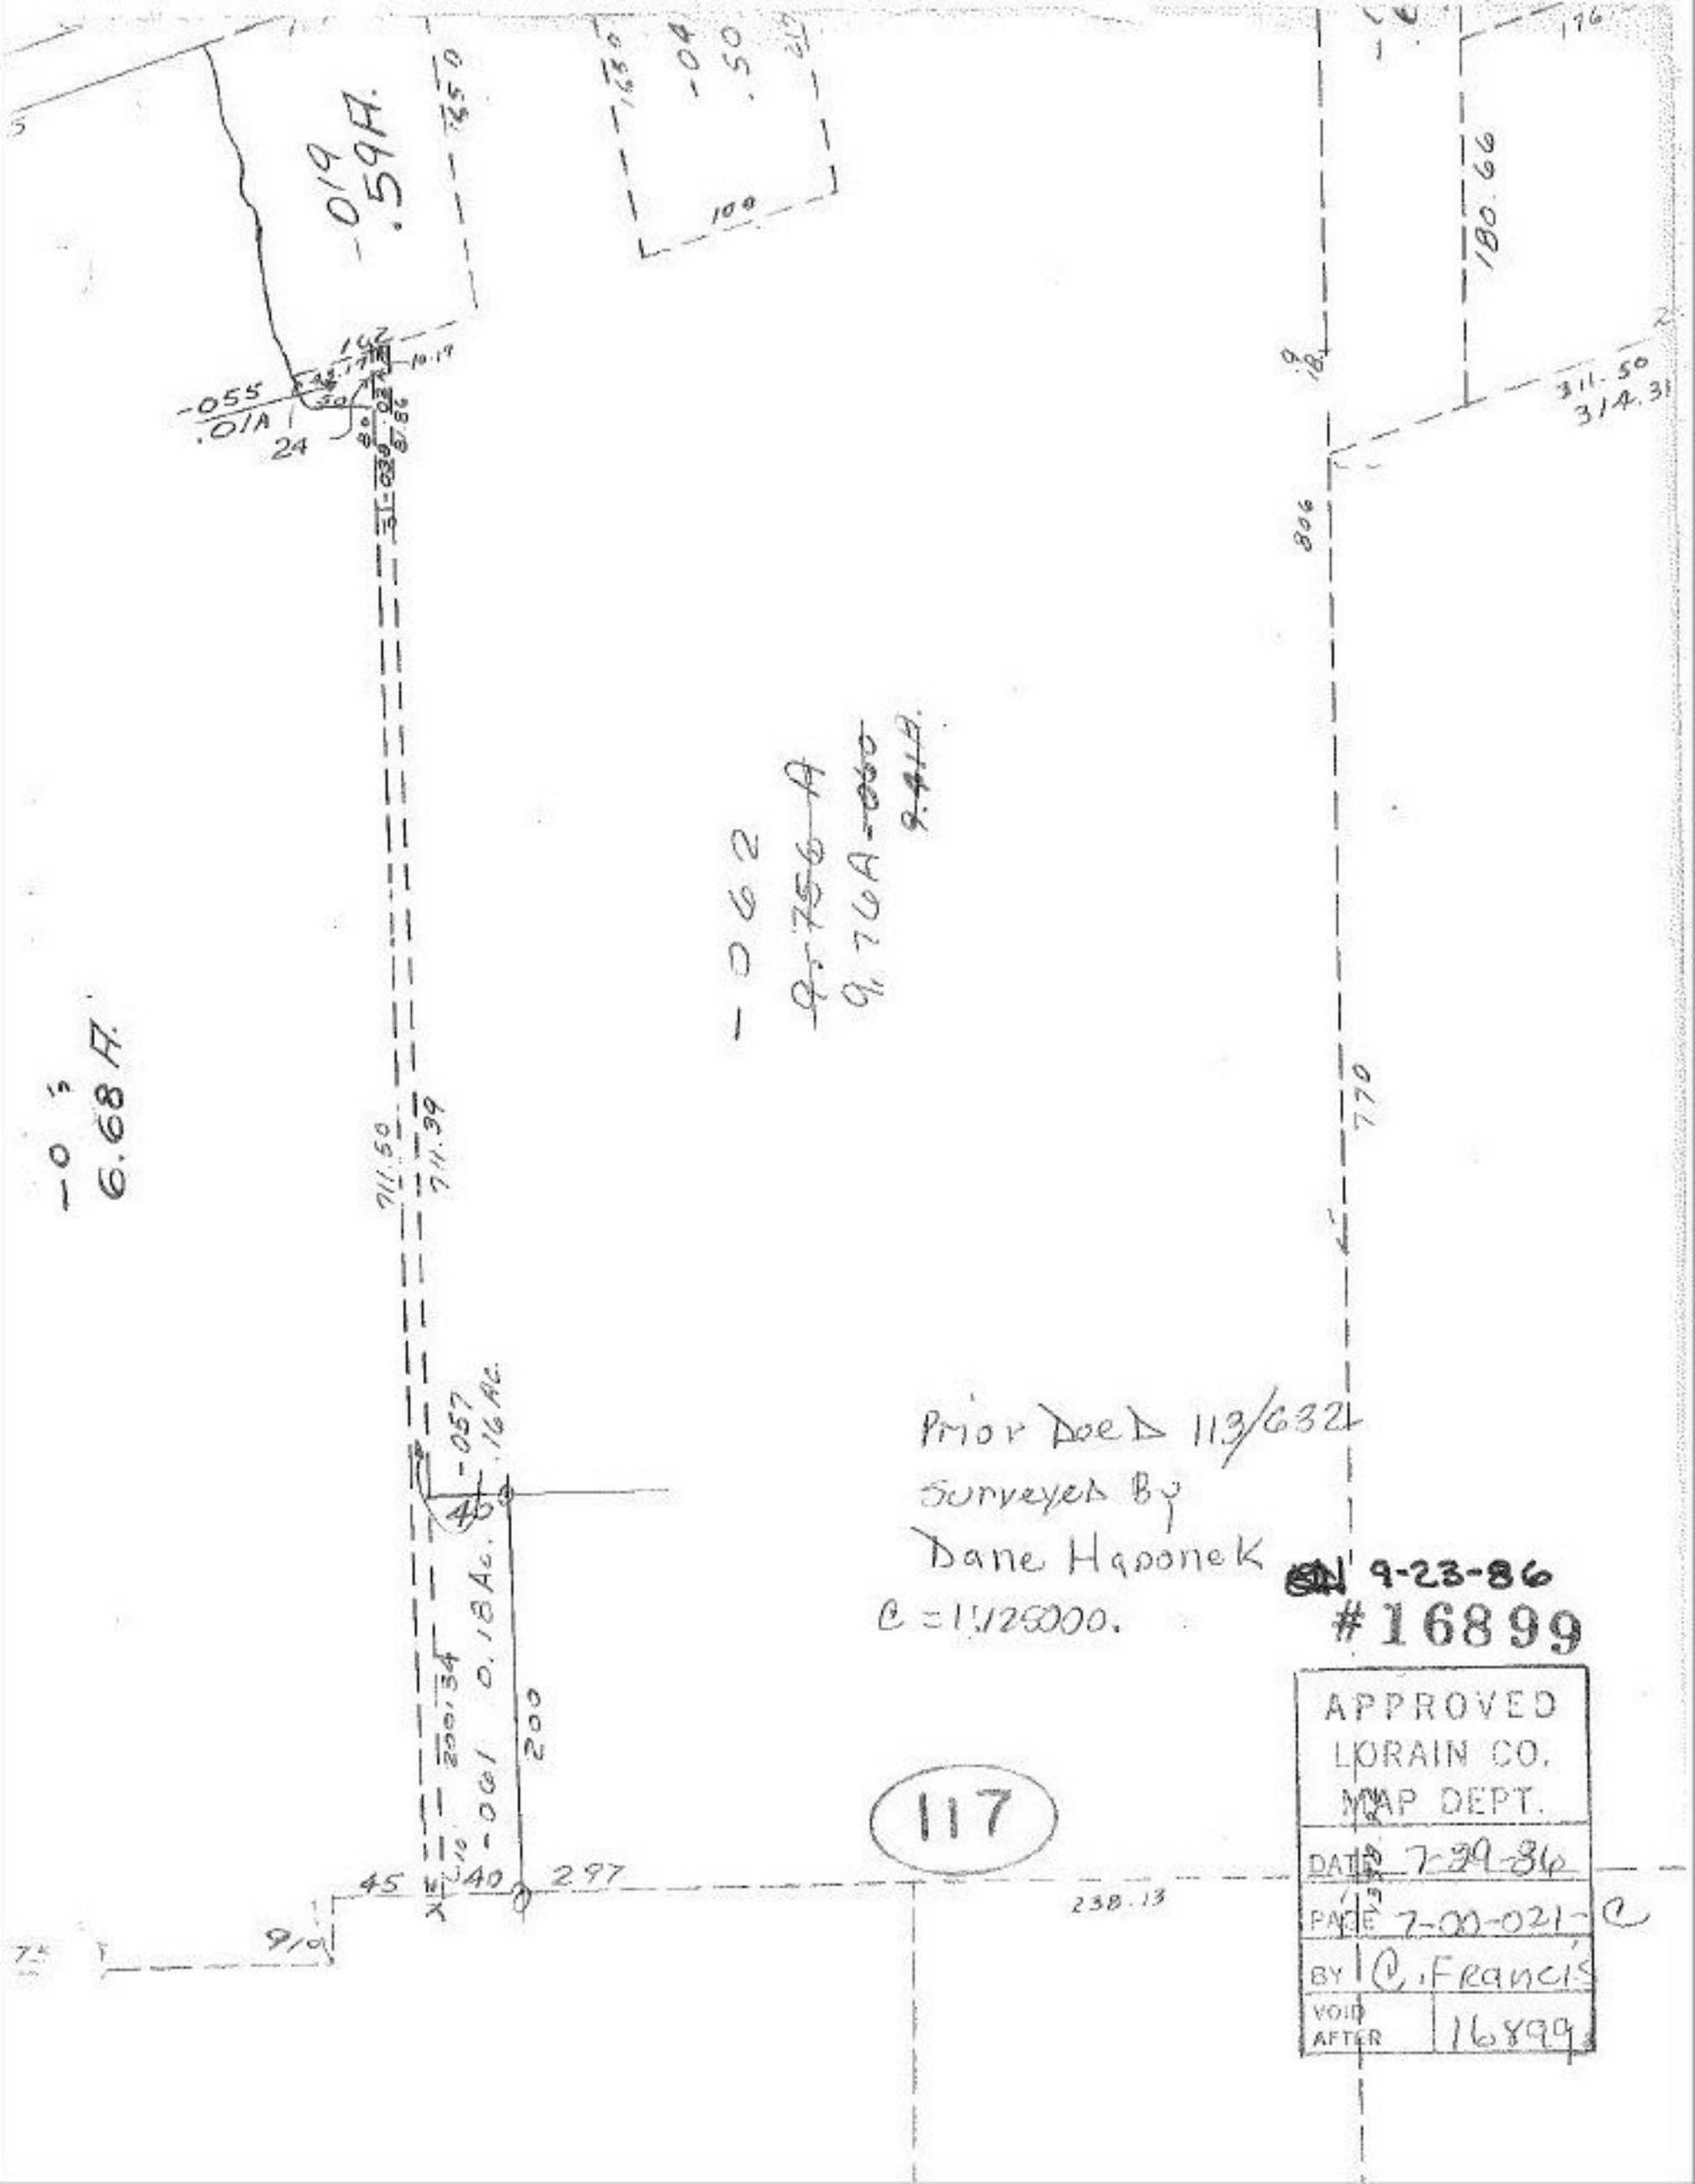

-019
.59A.
-055
.01A
24
-062
9.76A
-0
6.68 A.
711.50
711.39
-057
.16 Ac.
40
0.18 Ac.
200.34
-061
200
45
40
297
238.13
910
180.66
311.50
314.31
806
770
Prior Deed 113/632
Surveyed By
Dane Hapanek
C = 1:125000.
9-23-86
#16899
APPROVED
LORAIN CO.
MAP DEPT.
DATE 7-29-86
PAGE 7-00-021-C
BY C. Francis
VOID AFTER 16899
117