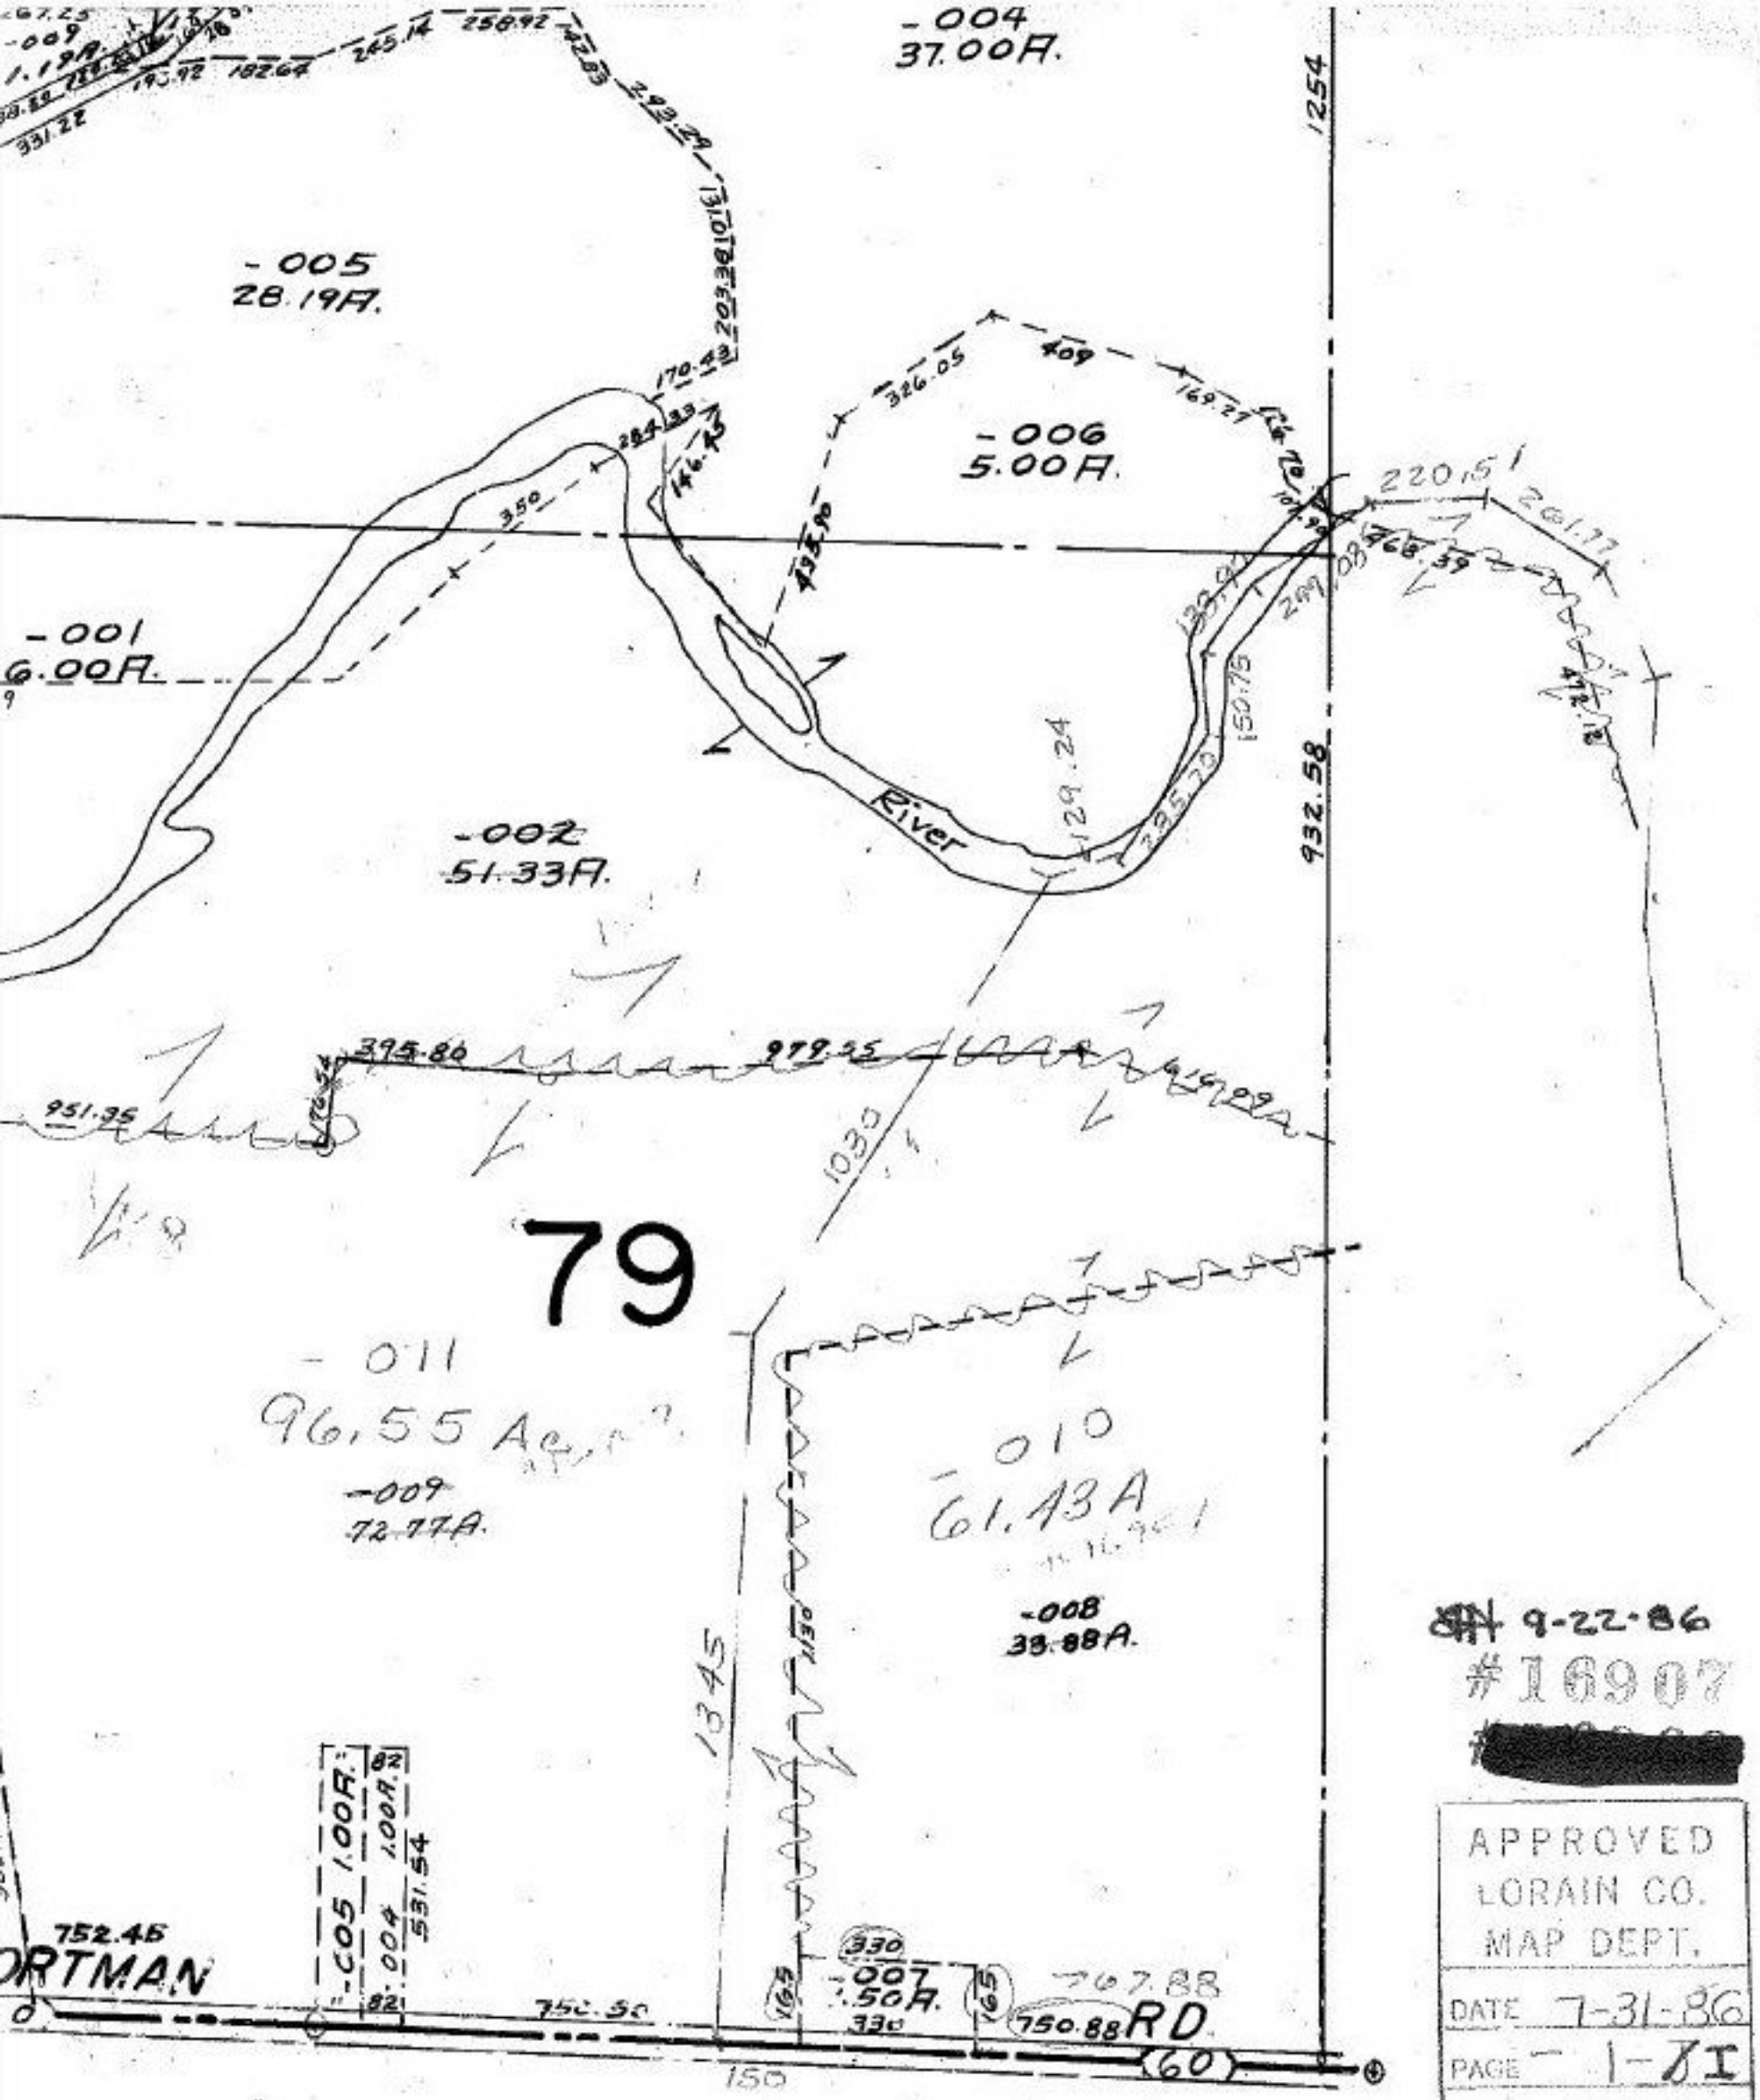

9-22-86
#16907
[redacted]

APPROVED
LORAIN CO.
MAP DEPT.

DATE 7-31-86
PAGE 1-8I
