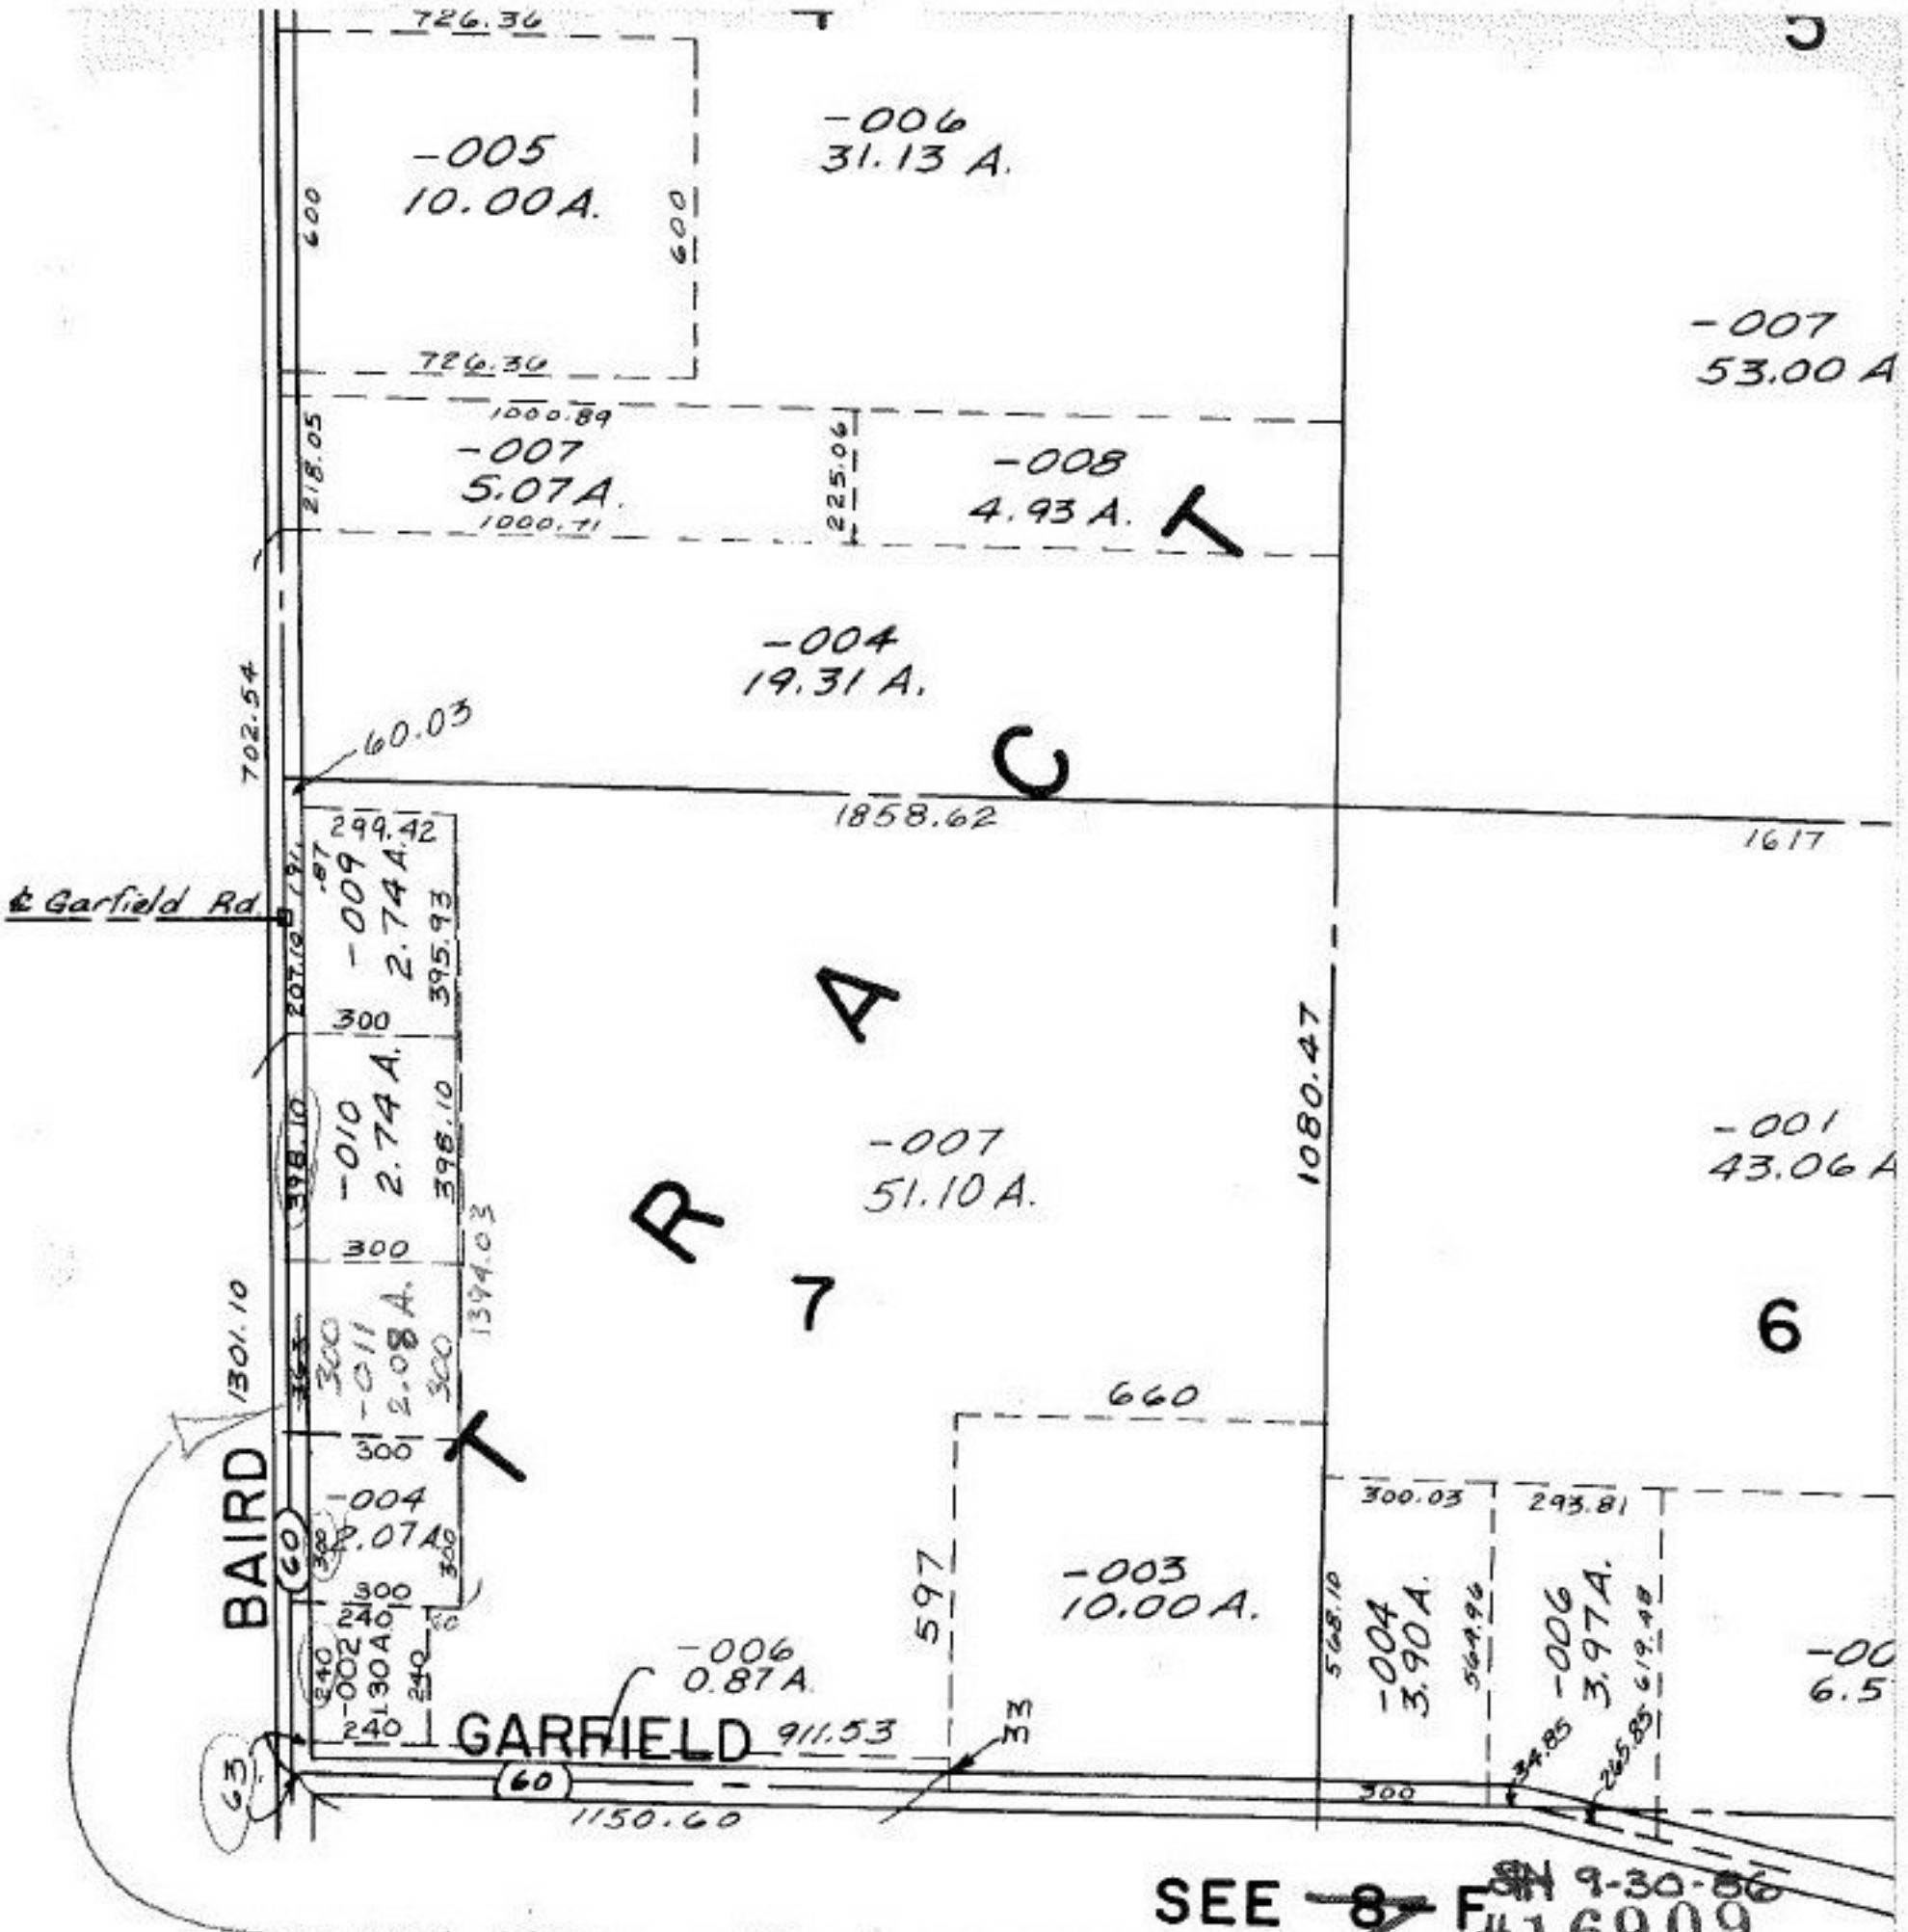

SEE 8-F

SN 9-30-86

#16909

THIS PARCEL WAS THE REMAINDER OF SPLIT # 15348 FILED 11-4-83 WHICH WAS NEVER DRAWN ON TAX MAPS. PARCEL EXISTS ON DUPLICATE & IN REGISTER

MAP CORRECTION

APPROVED
LORAIN CO.
MAP DEPT.
DATE 7-30-86
PAGE 8-B
BY T. McNair
VOID AFTER