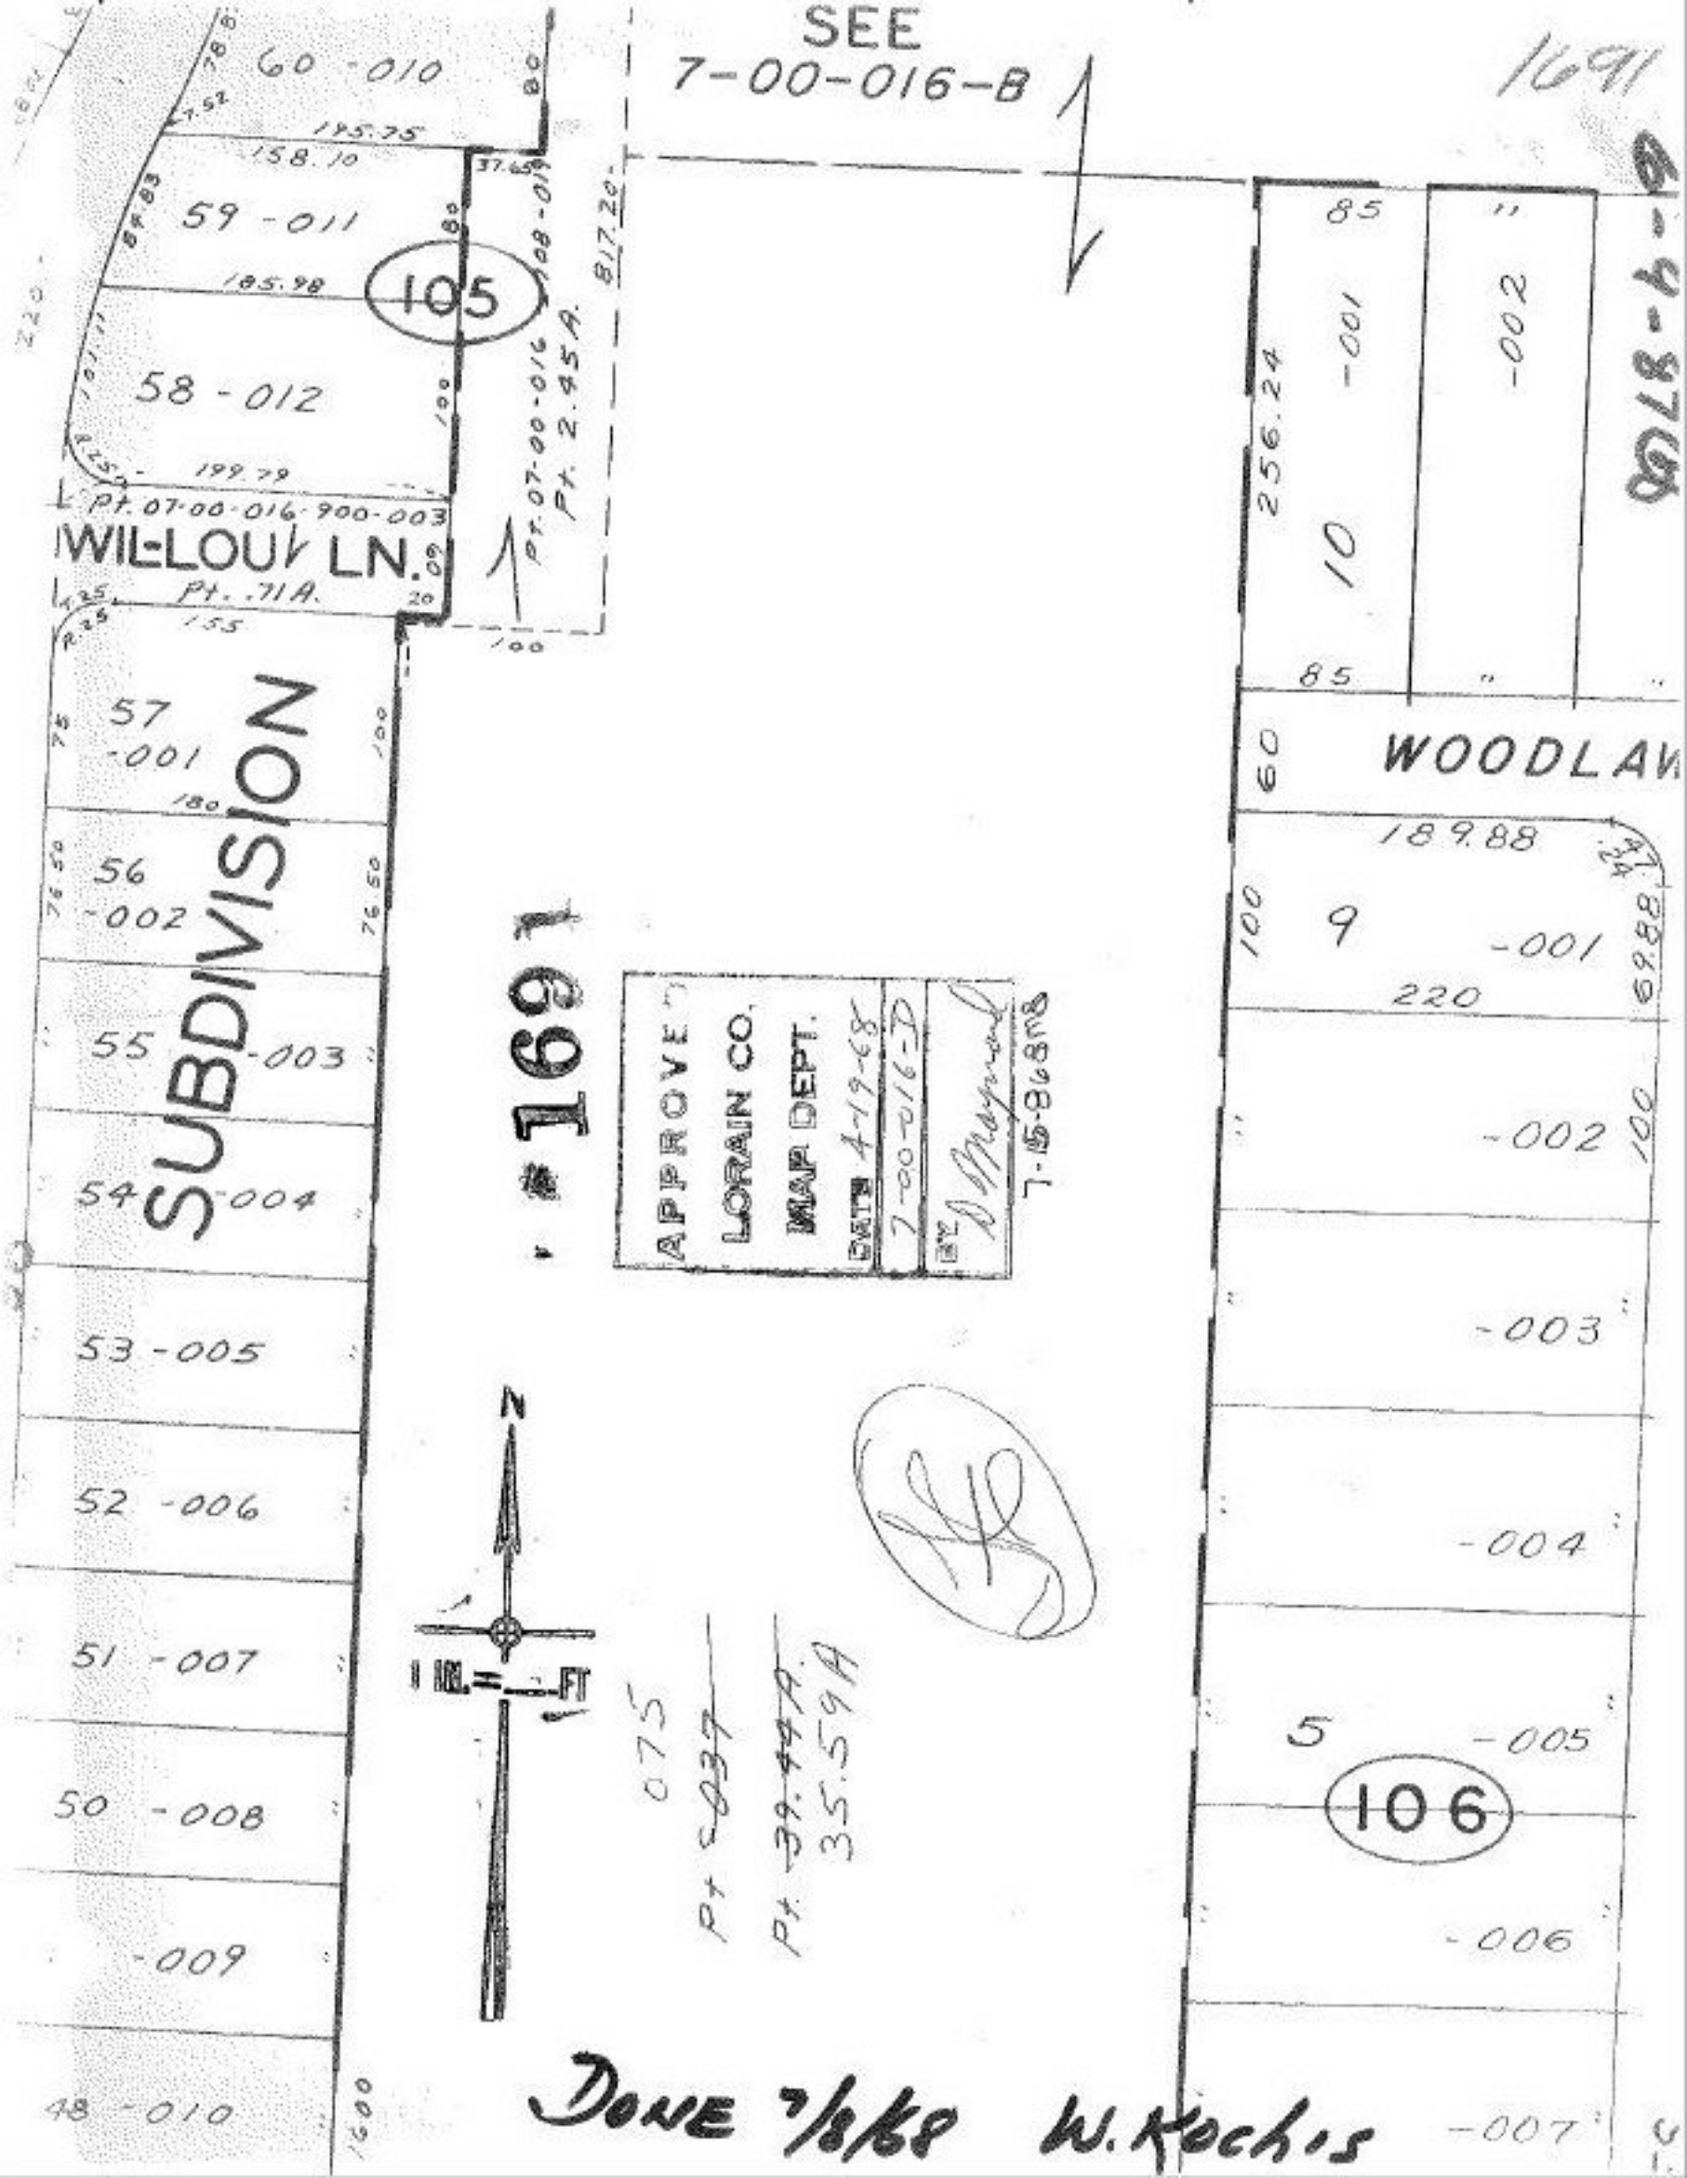
SEE
7-00-016-B
1691
60 -010
59 -011
105
58 -012
Pt. 07-00-016-900-003
WIL-LOU LN.
Pt. .71A.
SUBDIVISION
57 -001
56 -002
55 -003
54 -004
53 -005
52 -006
51 -007
50 -008
-009
48 -010
Pt. 07-00-016 Pt. 2.45A.
817.20
108-010
85
-001
-002
256.24
10
WOODLAW
189.88
9
-001
220
-002
-003
-004
5
-005
106
-006
-007
APPROVED
LORAIN CO.
MAP DEPT.
DATE 4-19-68
BY
1 IN. = 1 FT
N
#1691
075
Pt. 39.44A
35.59A
DONE 7/8/68 W. Kochis