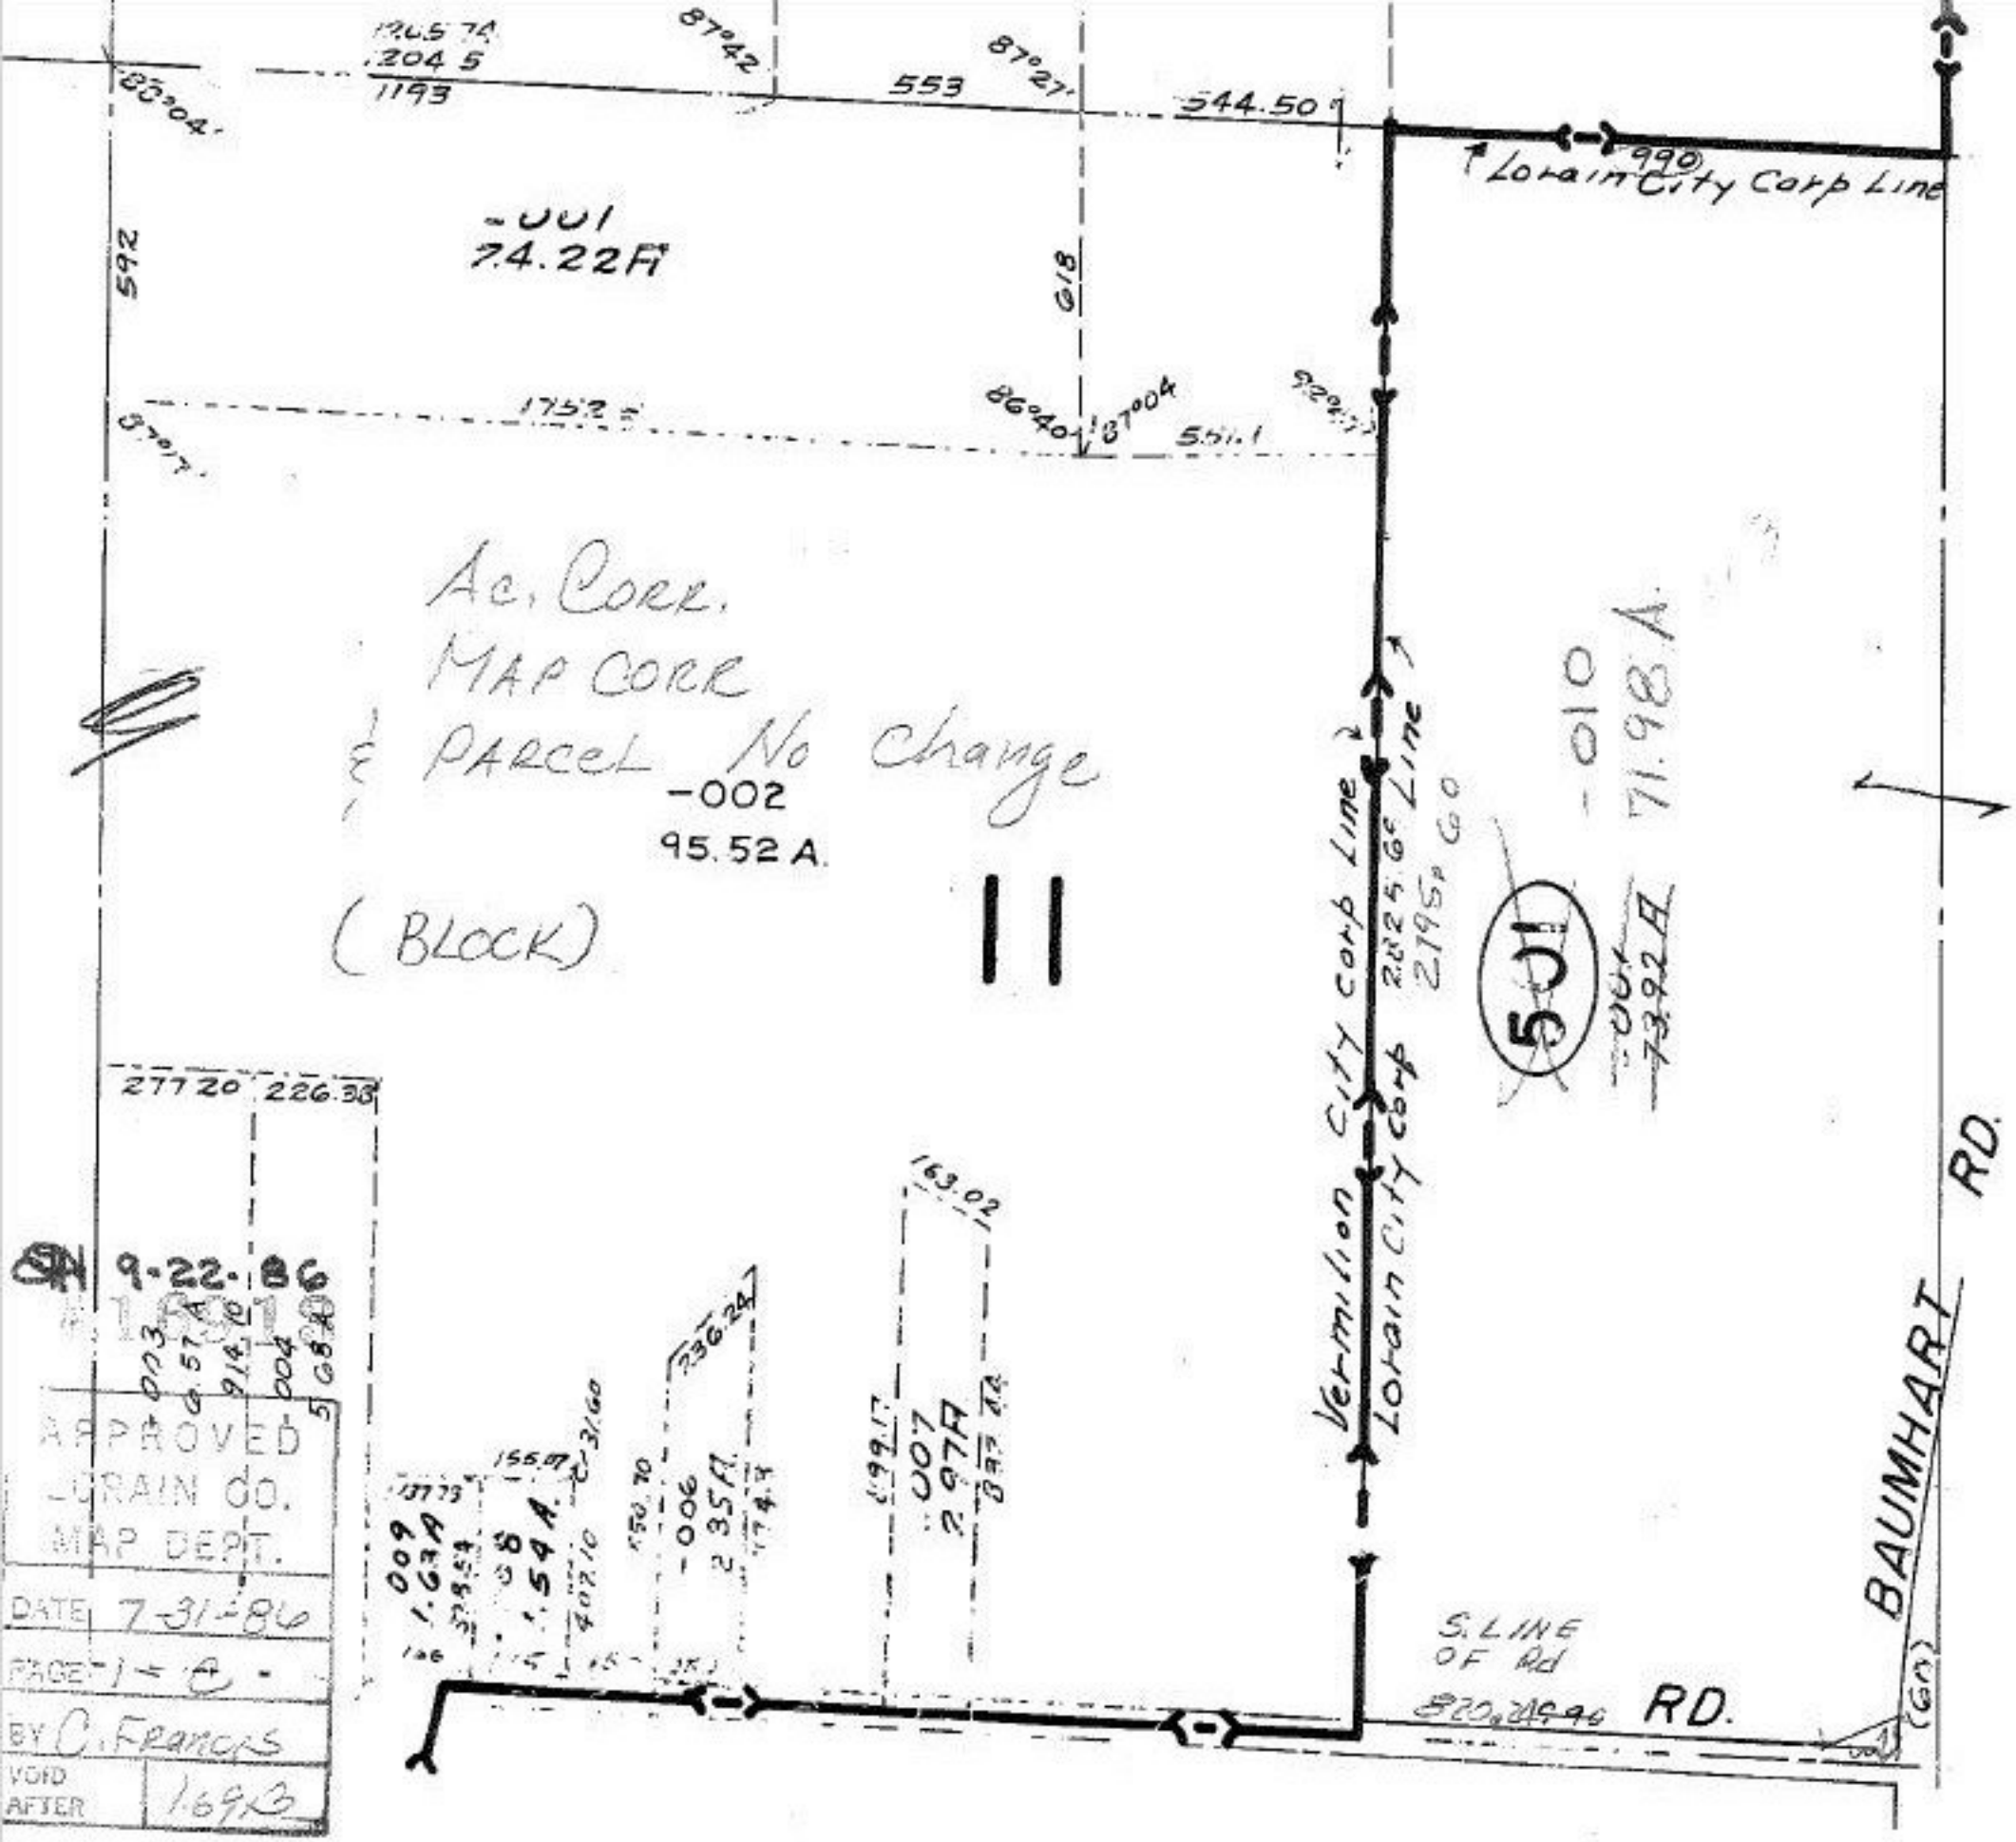

9-22-86

APPROVED
LORAIN CO.
MAP DEPT.
DATE 7-31-86
PAGE 1 - 8
BY C. Francis
VOID AFTER 1.69 B

APPROVED
LORAIN CO.
MAP DEPT.
DATE
PAGE
BY
VOID AFTER