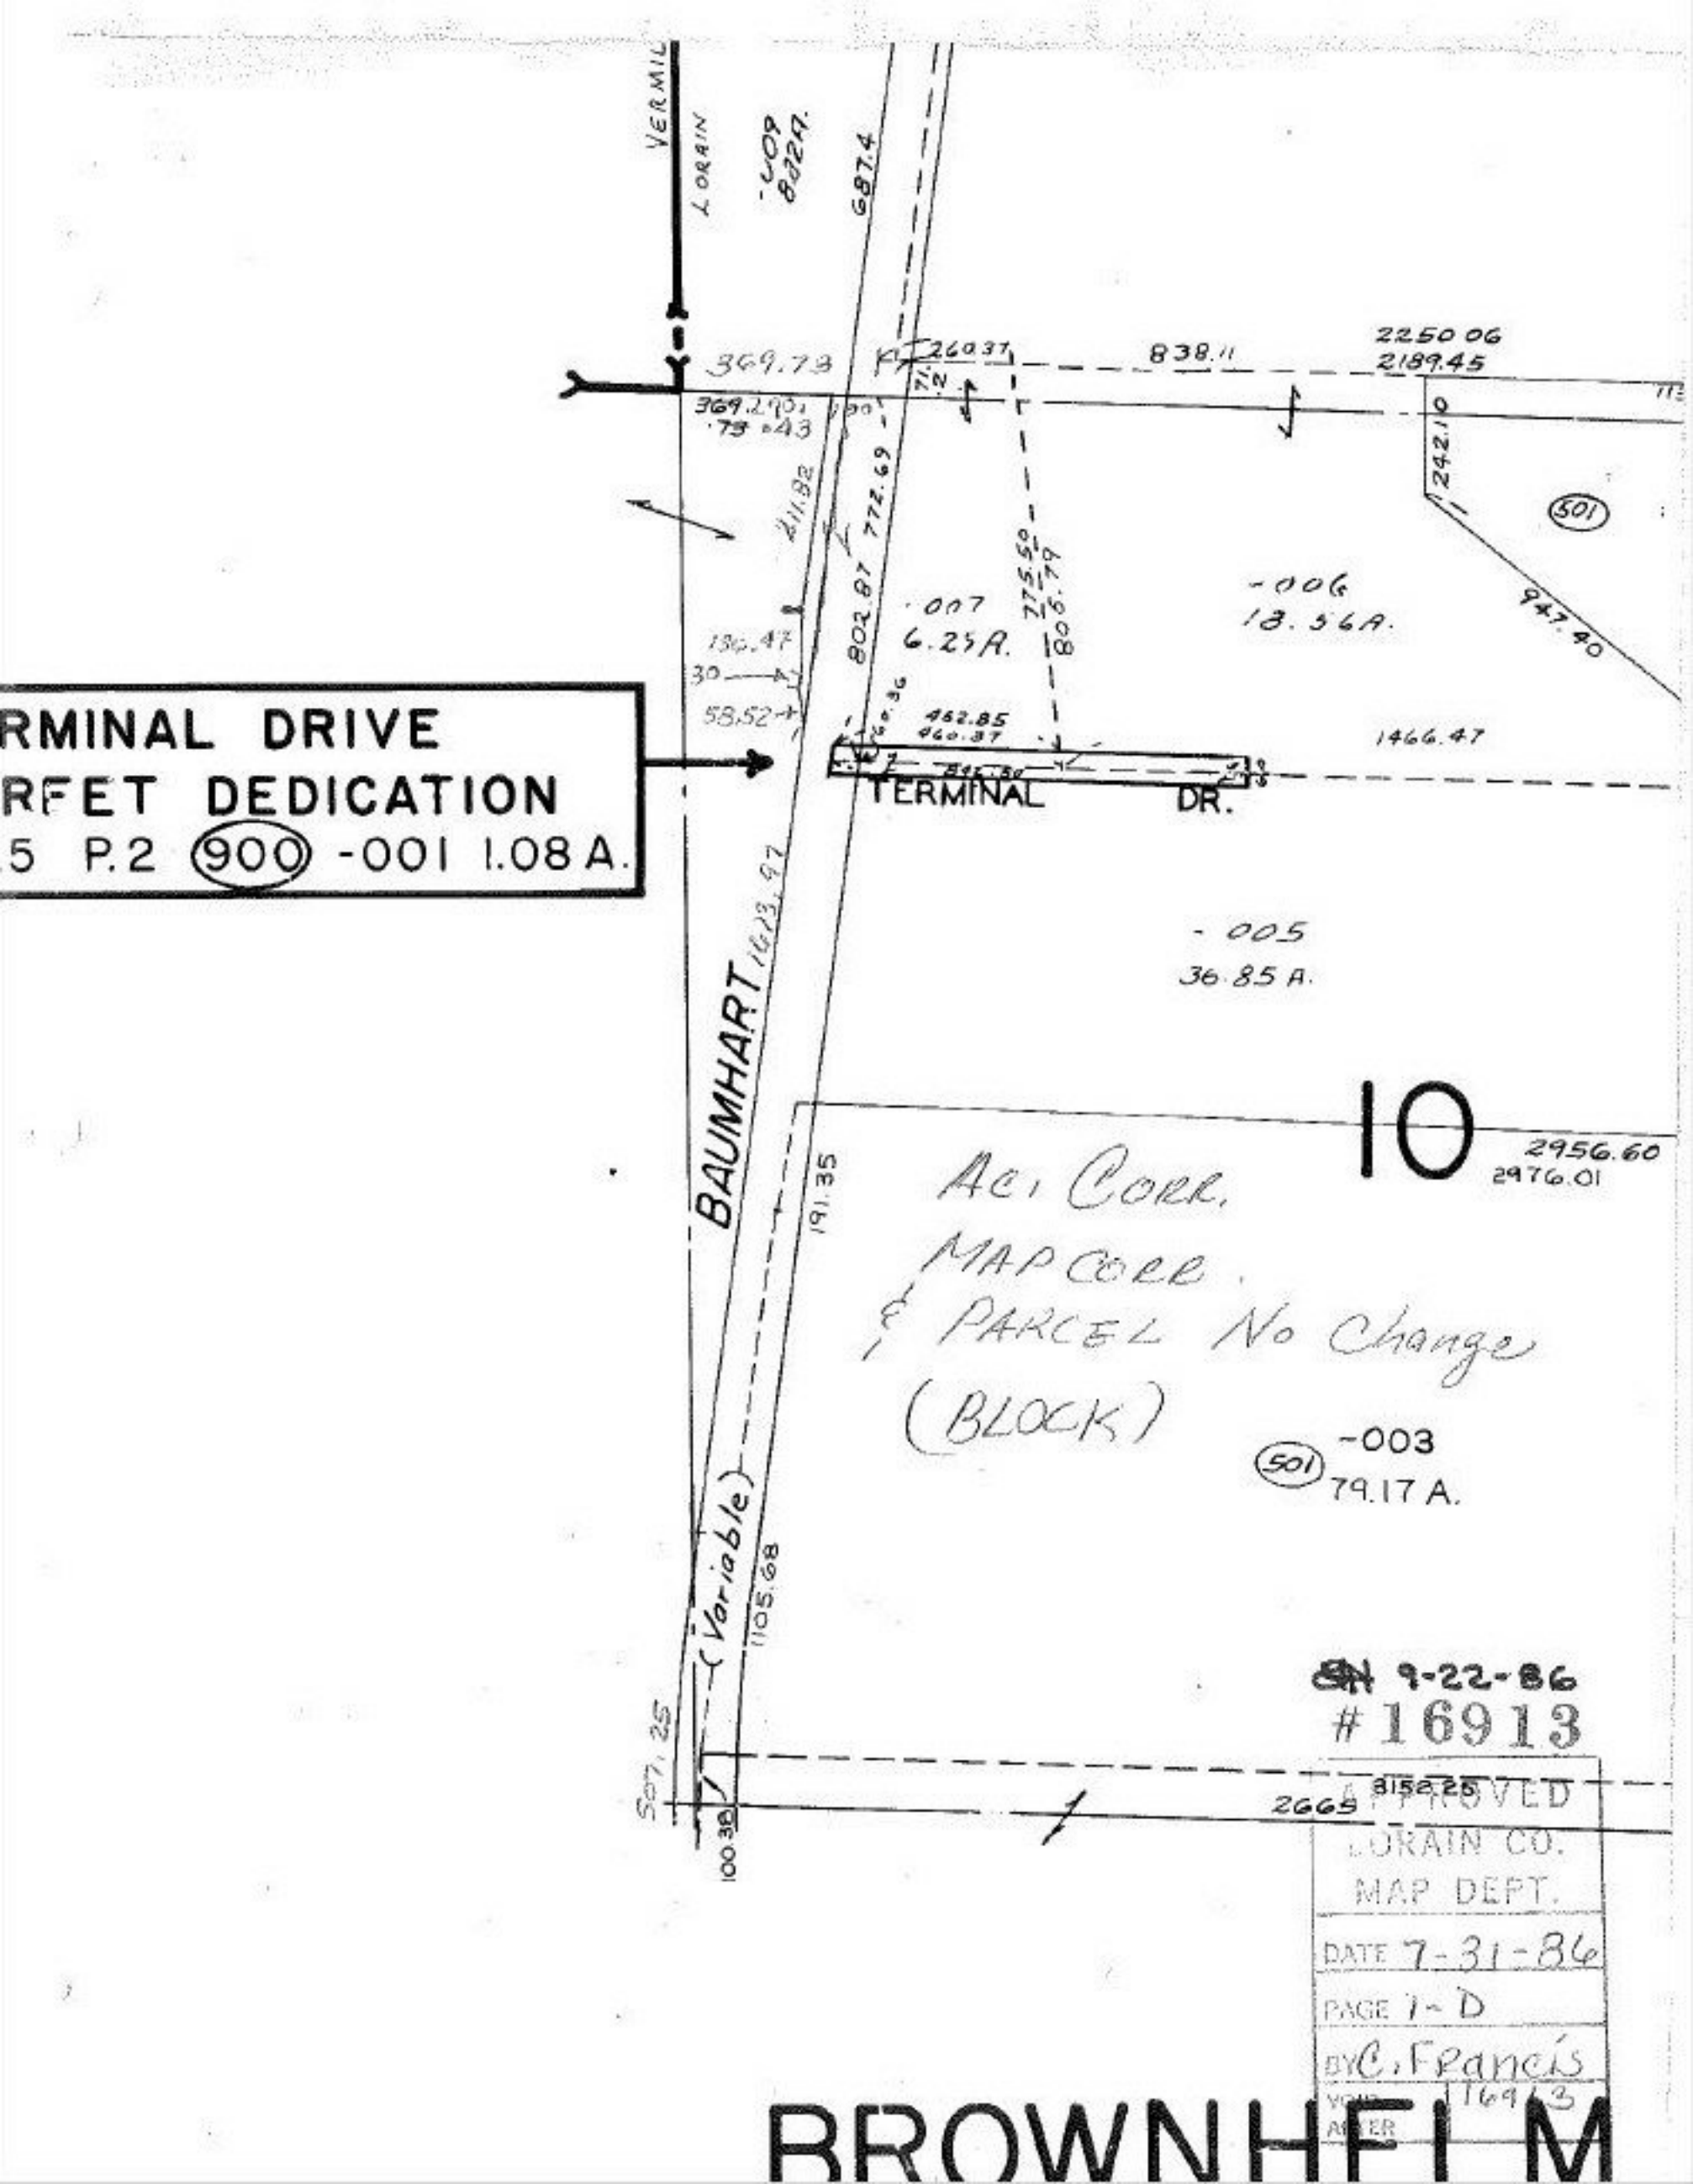

RMINAL DRIVE
RFET DEDICATION
5 P.2 900 -001 1.08 A.
VERMIL
LORAIN
-009
802A.
687.4
369.73
260.37
838.11
2250.06
2189.45
369.290
.73 .43
242.10
501
211.82
772.69
802.87
775.50
806.79
-007
6.25A.
-006
18.56A.
947.40
136.47
30
58.52
462.85
460.37
1466.47
TERMINAL DR.
1613.97
-005
36.85 A.
BAUMHART
10
2956.60
2976.01
191.35
Ac. Corr.
MAP CORR.
& PARCEL No Change
(BLOCK)
-003
501
79.17 A.
(Variable)
1105.68
507.25
100.38
2665
3152.25
9-22-86
#16913
APPROVED
LORAIN CO.
MAP DEPT.
DATE 7-31-86
PAGE 1-D
BY C. Francis
VOID 16913
AFTER
BROWNHELM