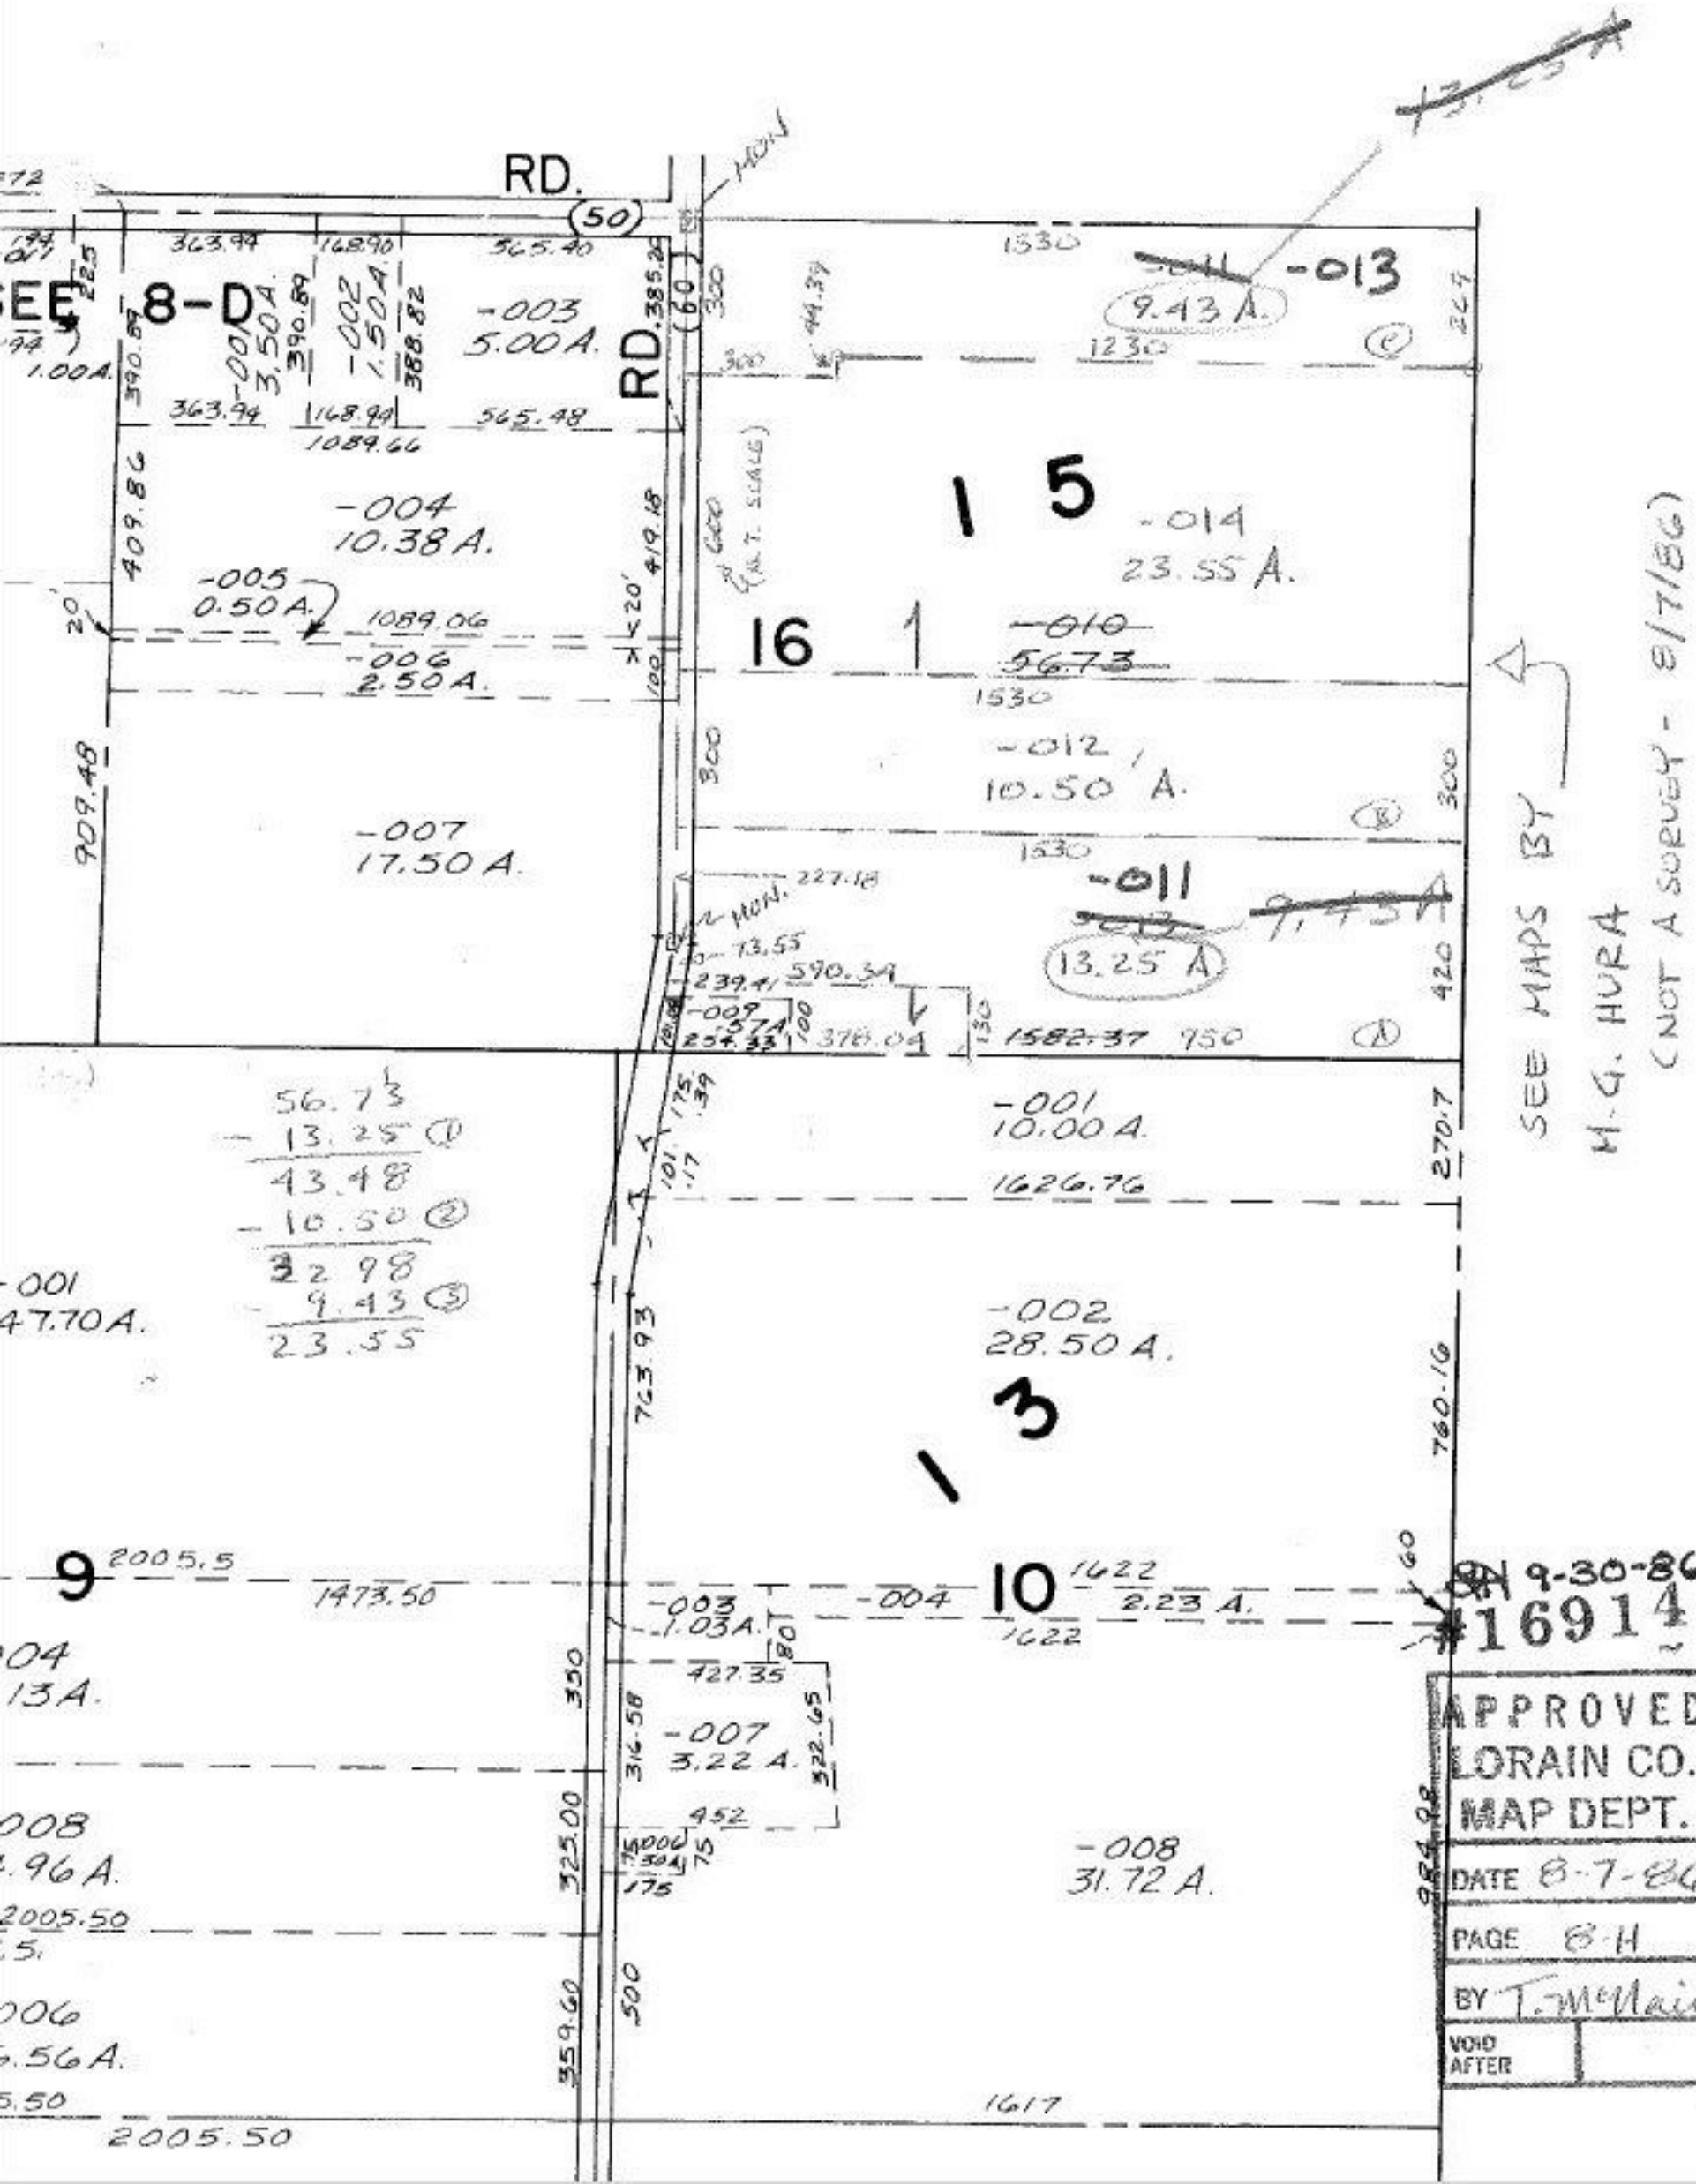
RD.
(50)
SEE 8-D
RD.
-003
5.00 A.
-004
10.38 A.
-005
0.50 A.
-006
2.50 A.
-007
17.50 A.
-001
3.50 A.
-002
1.50 A.
1.00 A.
1089.66
1089.06
409.86
909.48
419.18
1530
1230
-013
9.43 A.
15
-014
23.55 A.
16
-010
56.73
-012
10.50 A.
-011
13.25 A.
9.43 A.
1582.37
750
227.18
73.55
590.34
378.04
56.73
- 13.25 ①
43.48
- 10.50 ②
32.98
- 9.43 ③
23.55
-001
10.00 A.
1626.76
-002
28.50 A.
13
-001
47.70 A.
9
2005.5
1473.50
10
1622
2.23 A.
-003
1.03 A.
-004
427.35
-007
3.22 A.
-008
31.72 A.
-008
.96 A.
2005.50
-006
.56 A.
2005.50
1617
SEE MAPS BY
H.G. HURA
(NOT A SURVEY - 8/7/86)
9-30-86
#16914
APPROVED
LORAIN CO.
MAP DEPT.
DATE 8-7-86
PAGE 8-H
BY T. McNair
VOID AFTER