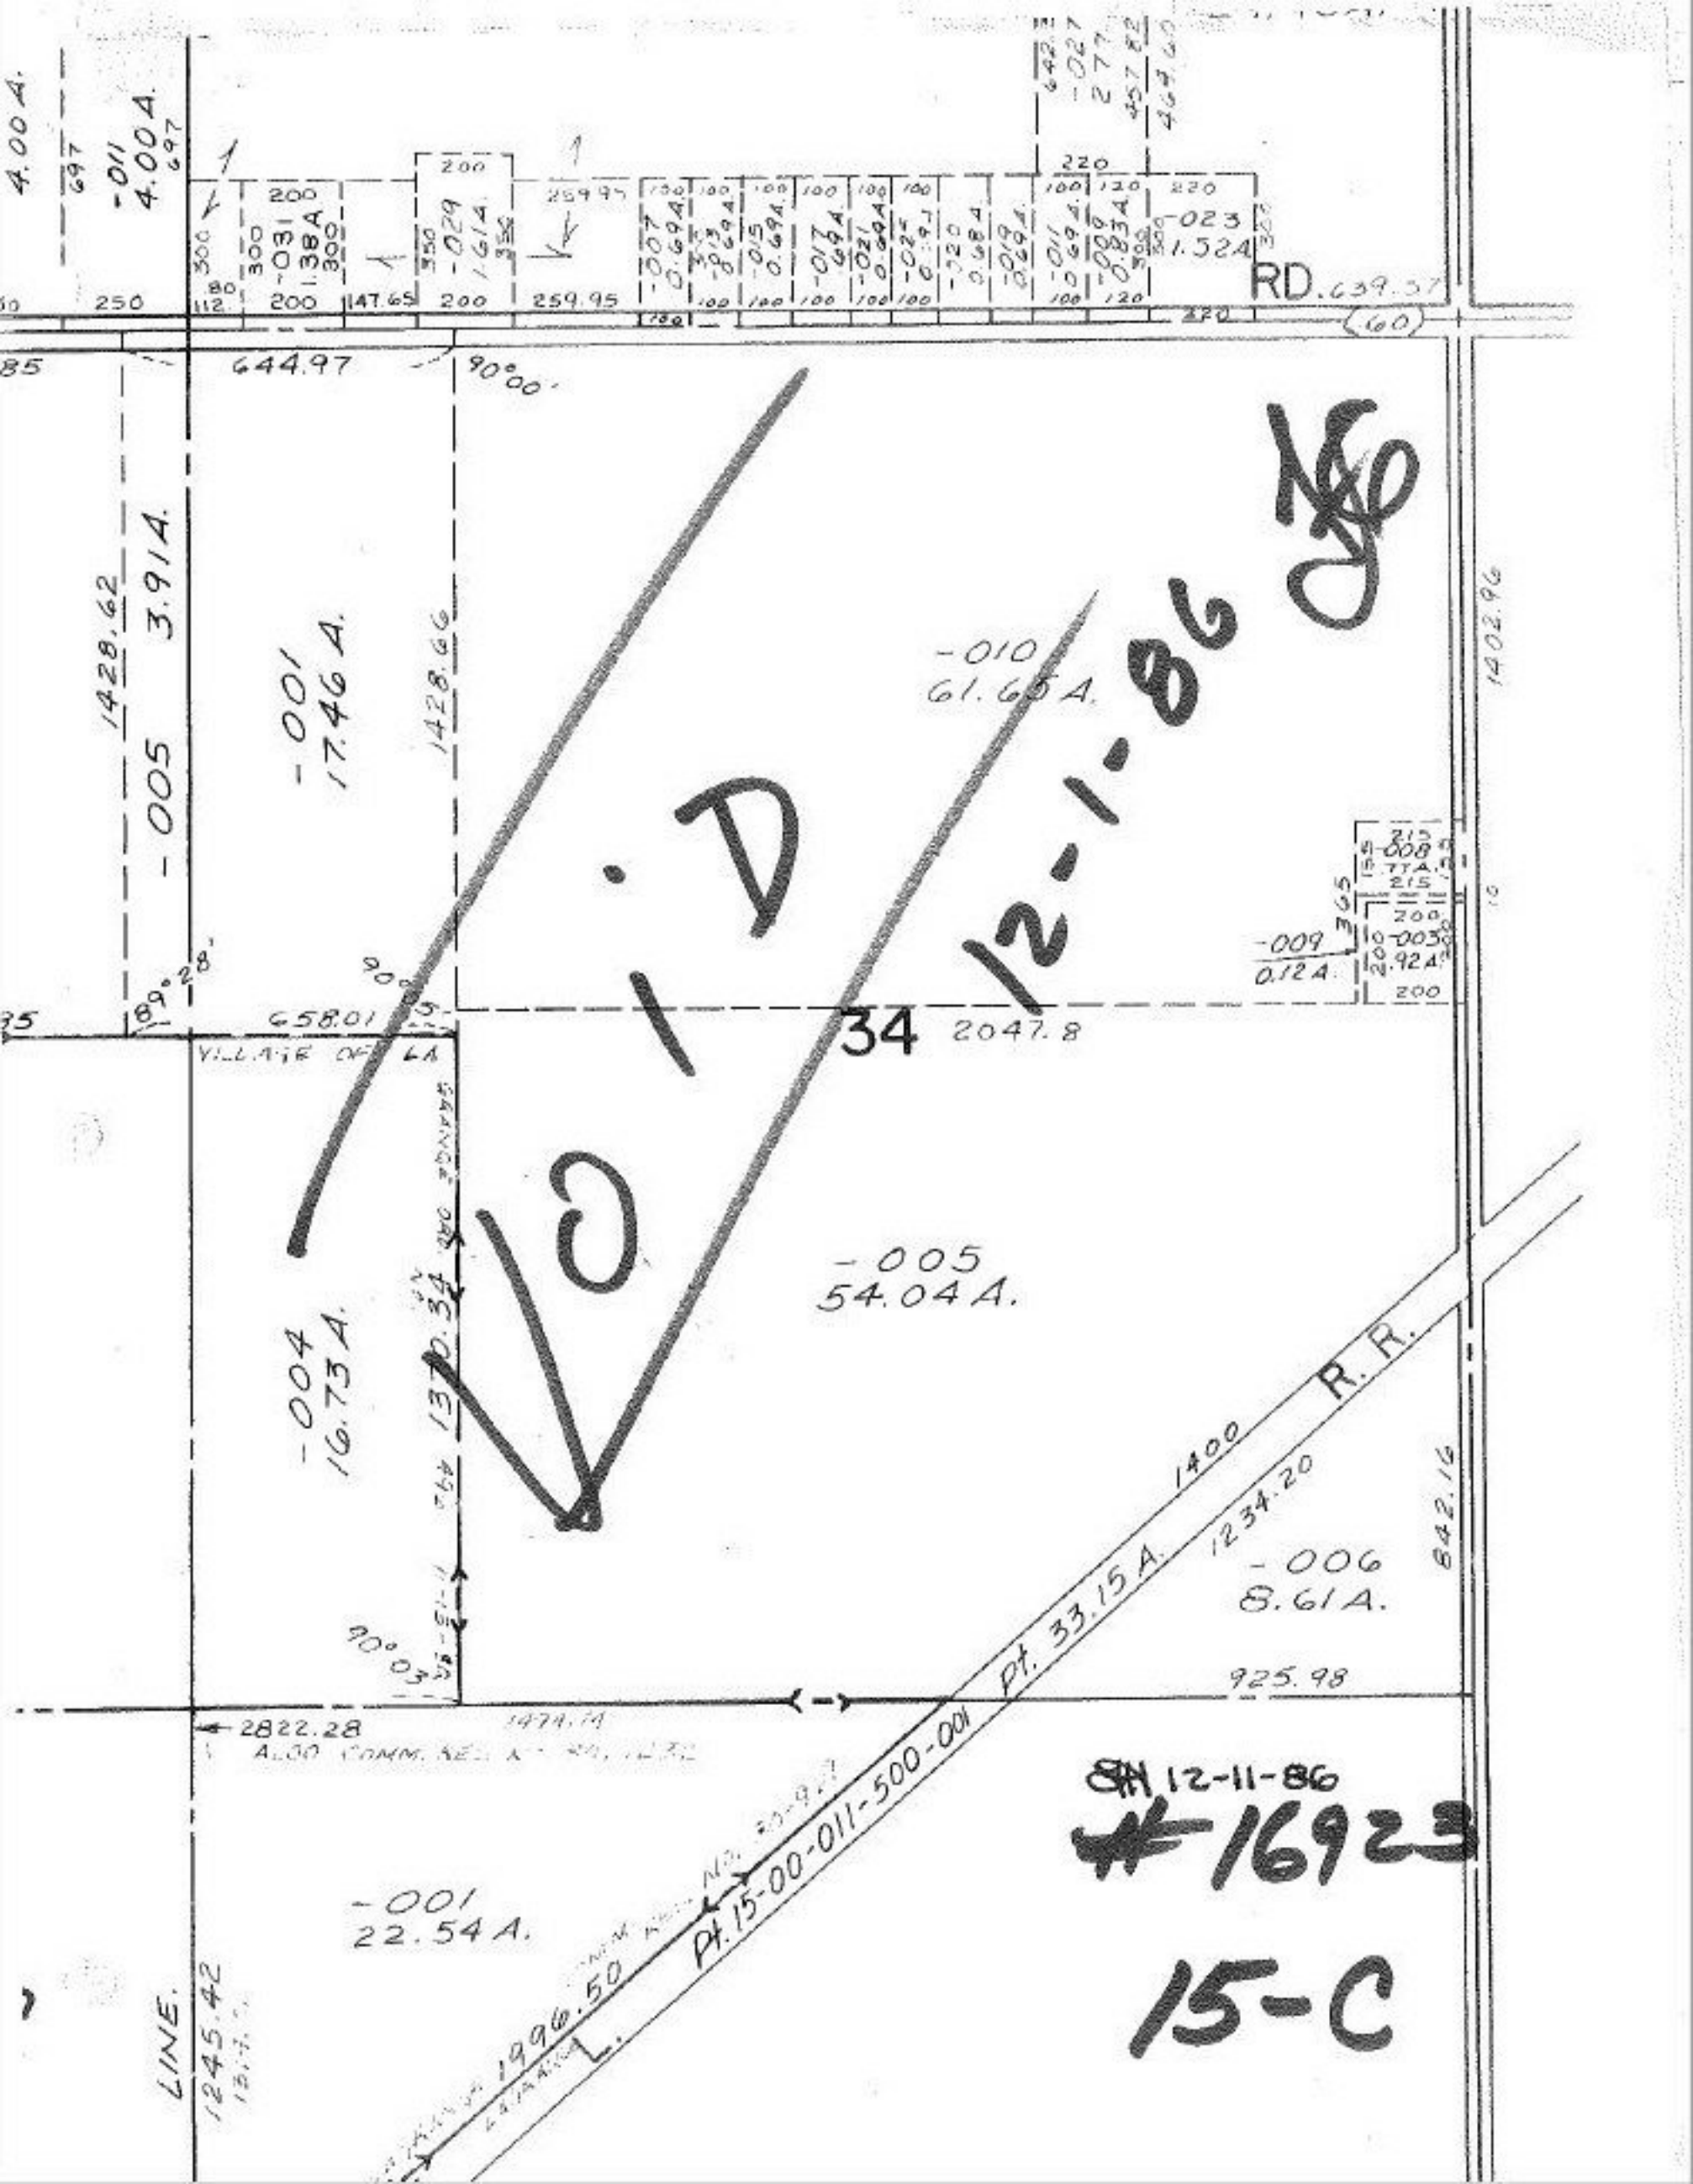
-011
4.004 A.
-031
1.38 A.
-029
1.614 A.
-007
0.694 A.
-008
0.694 A.
-015
0.694 A.
-017
0.694 A.
-021
0.694 A.
-025
0.694 A.
-020
0.584 A.
-019
0.694 A.
-011
0.694 A.
-006
0.834 A.
-023
1.52 A.
RD. 639.37
644.97
90°00'
1428.62
-005
3.914 A.
-001
17.46 A.
1428.66
-010
61.66 A.
1402.96
-008
.77 A.
-009
0.12 A.
-003
2.92 A.
89°28'
658.01
34
2047.8
VILLAGE OF LA
-004
16.73 A.
1370.34
-005
54.04 A.
-006
8.61 A.
1234.20
1400
R.R.
842.16
925.98
2822.28
-001
22.54 A.
1245.42
LINE.
1996.50
Pt. 15-00-011-500-001
Pt. 33.15 A.
SW 12-11-86
#16923
15-C