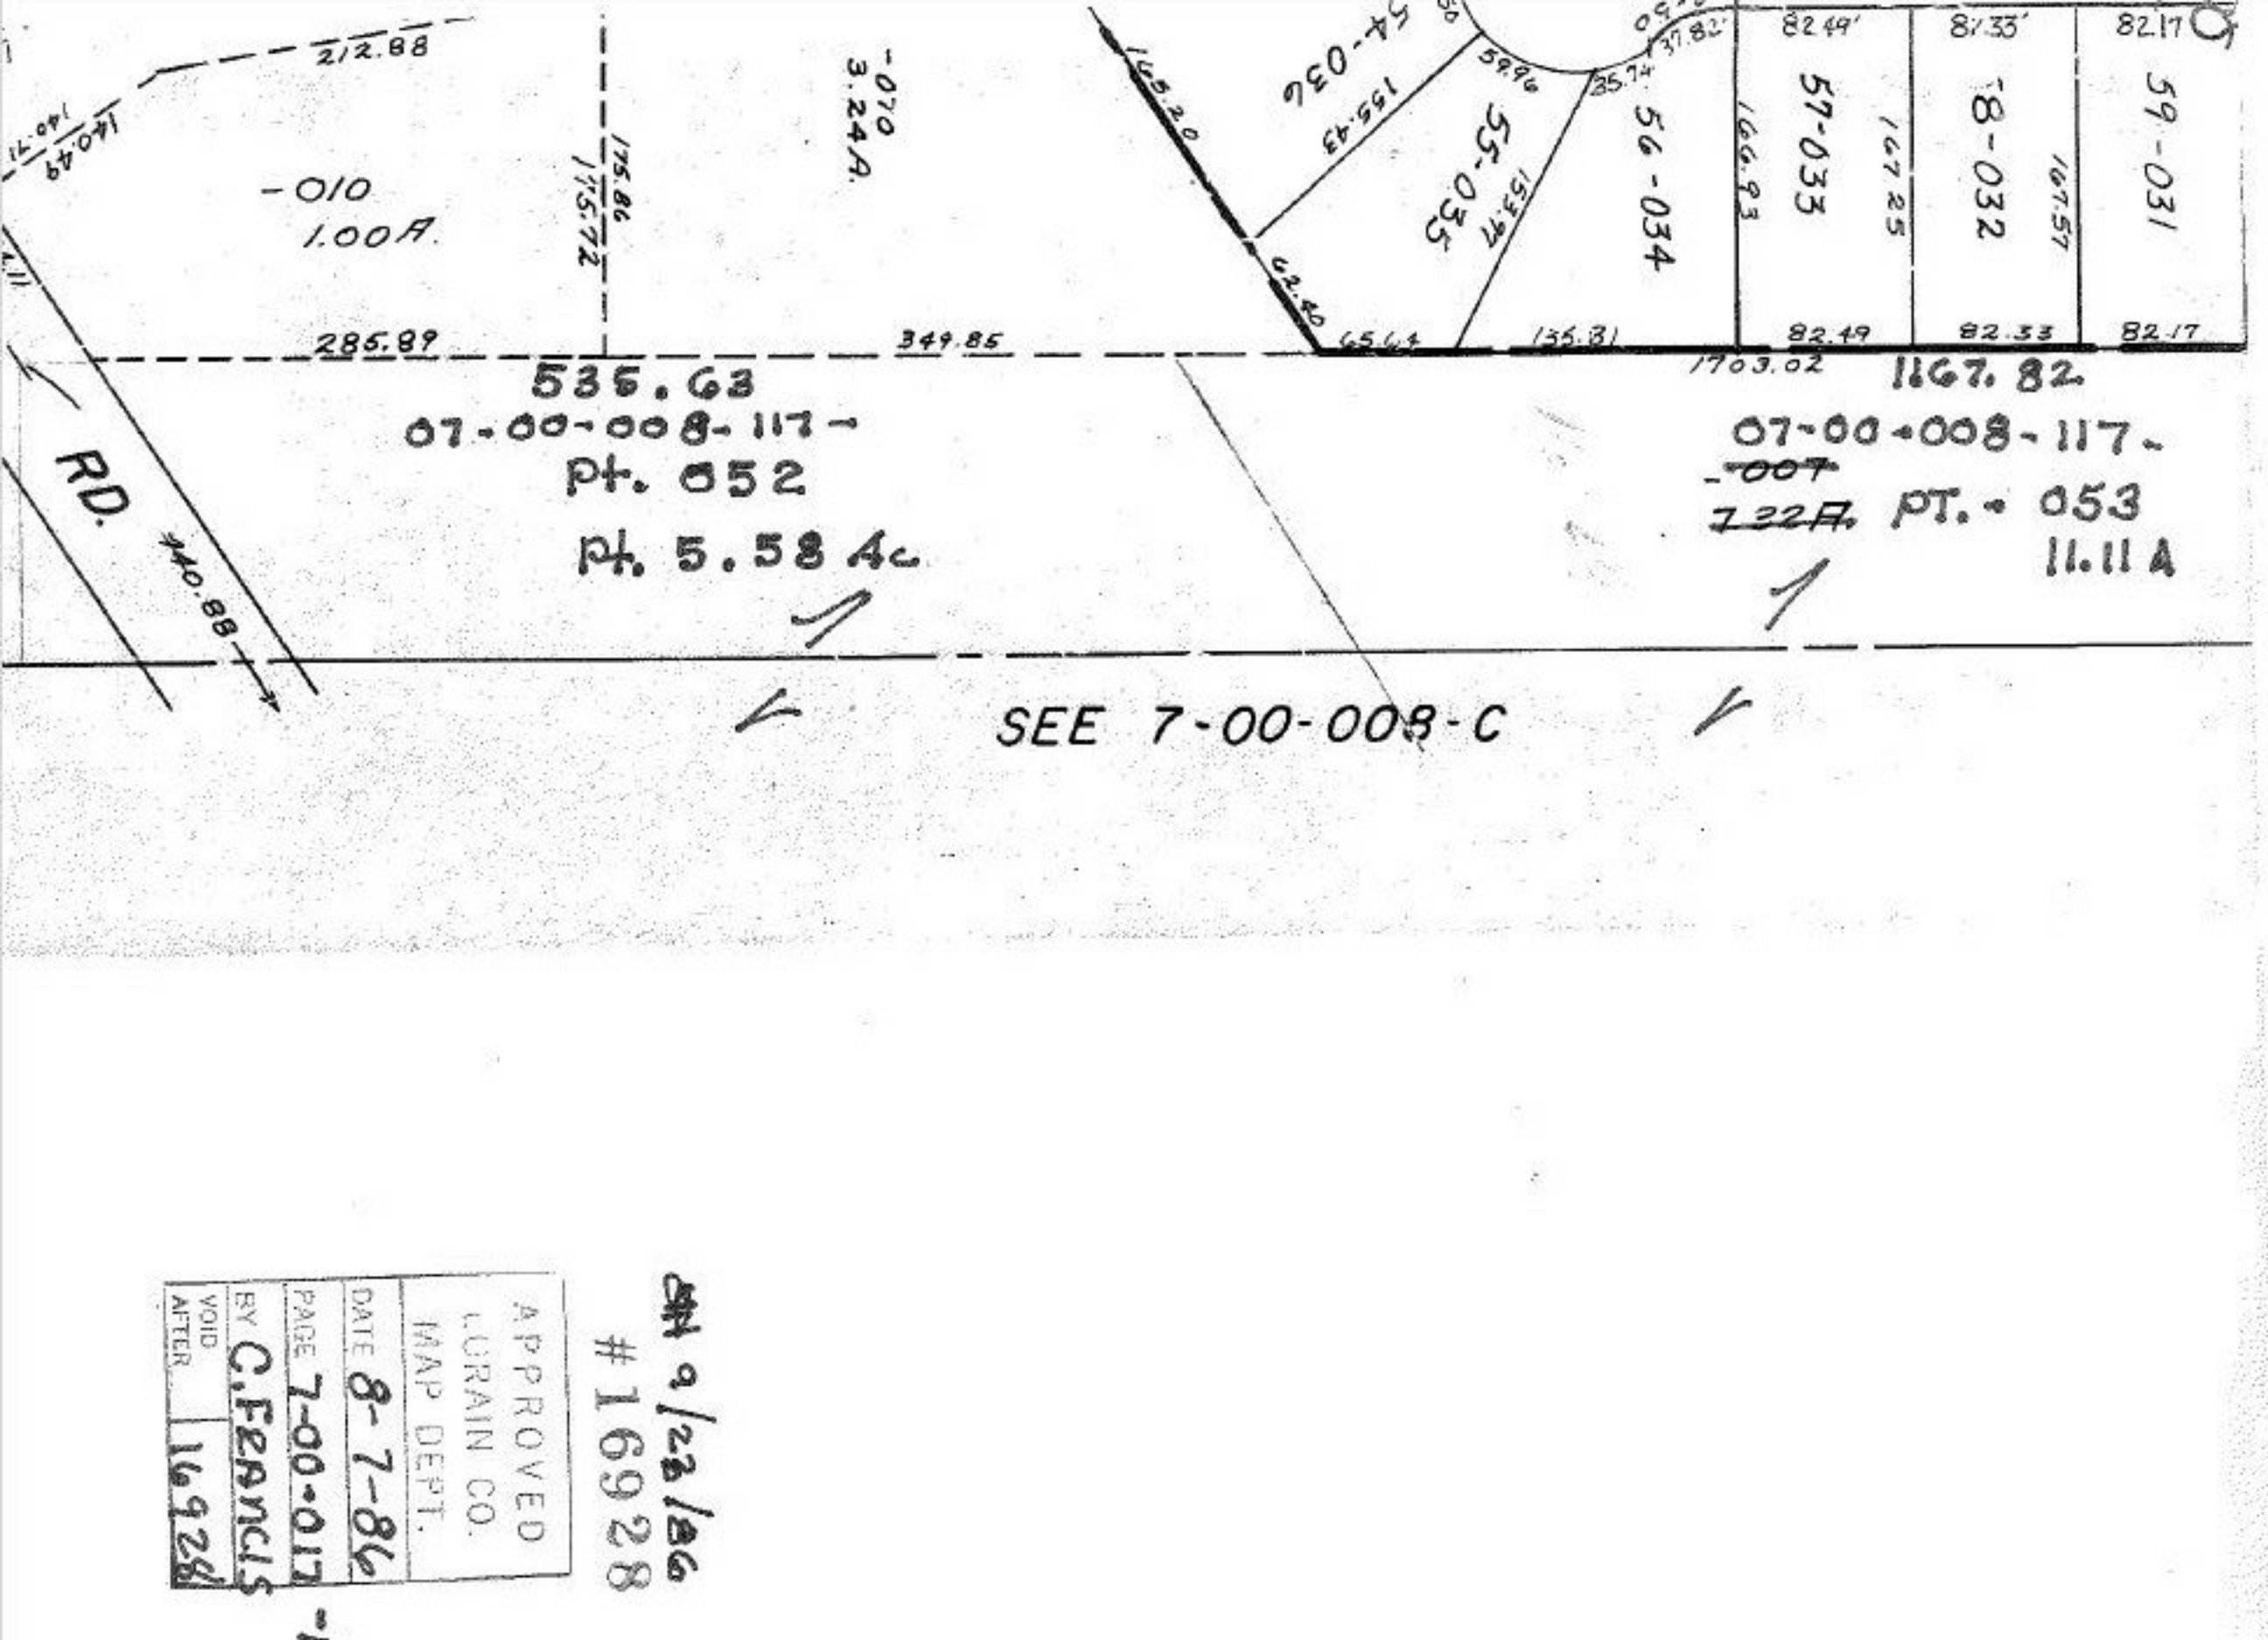

APPROVED
LURAIN CO.
MAP DEPT.

DATE 8-7-86

PAGE 7-00-017

BY C.FRANCIS

VOID AFTER 16928

9/23/86 MK

#16928

7-