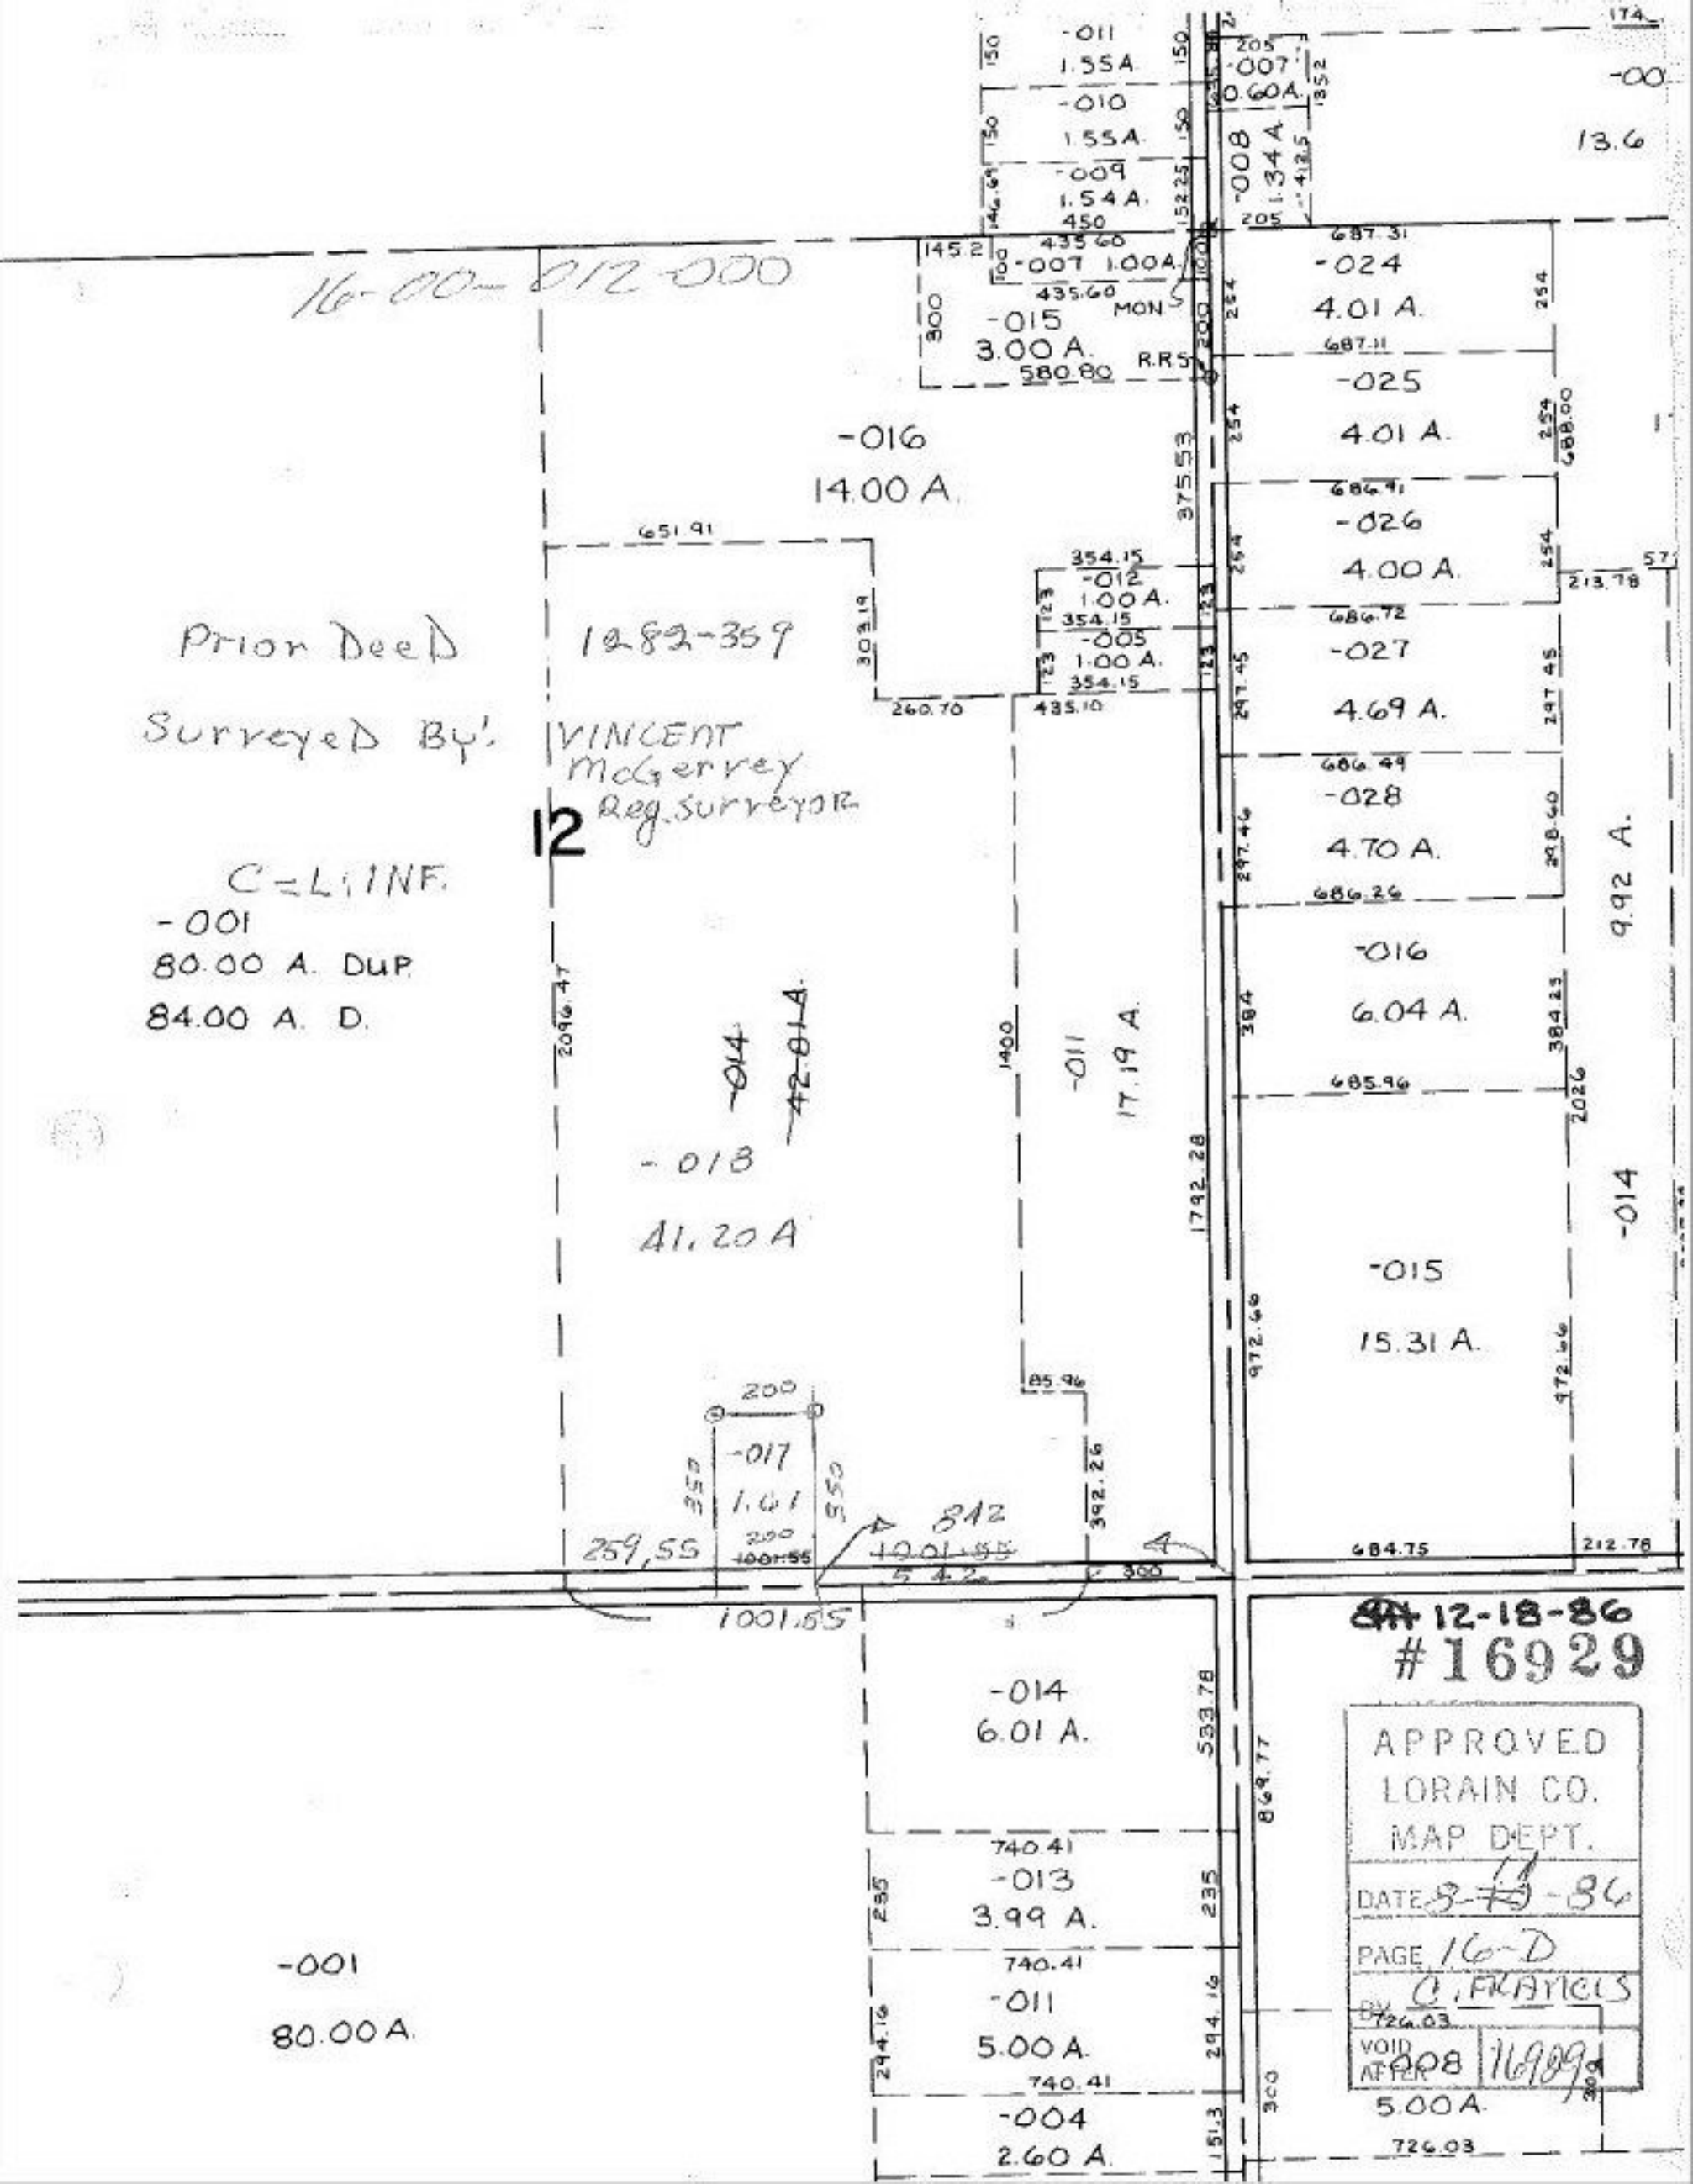

16-00-012-000
-011
1.55A
-010
1.55A
-009
1.54A
-007
0.60A
-008
1.34A
-00
13.6
-007 1.00A
-015
3.00A
MON
R.R.S.
-024
4.01A
-025
4.01A
-016
14.00A
-026
4.00A
-012
1.00A
-005
1.00A
-027
4.69A
-028
4.70A
-016
6.04A
-015
15.31A
-014
9.92A
Prior Deed
1282-359
Surveyed By:
VINCENT McGerrey Reg. Surveyor
12
C=L:INF.
-001
80.00 A. DUP.
84.00 A. D.
-014
42.01A
-018
41.20A
-011
17.19A
-017
1.61
842
1001.55
259.55
-014
6.01A
-013
3.99A
-011
5.00A
-004
2.60A
-001
80.00A
12-18-86
#16929
APPROVED
LORAIN CO.
MAP DEPT.
DATE 8-11-86
PAGE 16-D
BY C. FRANCIS
VOID AFTER 1-08
16929