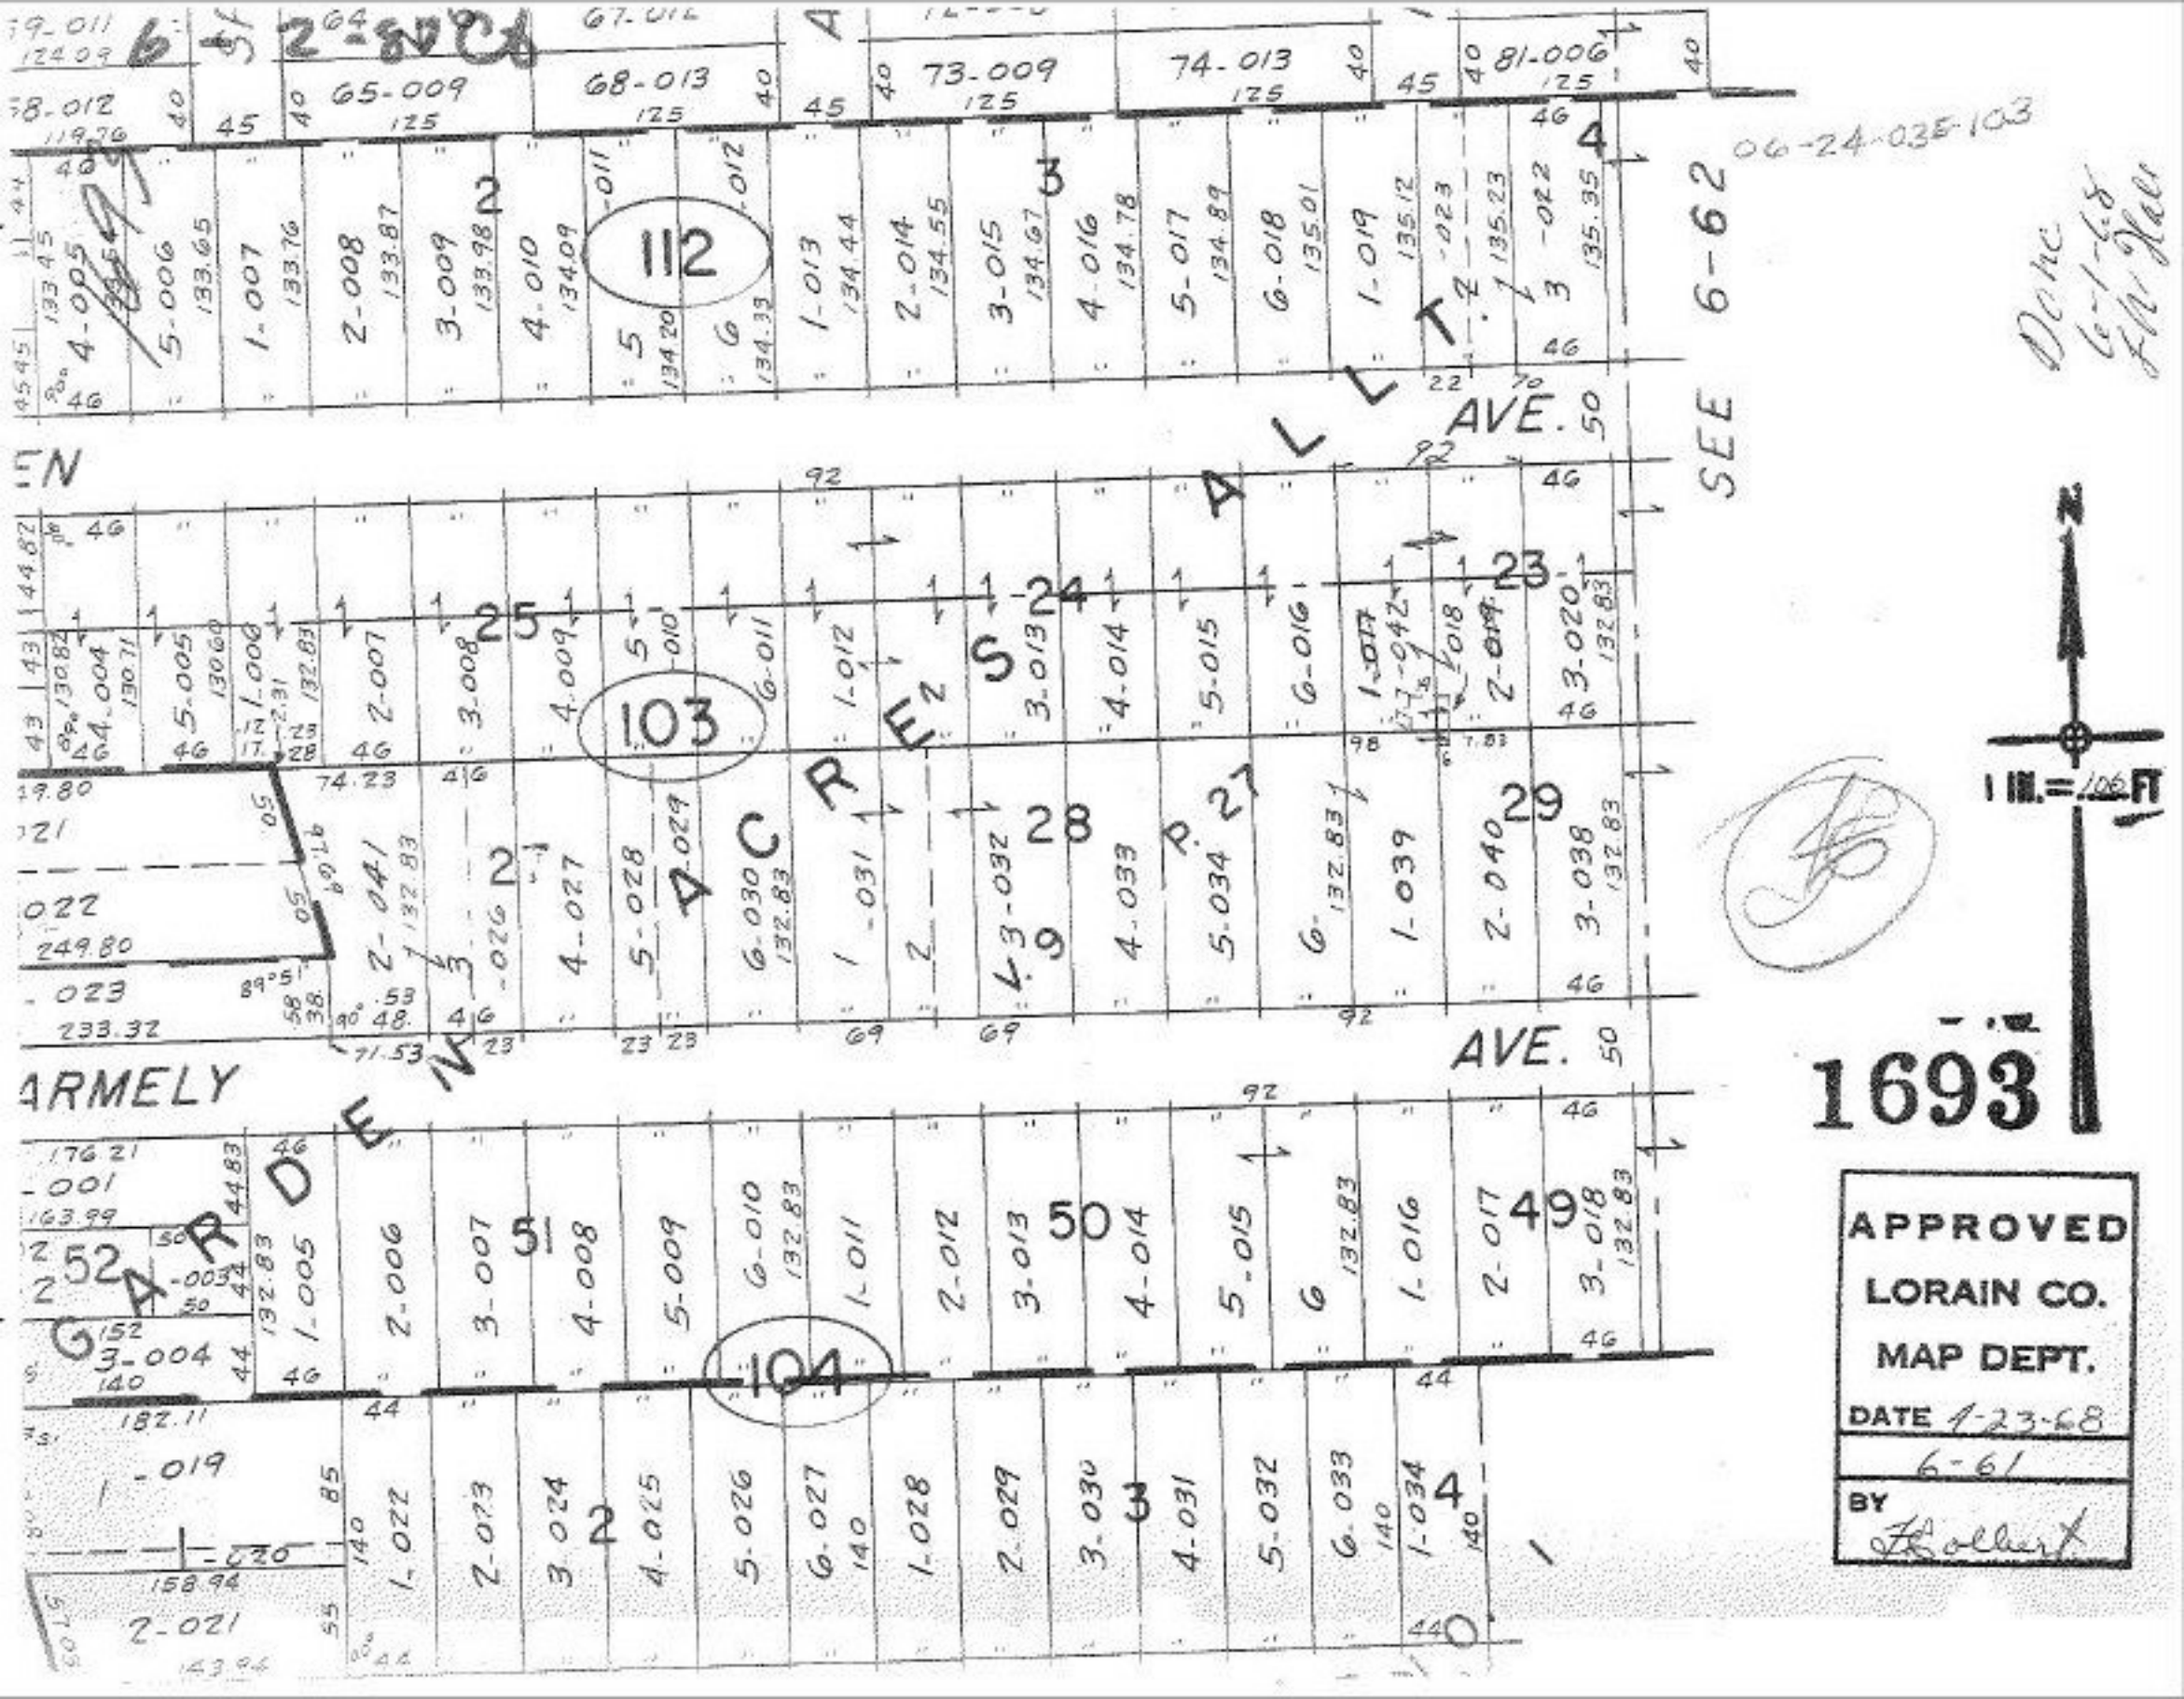

06-24-035-103
SEE 6-62
AVE.
ARMELY
GARDEN ACRES ALLT.
112
103
104
1 IN. = 106 FT
N
1693
APPROVED
LORAIN CO.
MAP DEPT.
DATE 1-23-68
6-61
BY