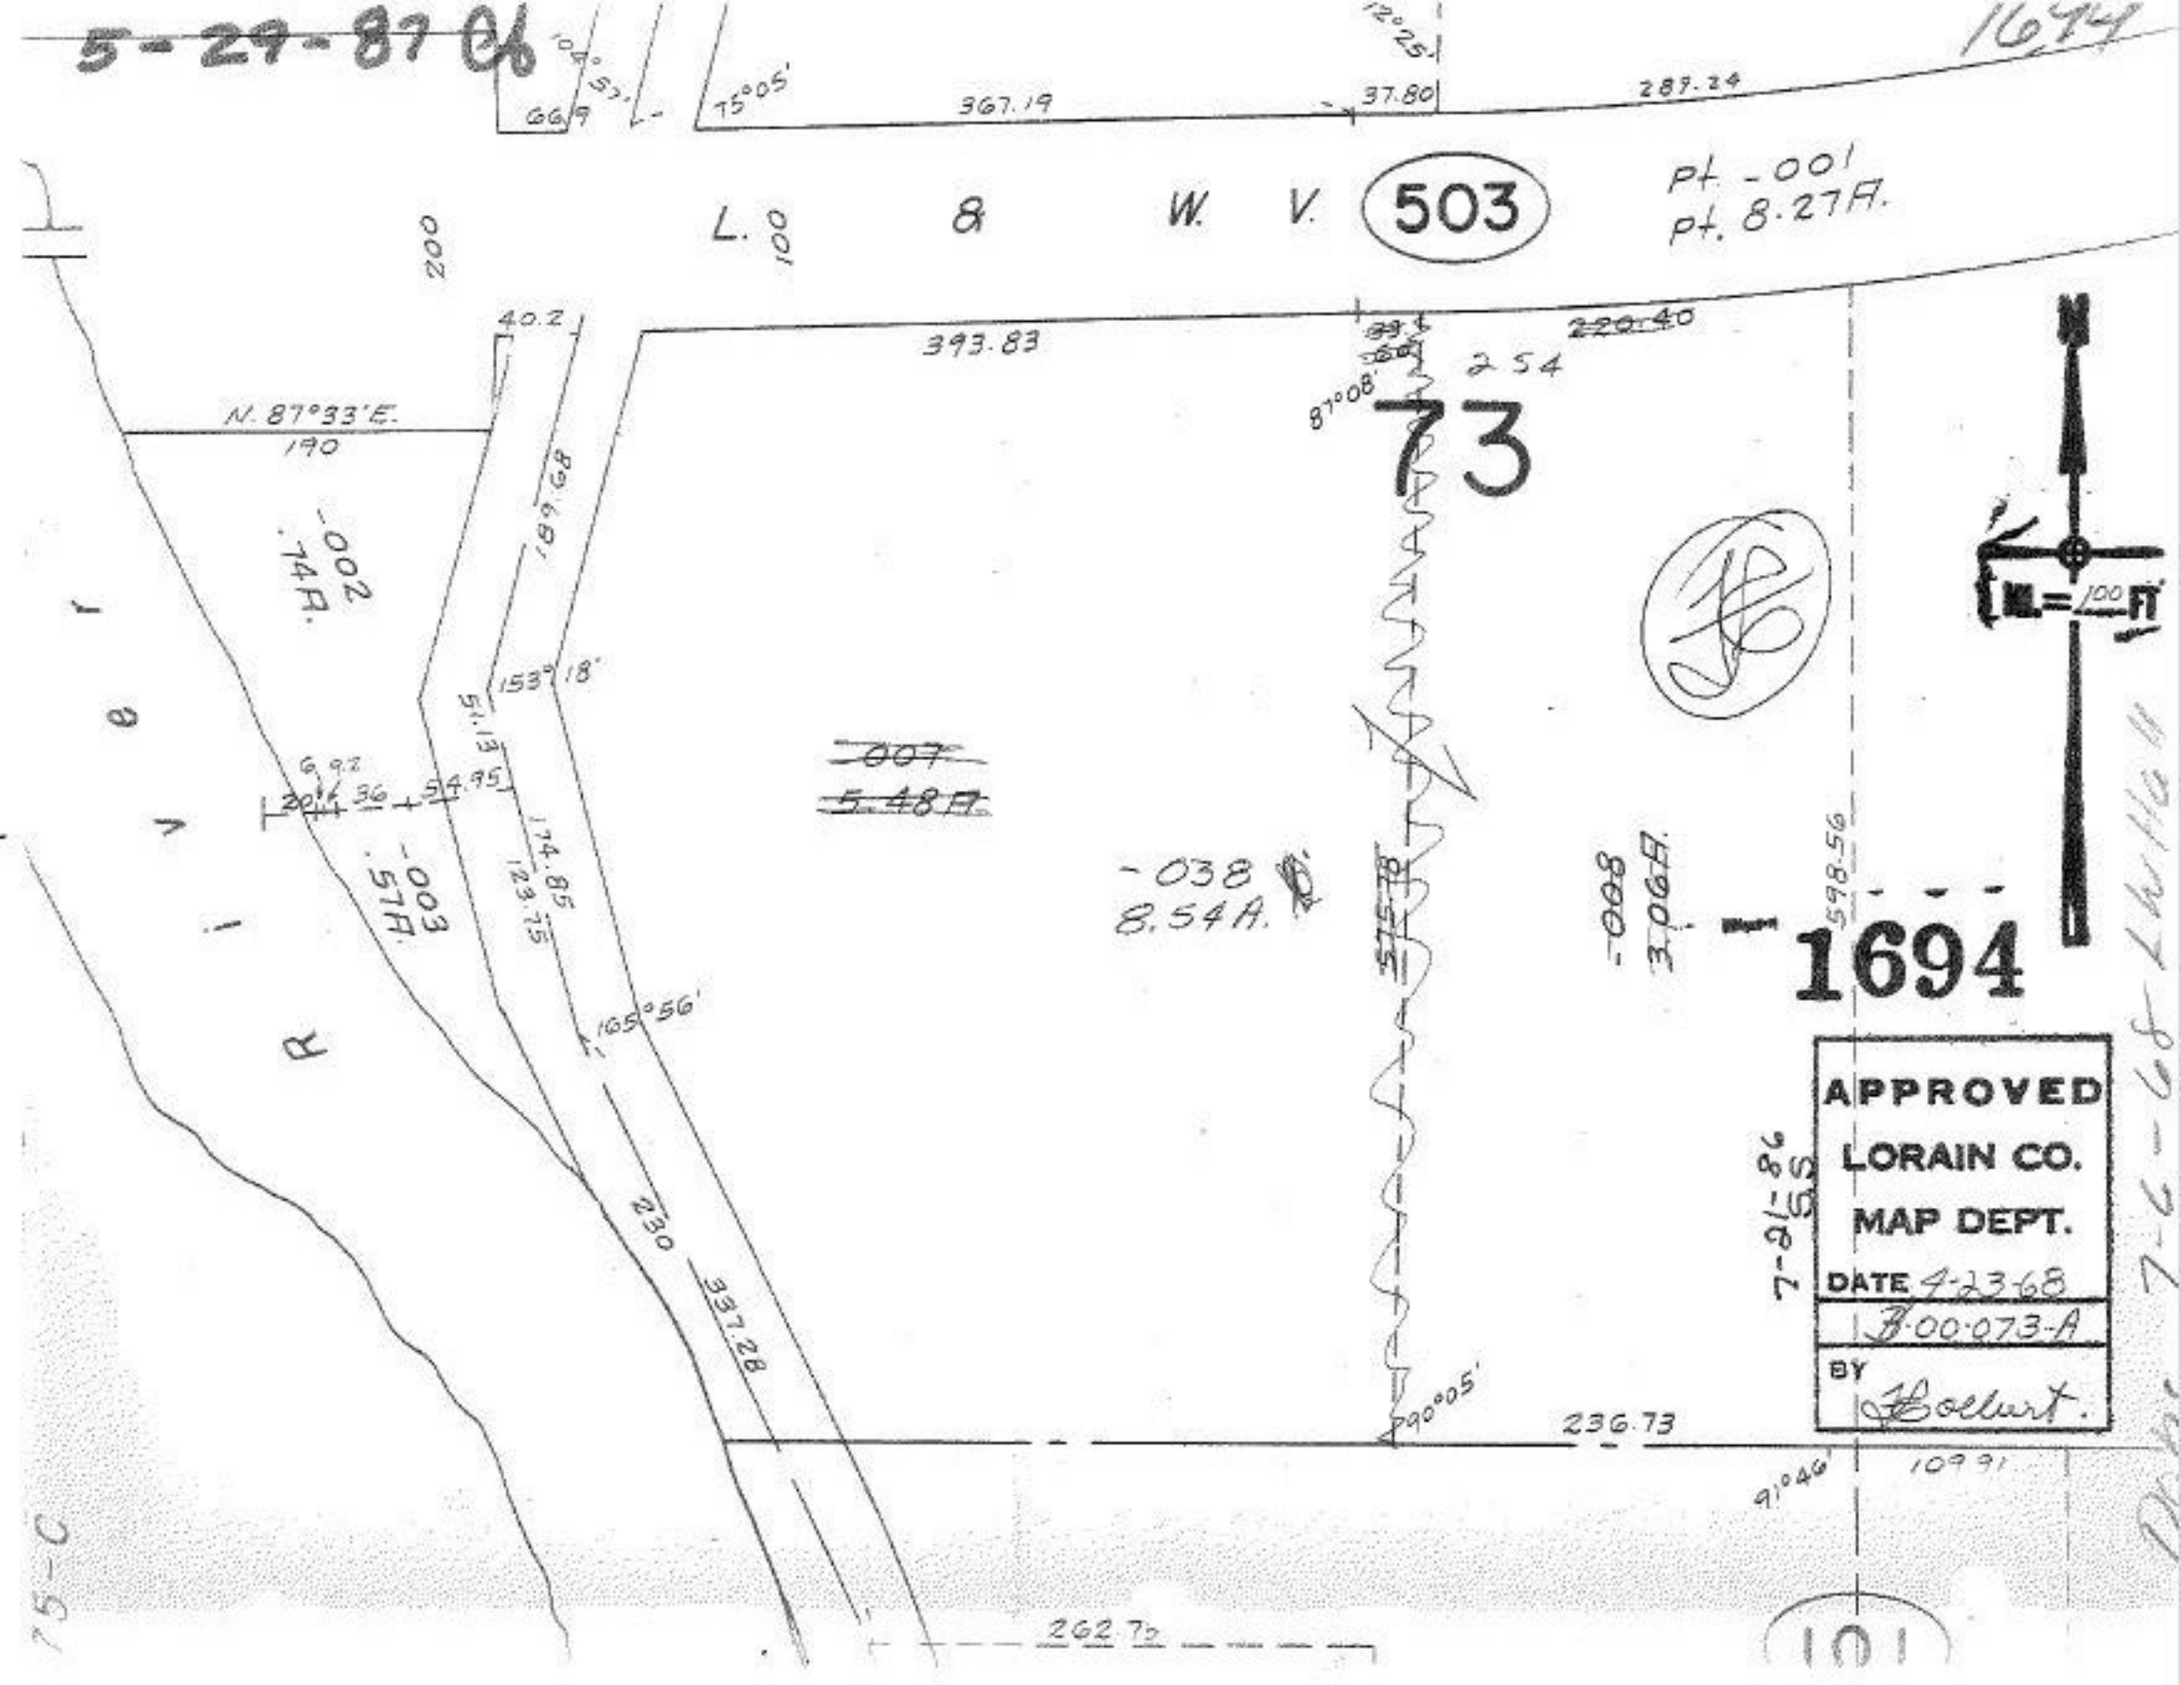
5-29-87
1694
L. & W. V.
503
Pt. -001
Pt. 8.27A.
73
1694
-002
.74A.
-003
.57A.
-007
5.48A.
-038
8.54A.
-008
3.06A.
N. 87°33'E.
190
393.83
367.19
289.24
37.80
75°05'
66.9
40.2
189.68
153°18'
51.13
174.85
123.75
165°56'
230
337.28
87°08'
2.54
220.40
598.56
90°05'
236.73
91°46'
109.91
262.75
7-21-86
APPROVED
LORAIN CO.
MAP DEPT.
DATE 4-23-68
B-00-073-A
BY
101
75-C