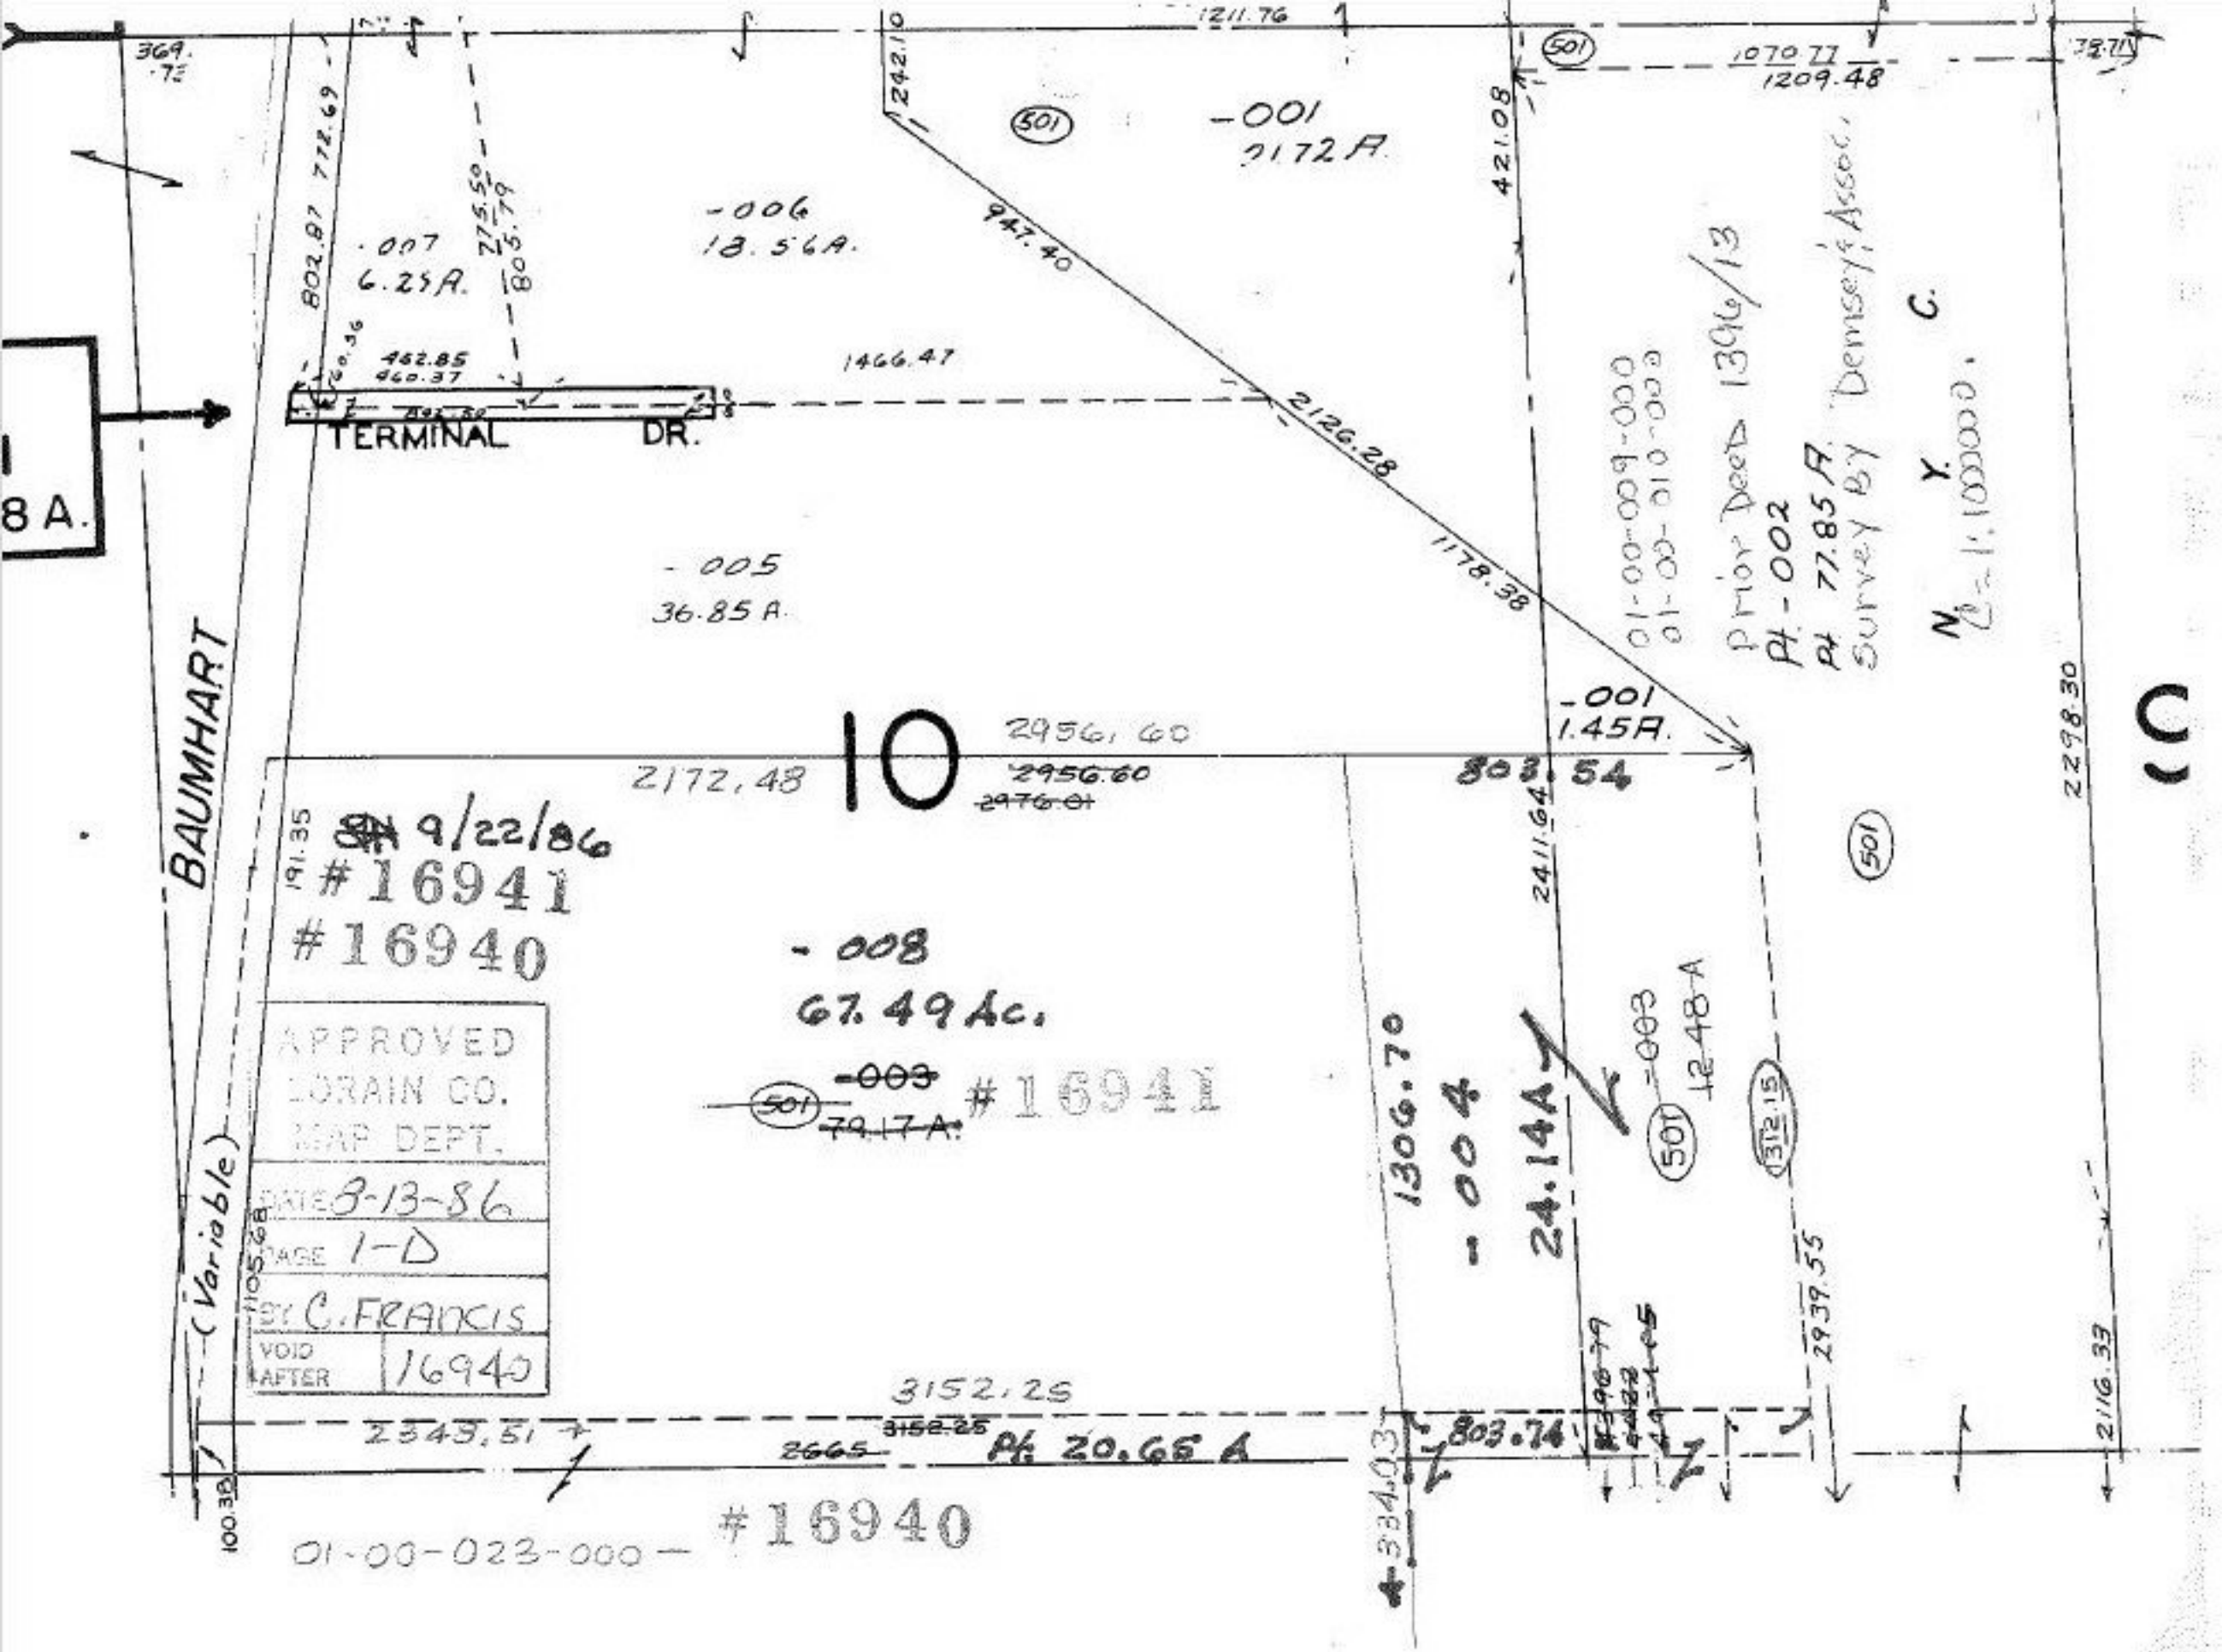

TERMINAL DR.
BAUMHART
8 A.
-007
6.25A.
-006
18.56A.
-005
36.85 A.
-001
21.72 A.
-001
1.45A.
-008
67.49 Ac.
-003
79.17 A.
-003
12.48 A
-004
24.14A
10
2172.48
2956.60
2976.01
803.54
1306.70
1466.47
947.40
2126.28
1178.38
1211.76
1070.77
1209.48
421.08
2411.64
2298.30
2939.55
2116.33
3152.25
2343.51
2665
Pt. 20.65 A
803.74
334.03
01-00-023-000
#16940
#16941
#16940
#16941
#16940
APPROVED
LORAIN CO.
MAP DEPT.
DATE 8-13-86
PAGE 1-D
BY C. FRANCIS
VOID AFTER 16940
(Variable)
Prior Deed 1396/13
Pt. -002
Pt. 77.85 A.
Survey By Demsey & Assoc.
N. Y. C.
C=1:1000000.
01-00-009-000
01-00-010-000