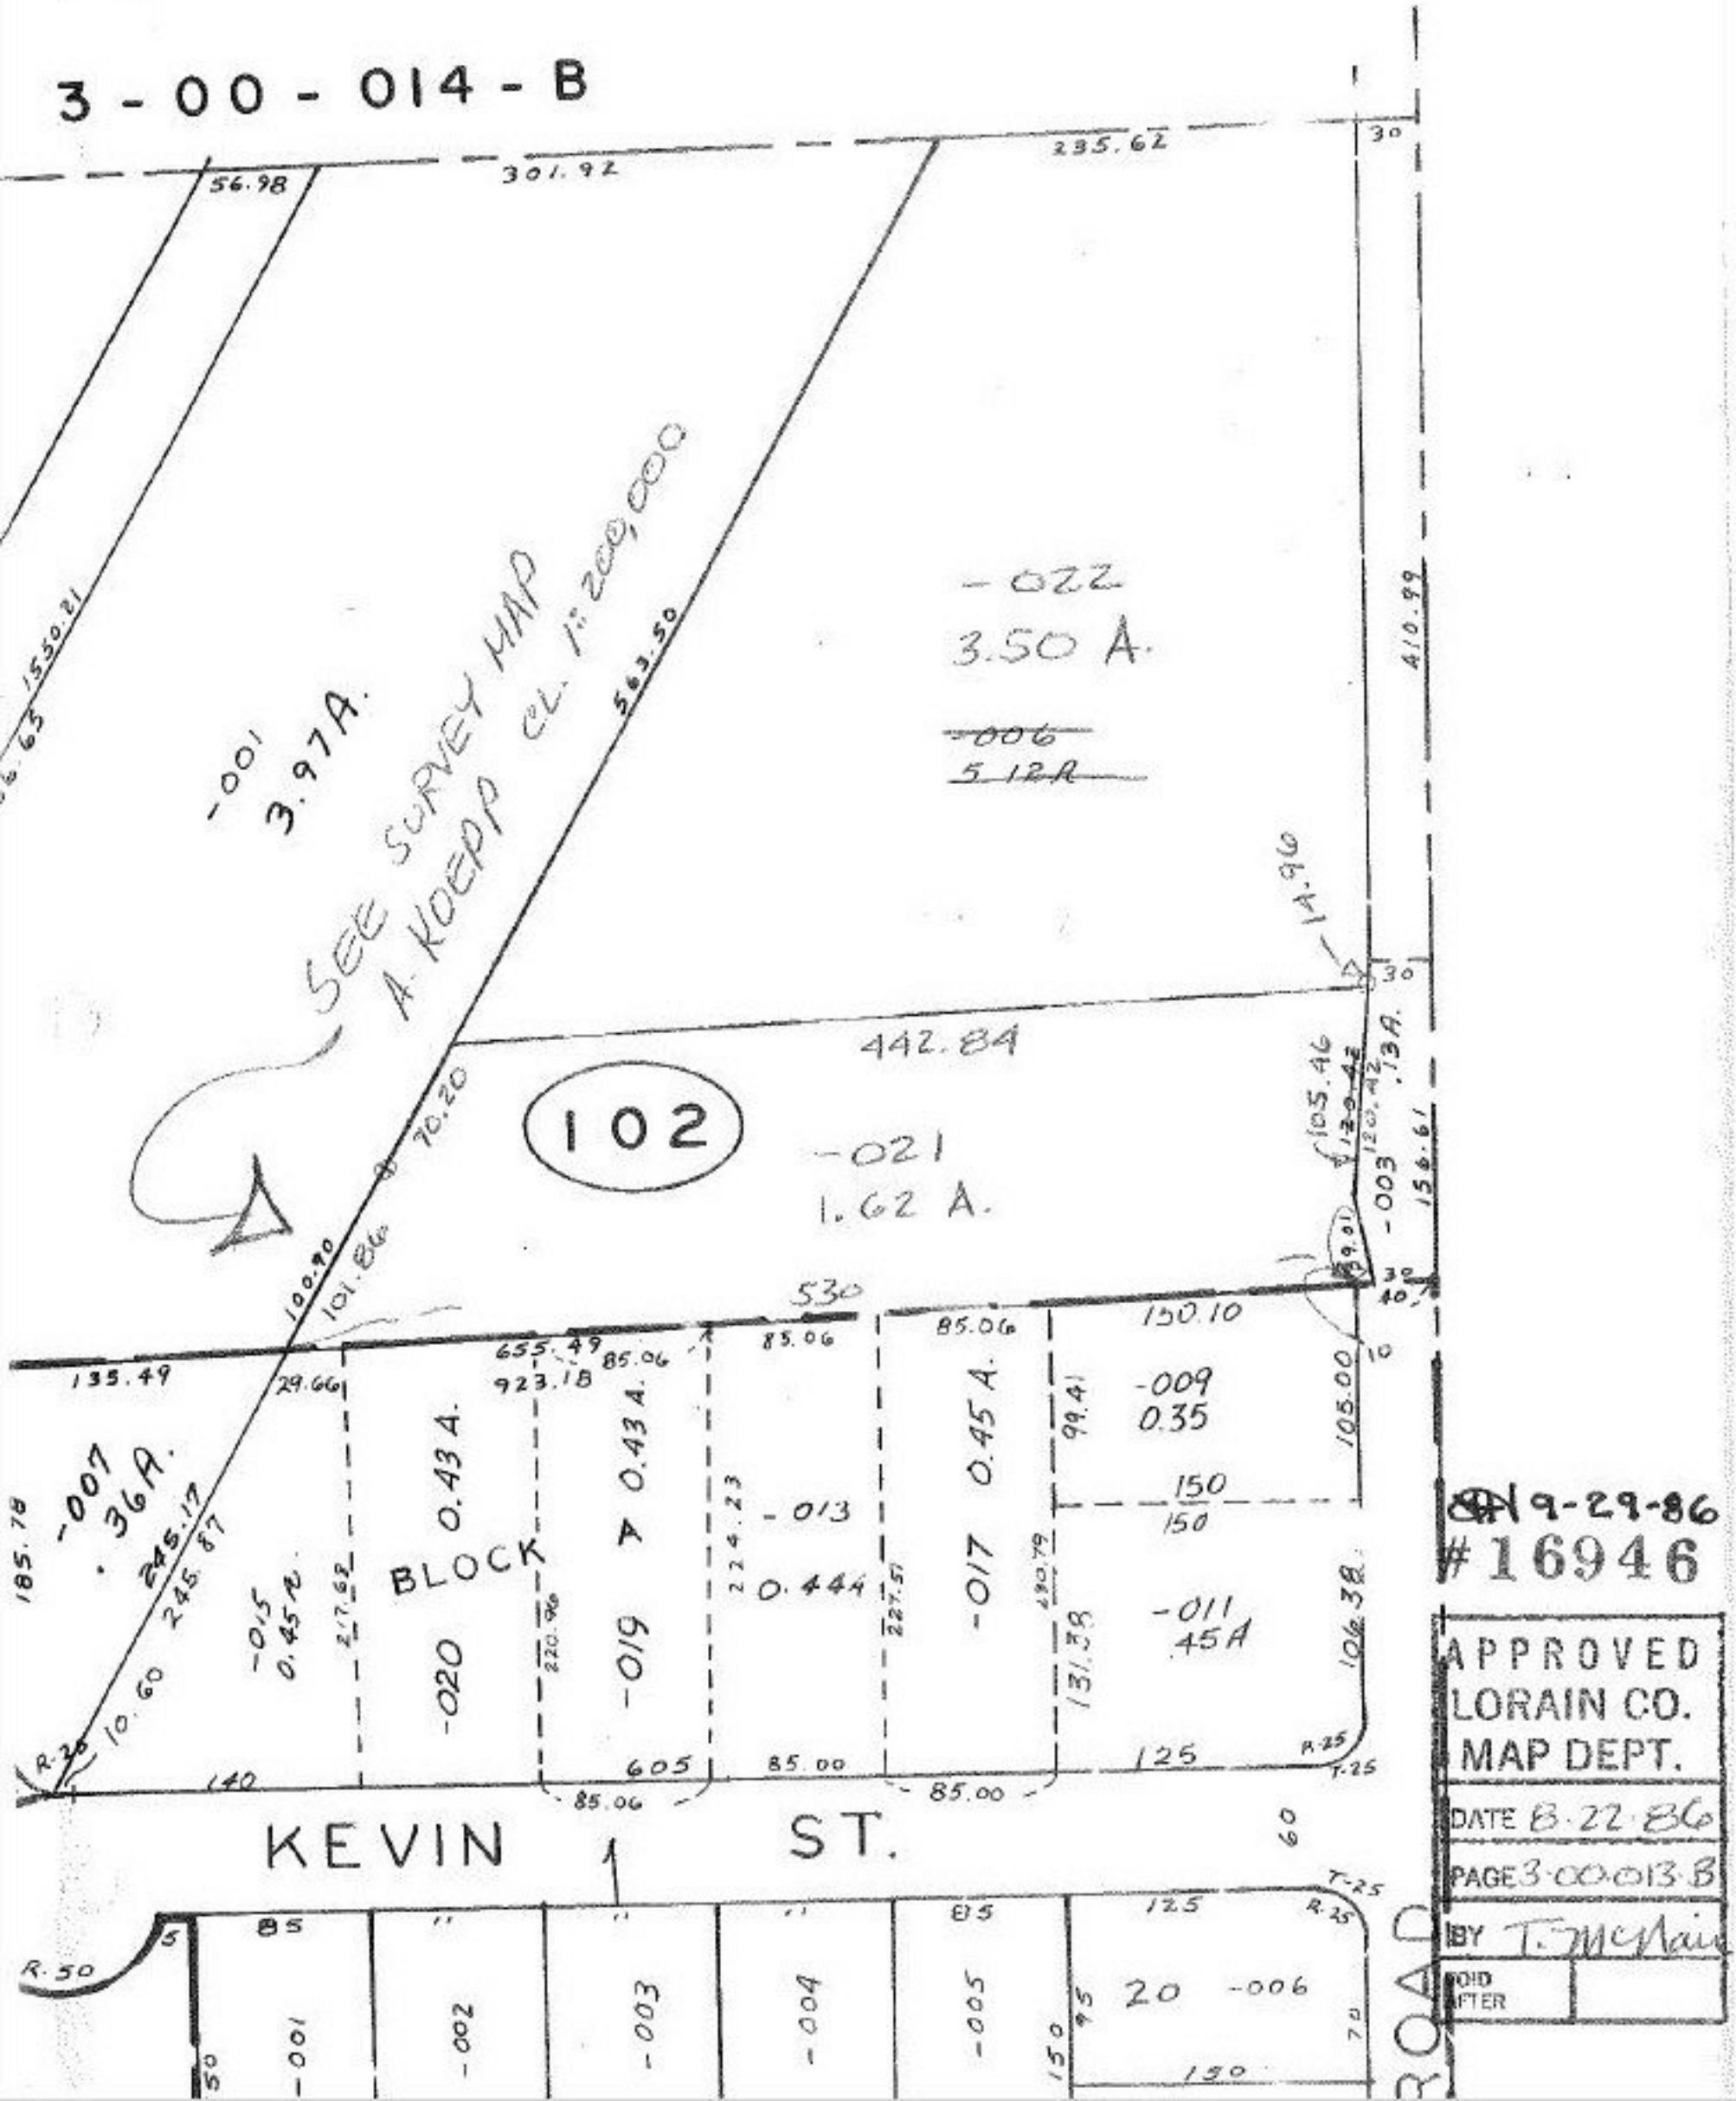
3-00-014-B
56.98
301.92
235.62
30
1550.21
563.50
-022
3.50 A.
~~-006~~
~~5.12A~~
410.99
-001
3.97A.
SEE SURVEY MAP
A. KOEPP CL. 1:200,000
14.96
442.84
102
-021
1.62 A.
70.20
100.90
101.86
105.46
-003
156.61
530
150.10
135.49
29.66
655.49
923.18
85.06
-007
.36A.
245.17
245.87
185.78
10.60
-015
0.45A.
BLOCK
-020
0.43 A.
-019
0.43 A.
-013
0.44A
-017
0.45 A.
-009
0.35
99.41
150
-011
.45A
131.38
106.38
105.00
140
605
85.00
125
KEVIN ST.
R.50
85
-001
-002
-003
-004
-005
20
-006
ROAD
9-29-86
#16946
APPROVED
LORAIN CO.
MAP DEPT.
DATE 8.22.86
PAGE 3-00-013-B
BY T. McNair
VOID
AFTER