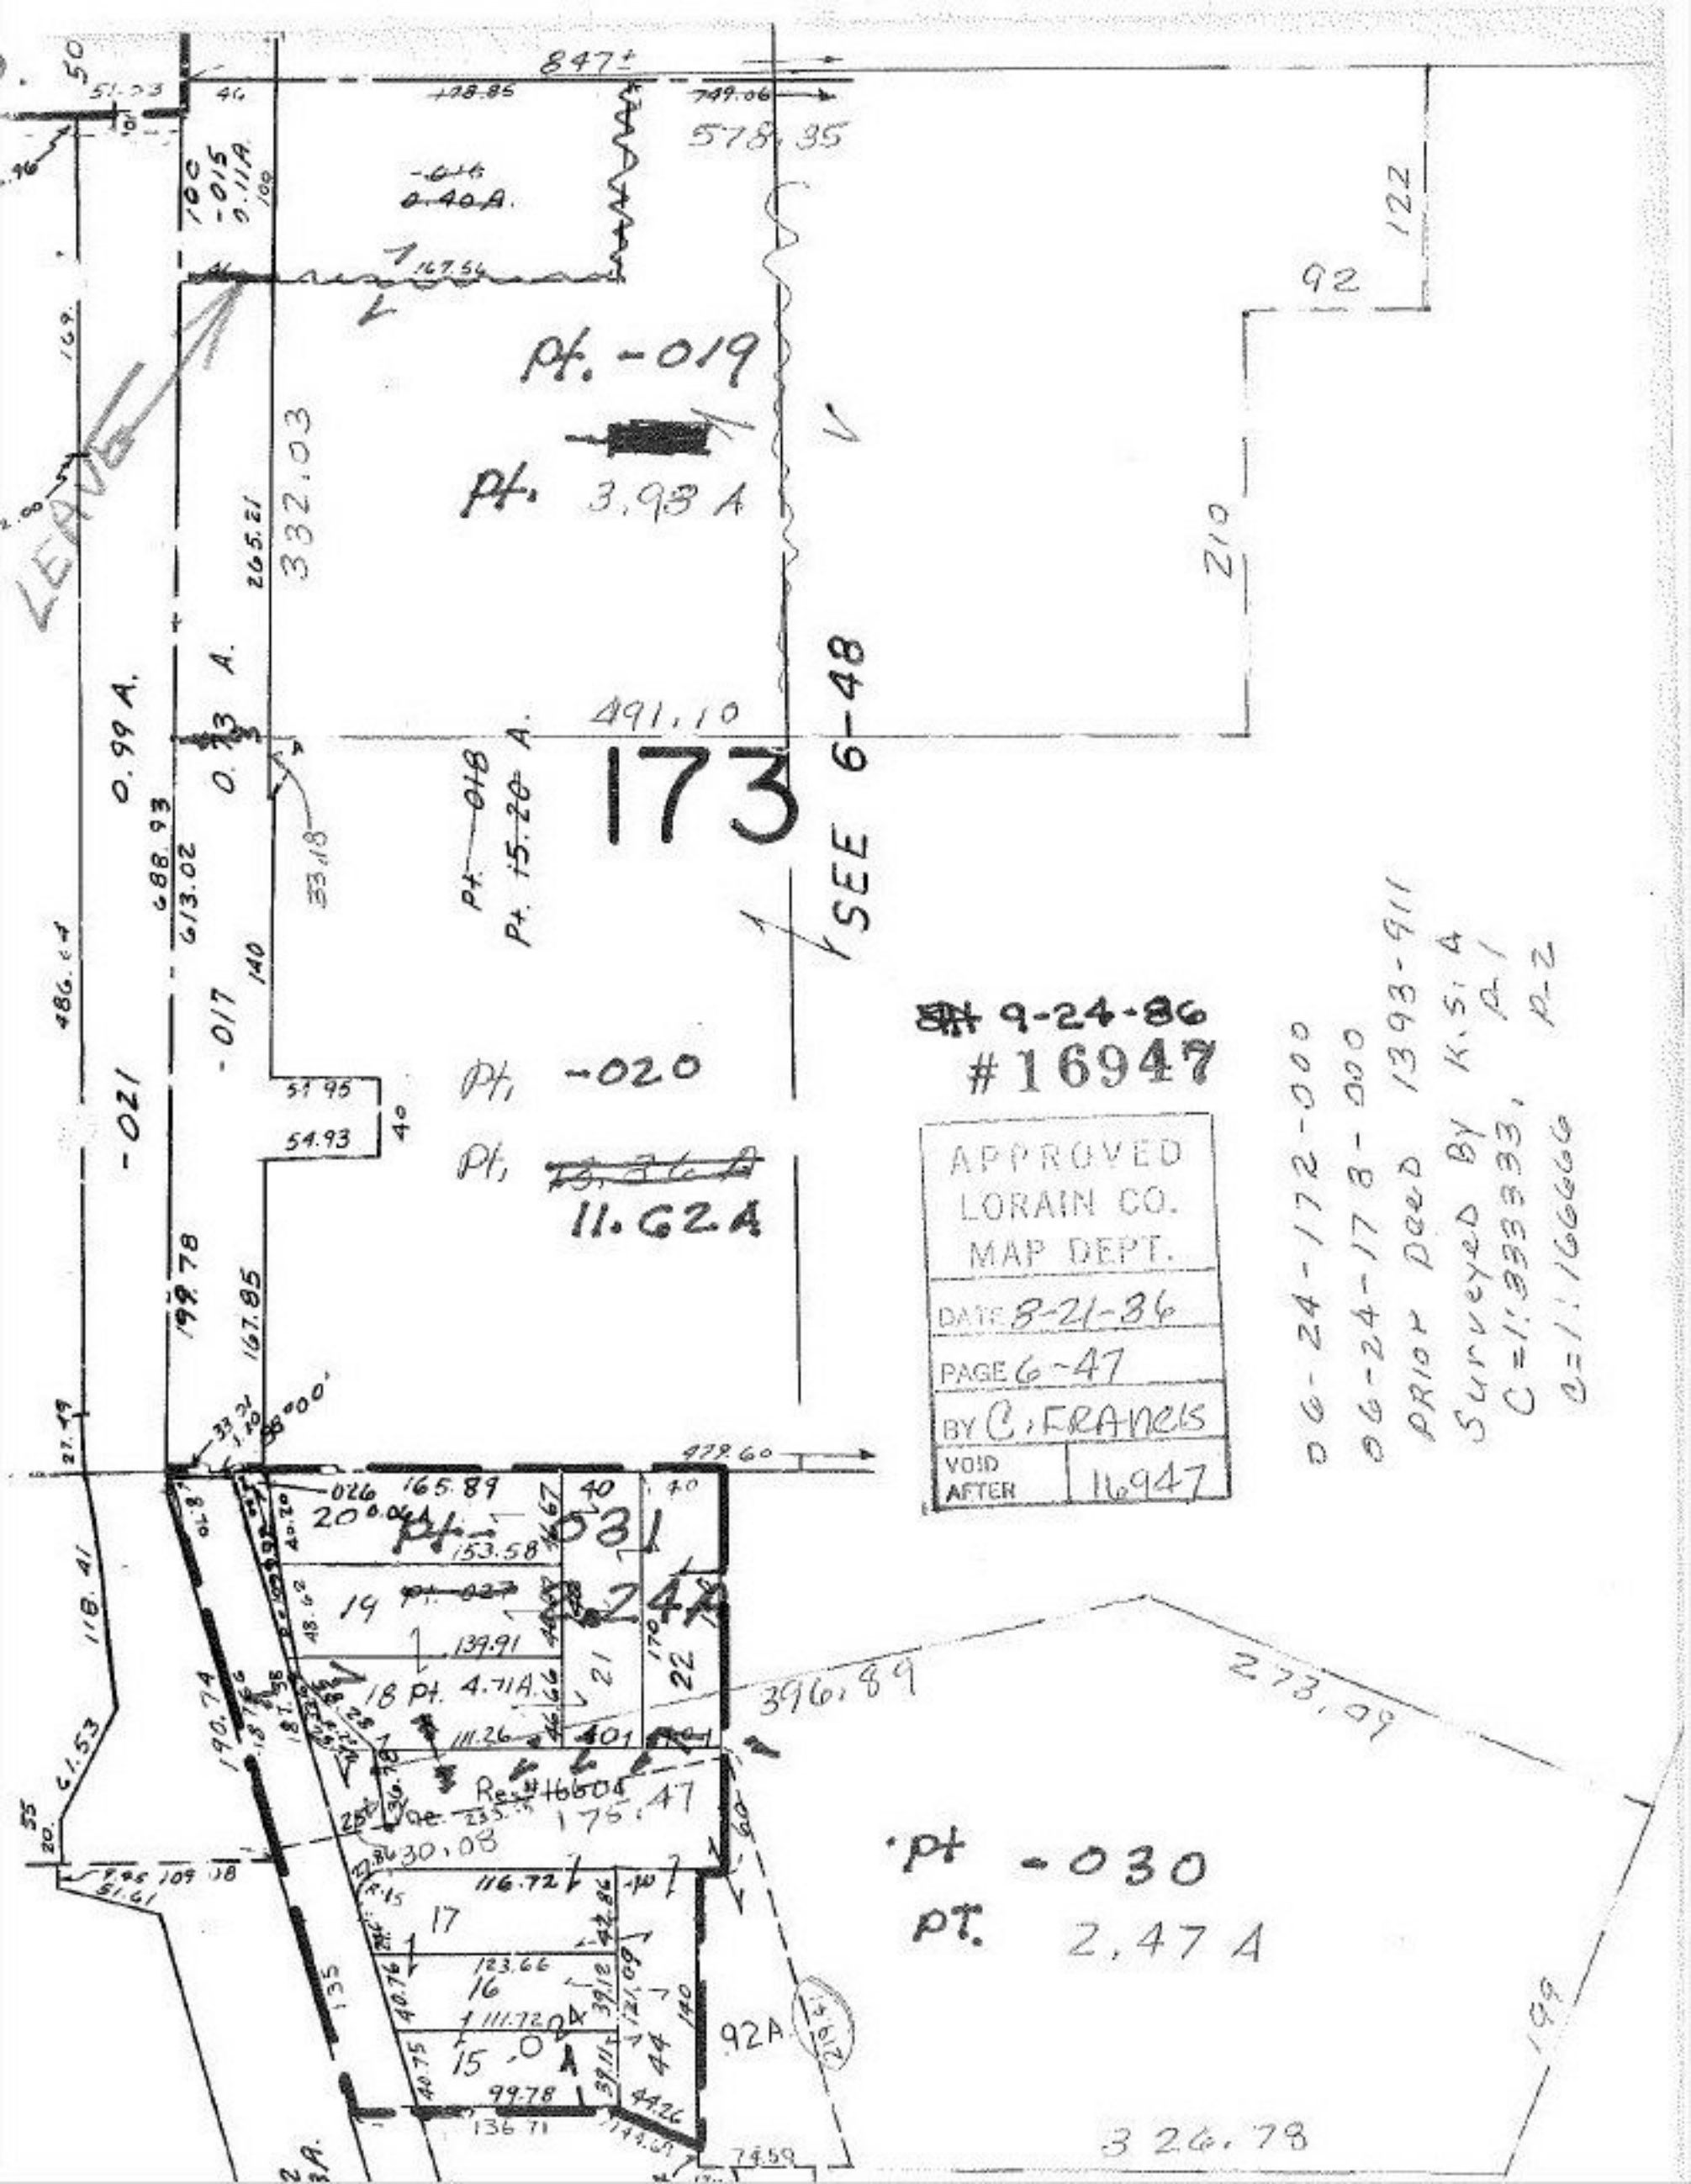

9-24-86
#16947

APPROVED
LORAIN CO.
MAP DEPT.
DATE 8-21-86
PAGE 6-47
BY C. FRANCIS
VOID AFTER 16947

06-24-172-000
06-24-178-000
PRIOR DEED 1393-911
SURVEYED BY K.S.A
C=1:333333, P-1
C=1:166666 P-2