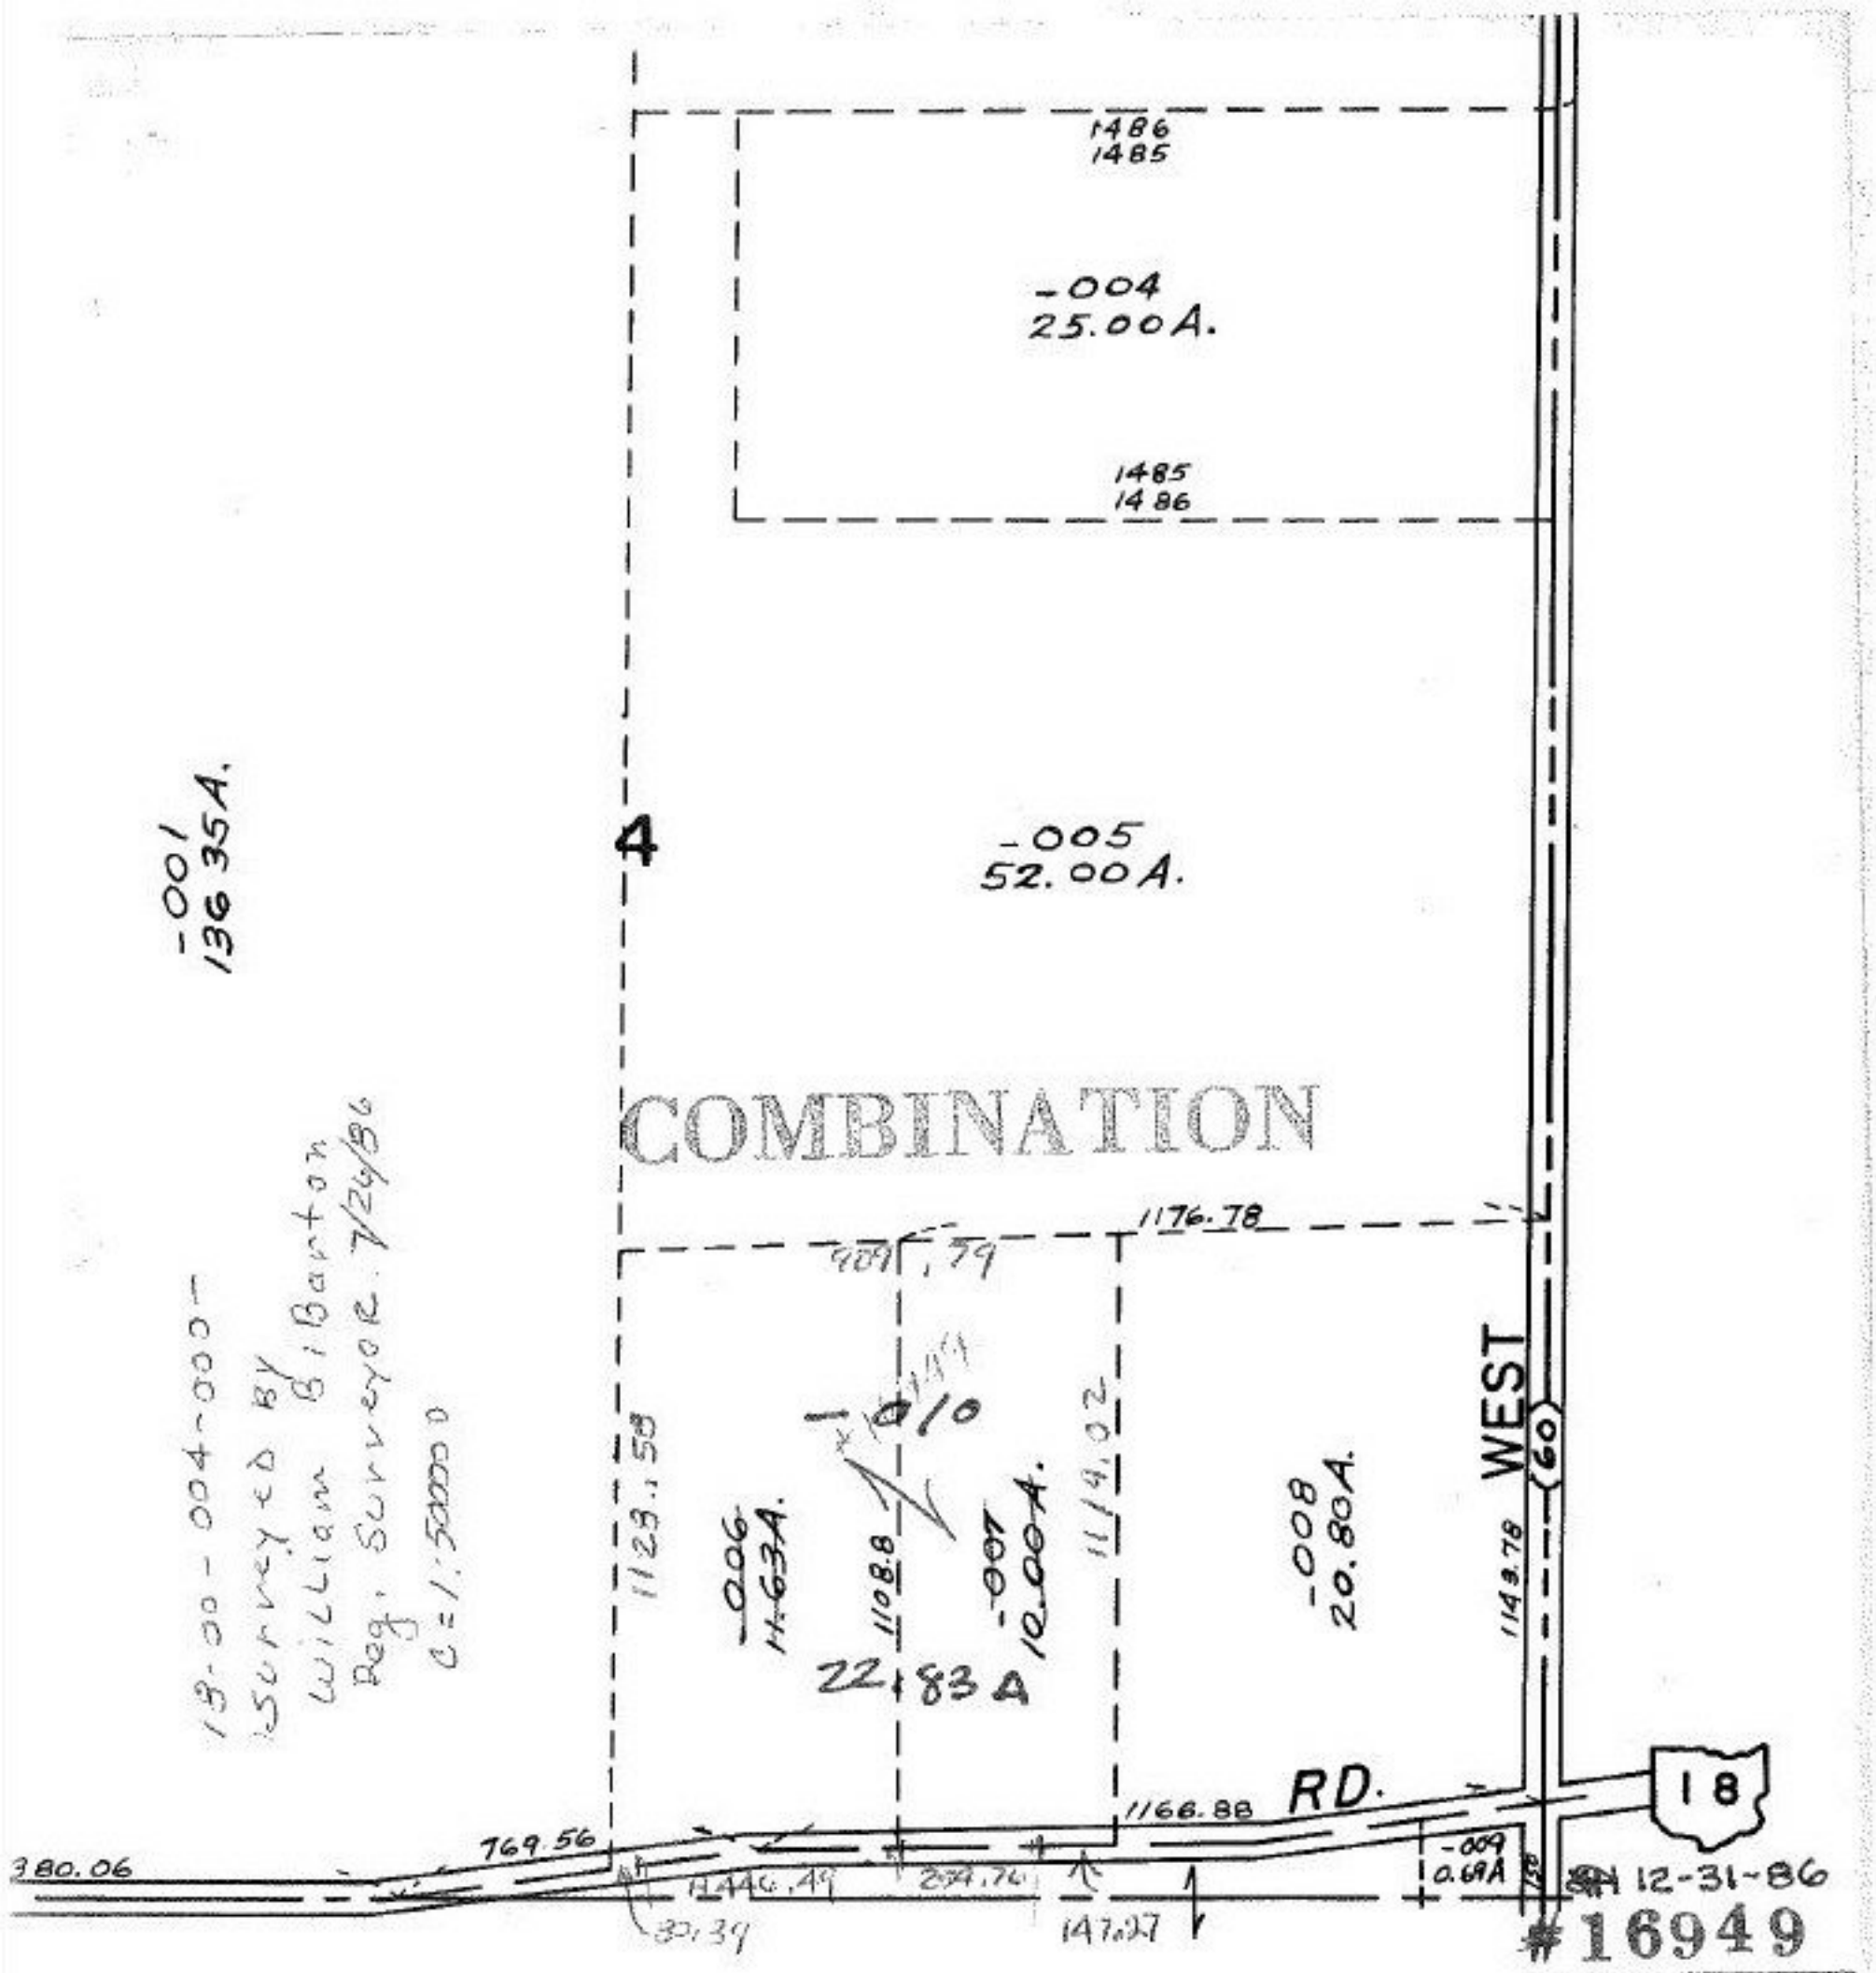

APPROVED
LORAIN CO.
MAP DEPT.

DATE 8-21-86

PAGE 18-D

BY C. FRANCIS

VOID AFTER 16949