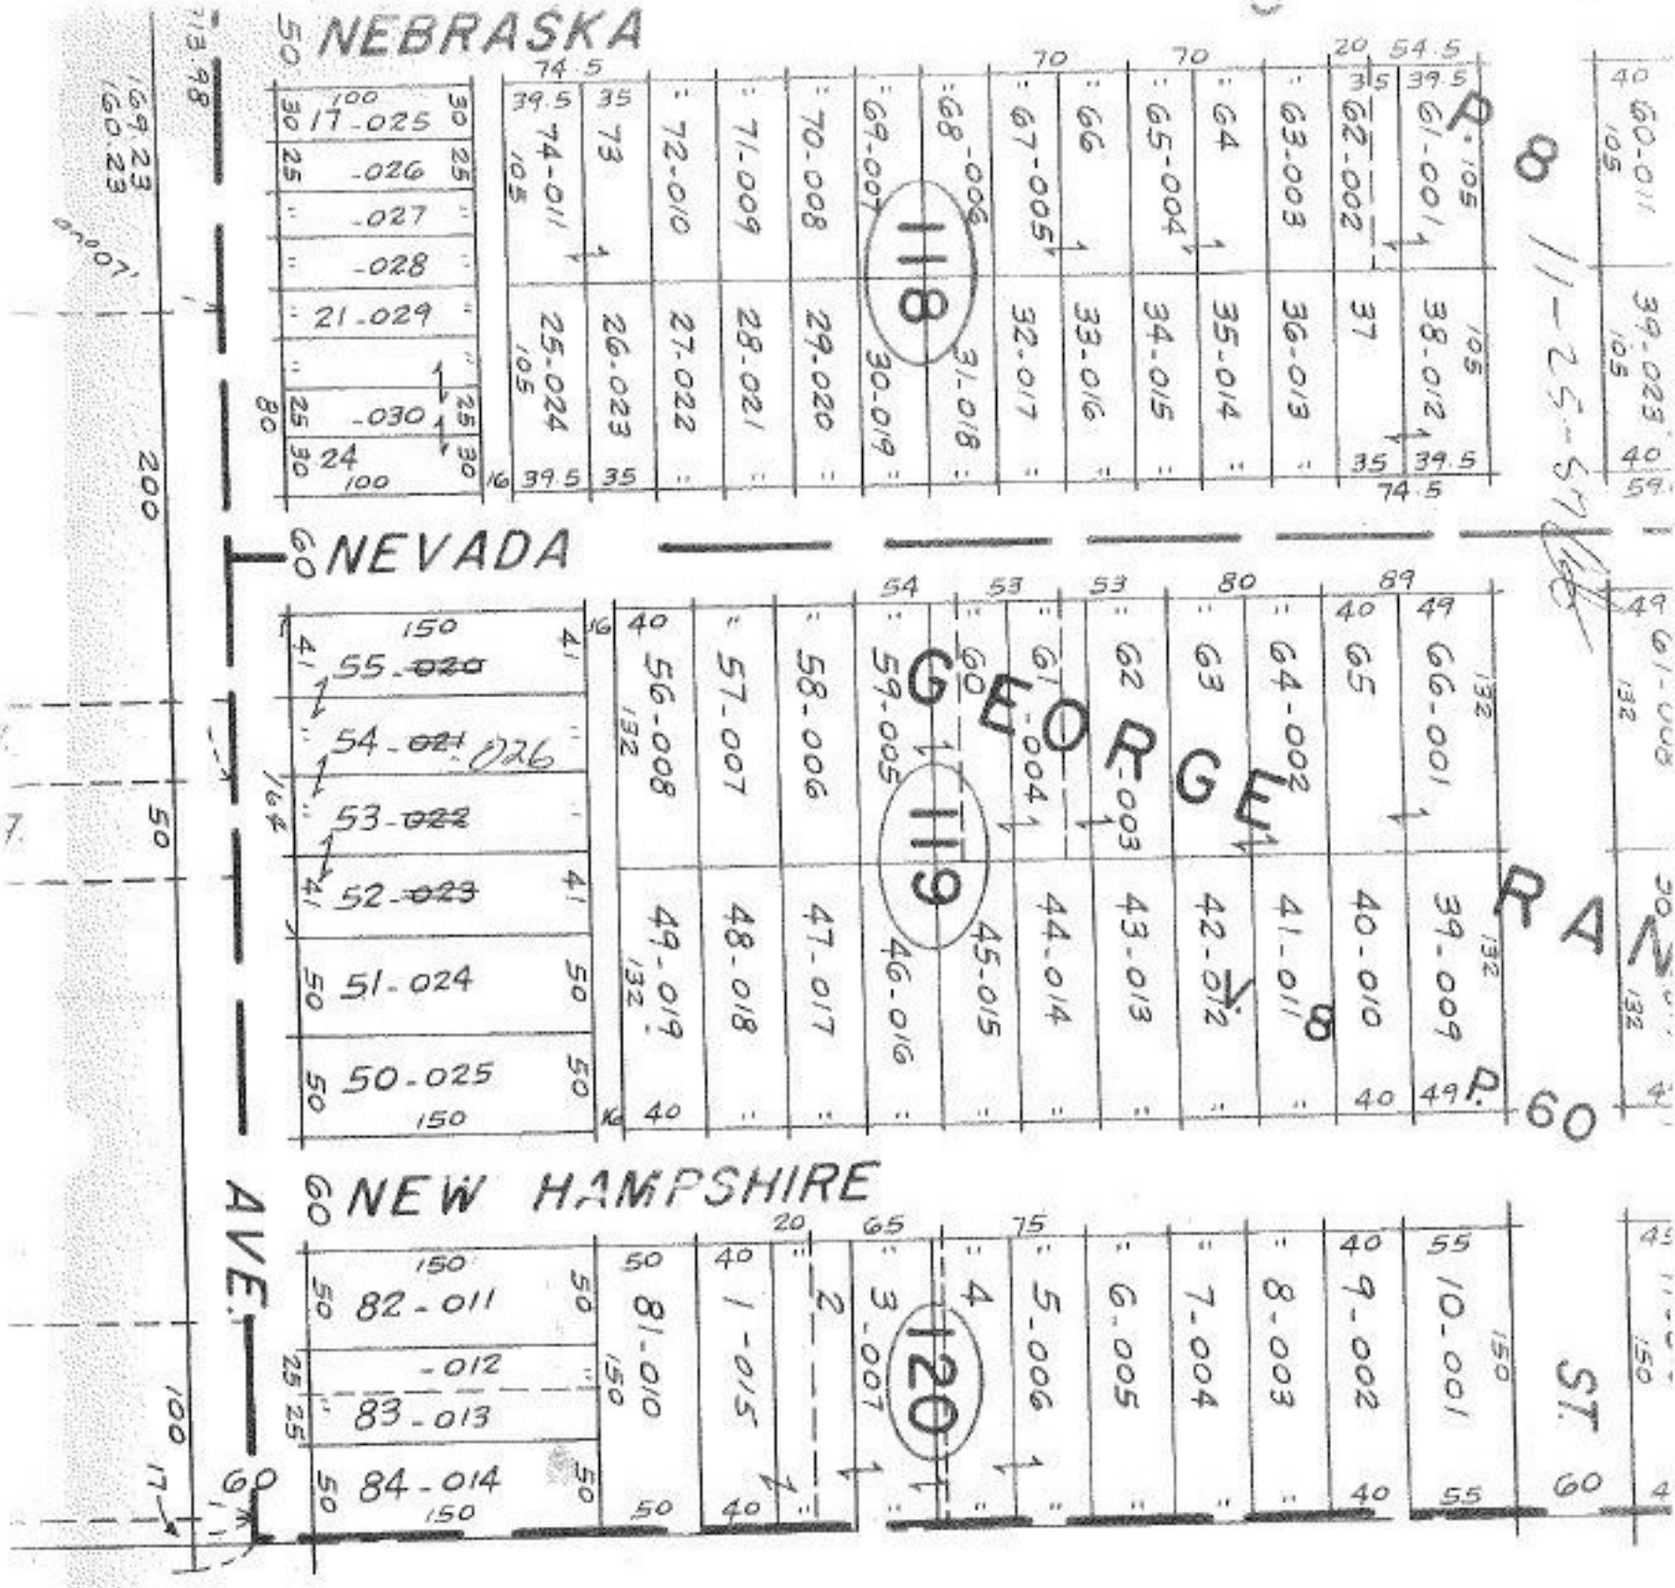

7-21-86
S.S

APPROVED
LORAIN CO.
MAP DEPT.
DATE 4-23-68
3-00-055-A
BY

1695

1695

Done 7-6-68

LW Hall