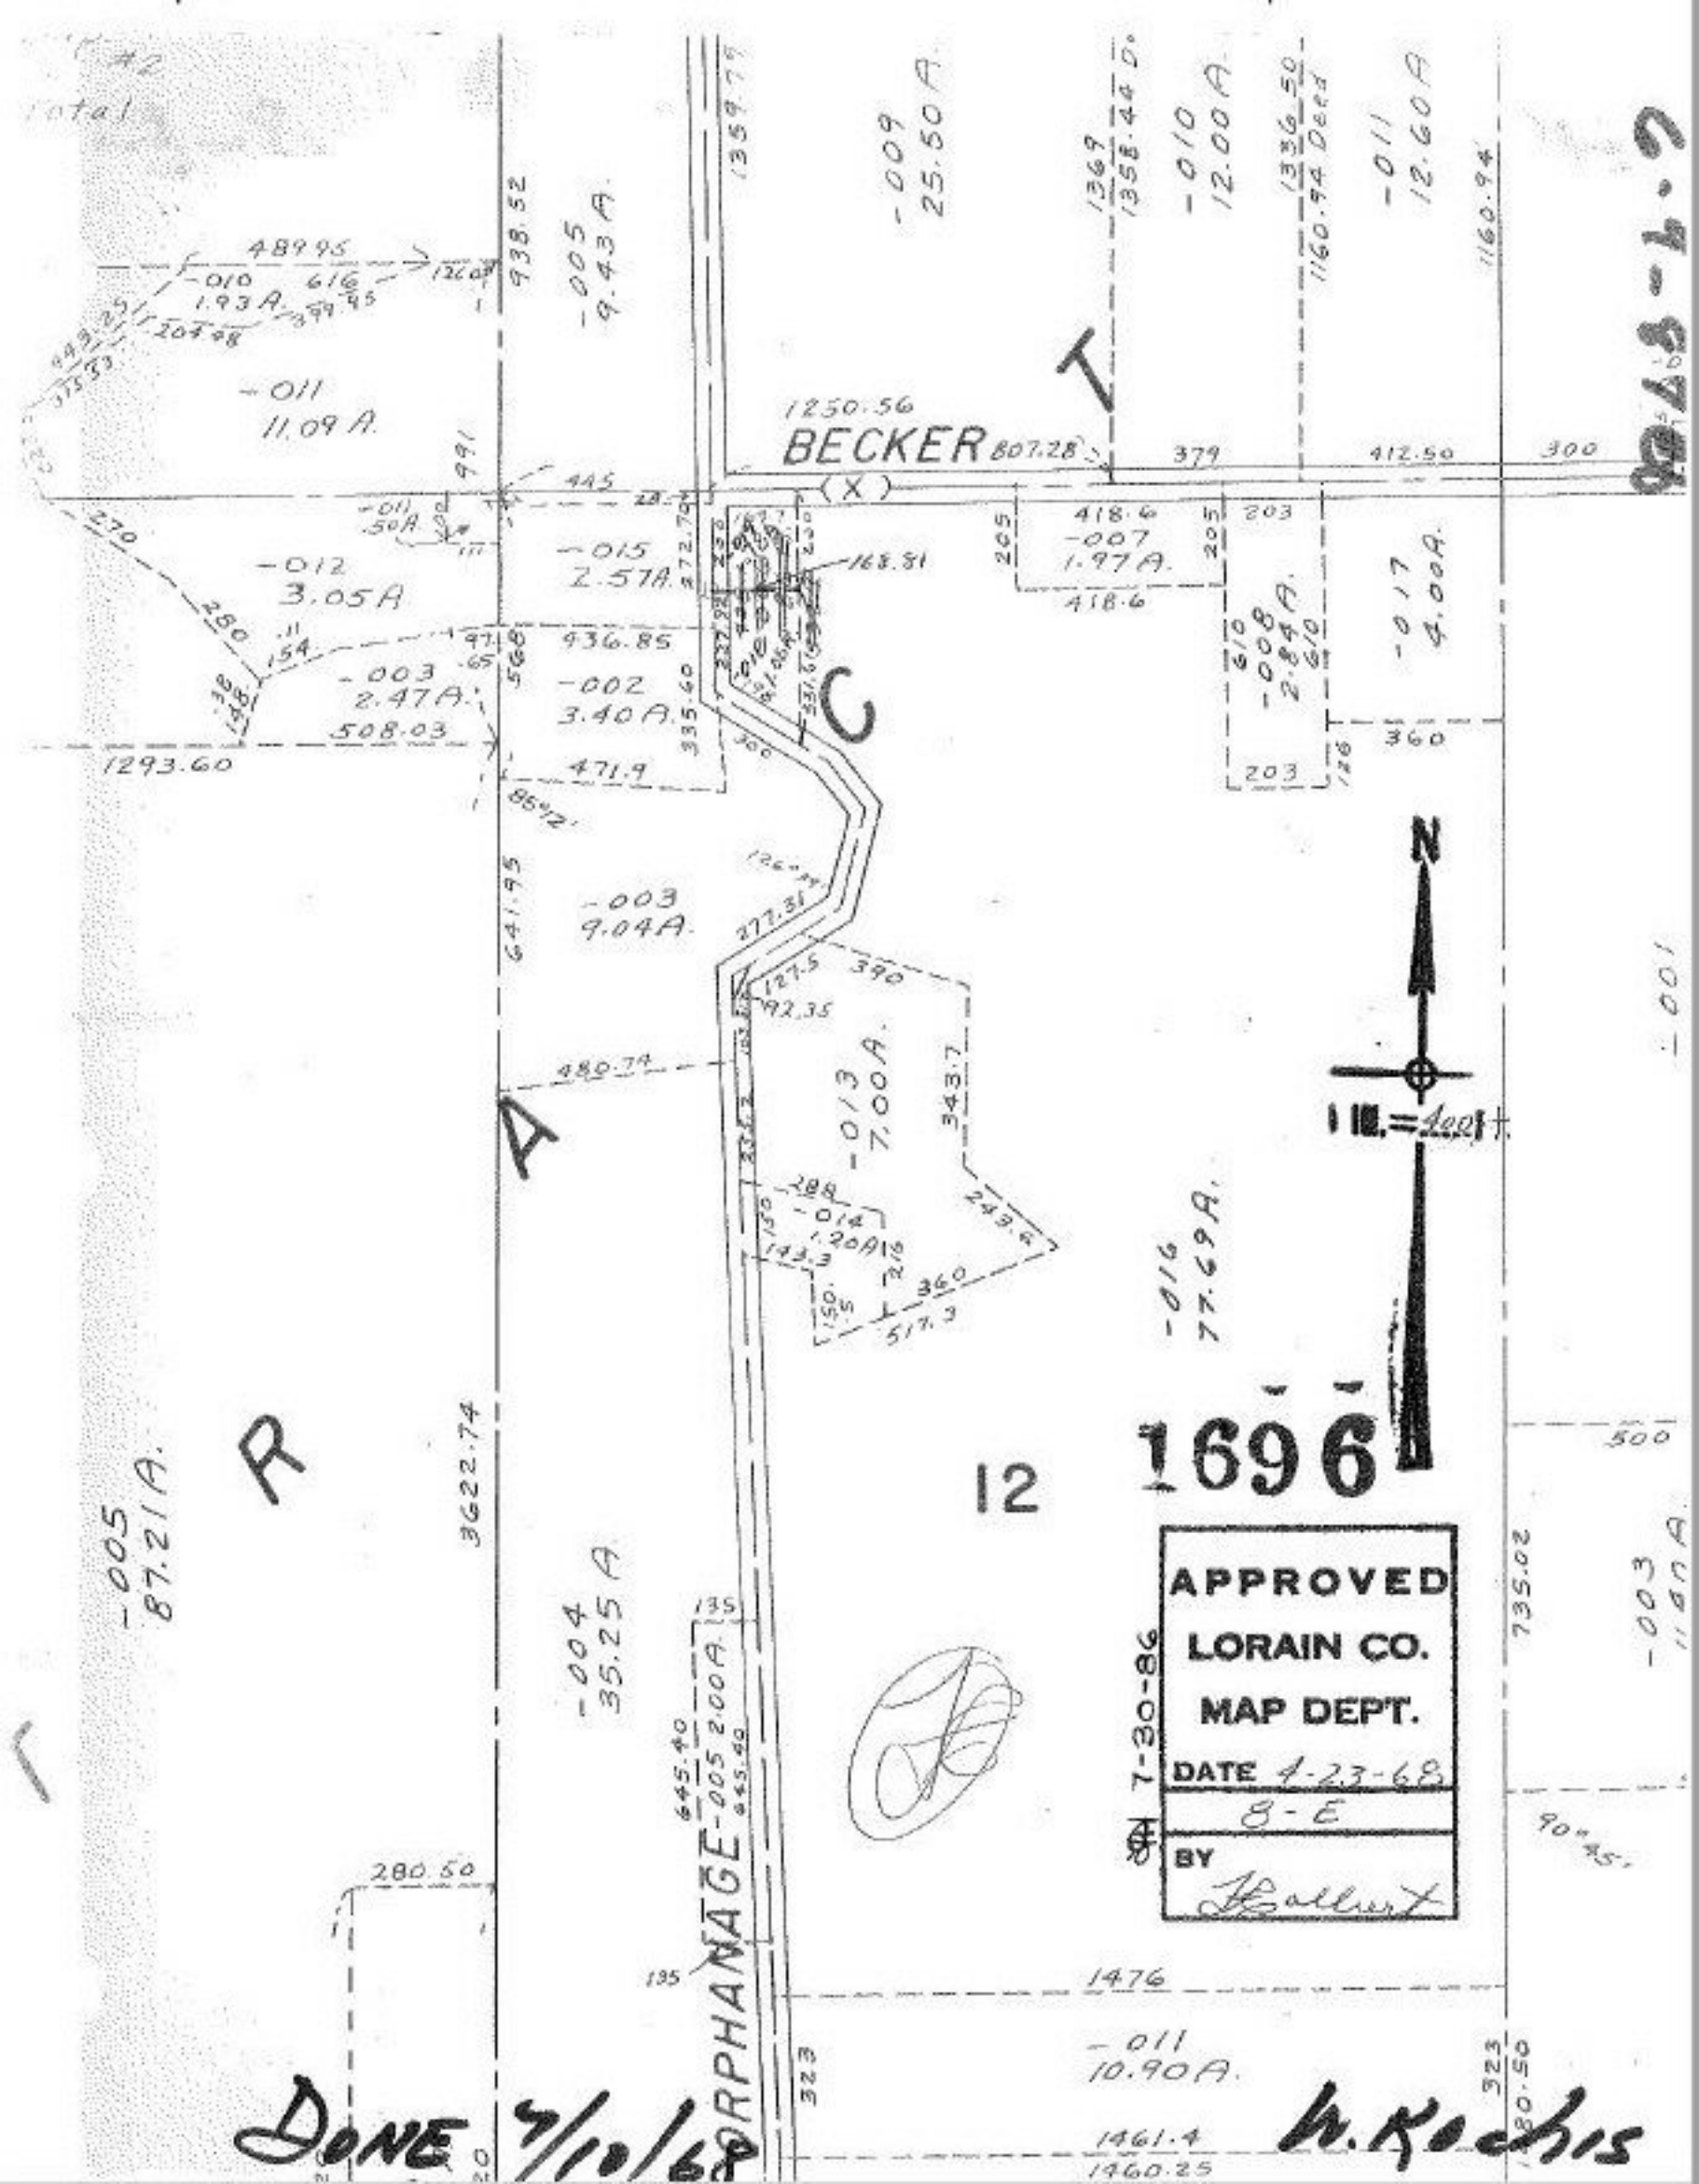

BECKER
ORPHANAGE
12
1696
APPROVED
LORAIN CO.
MAP DEPT.
DATE 4-23-68
8-E
BY
7-30-86
DONE 7/10/68
W. Kochis