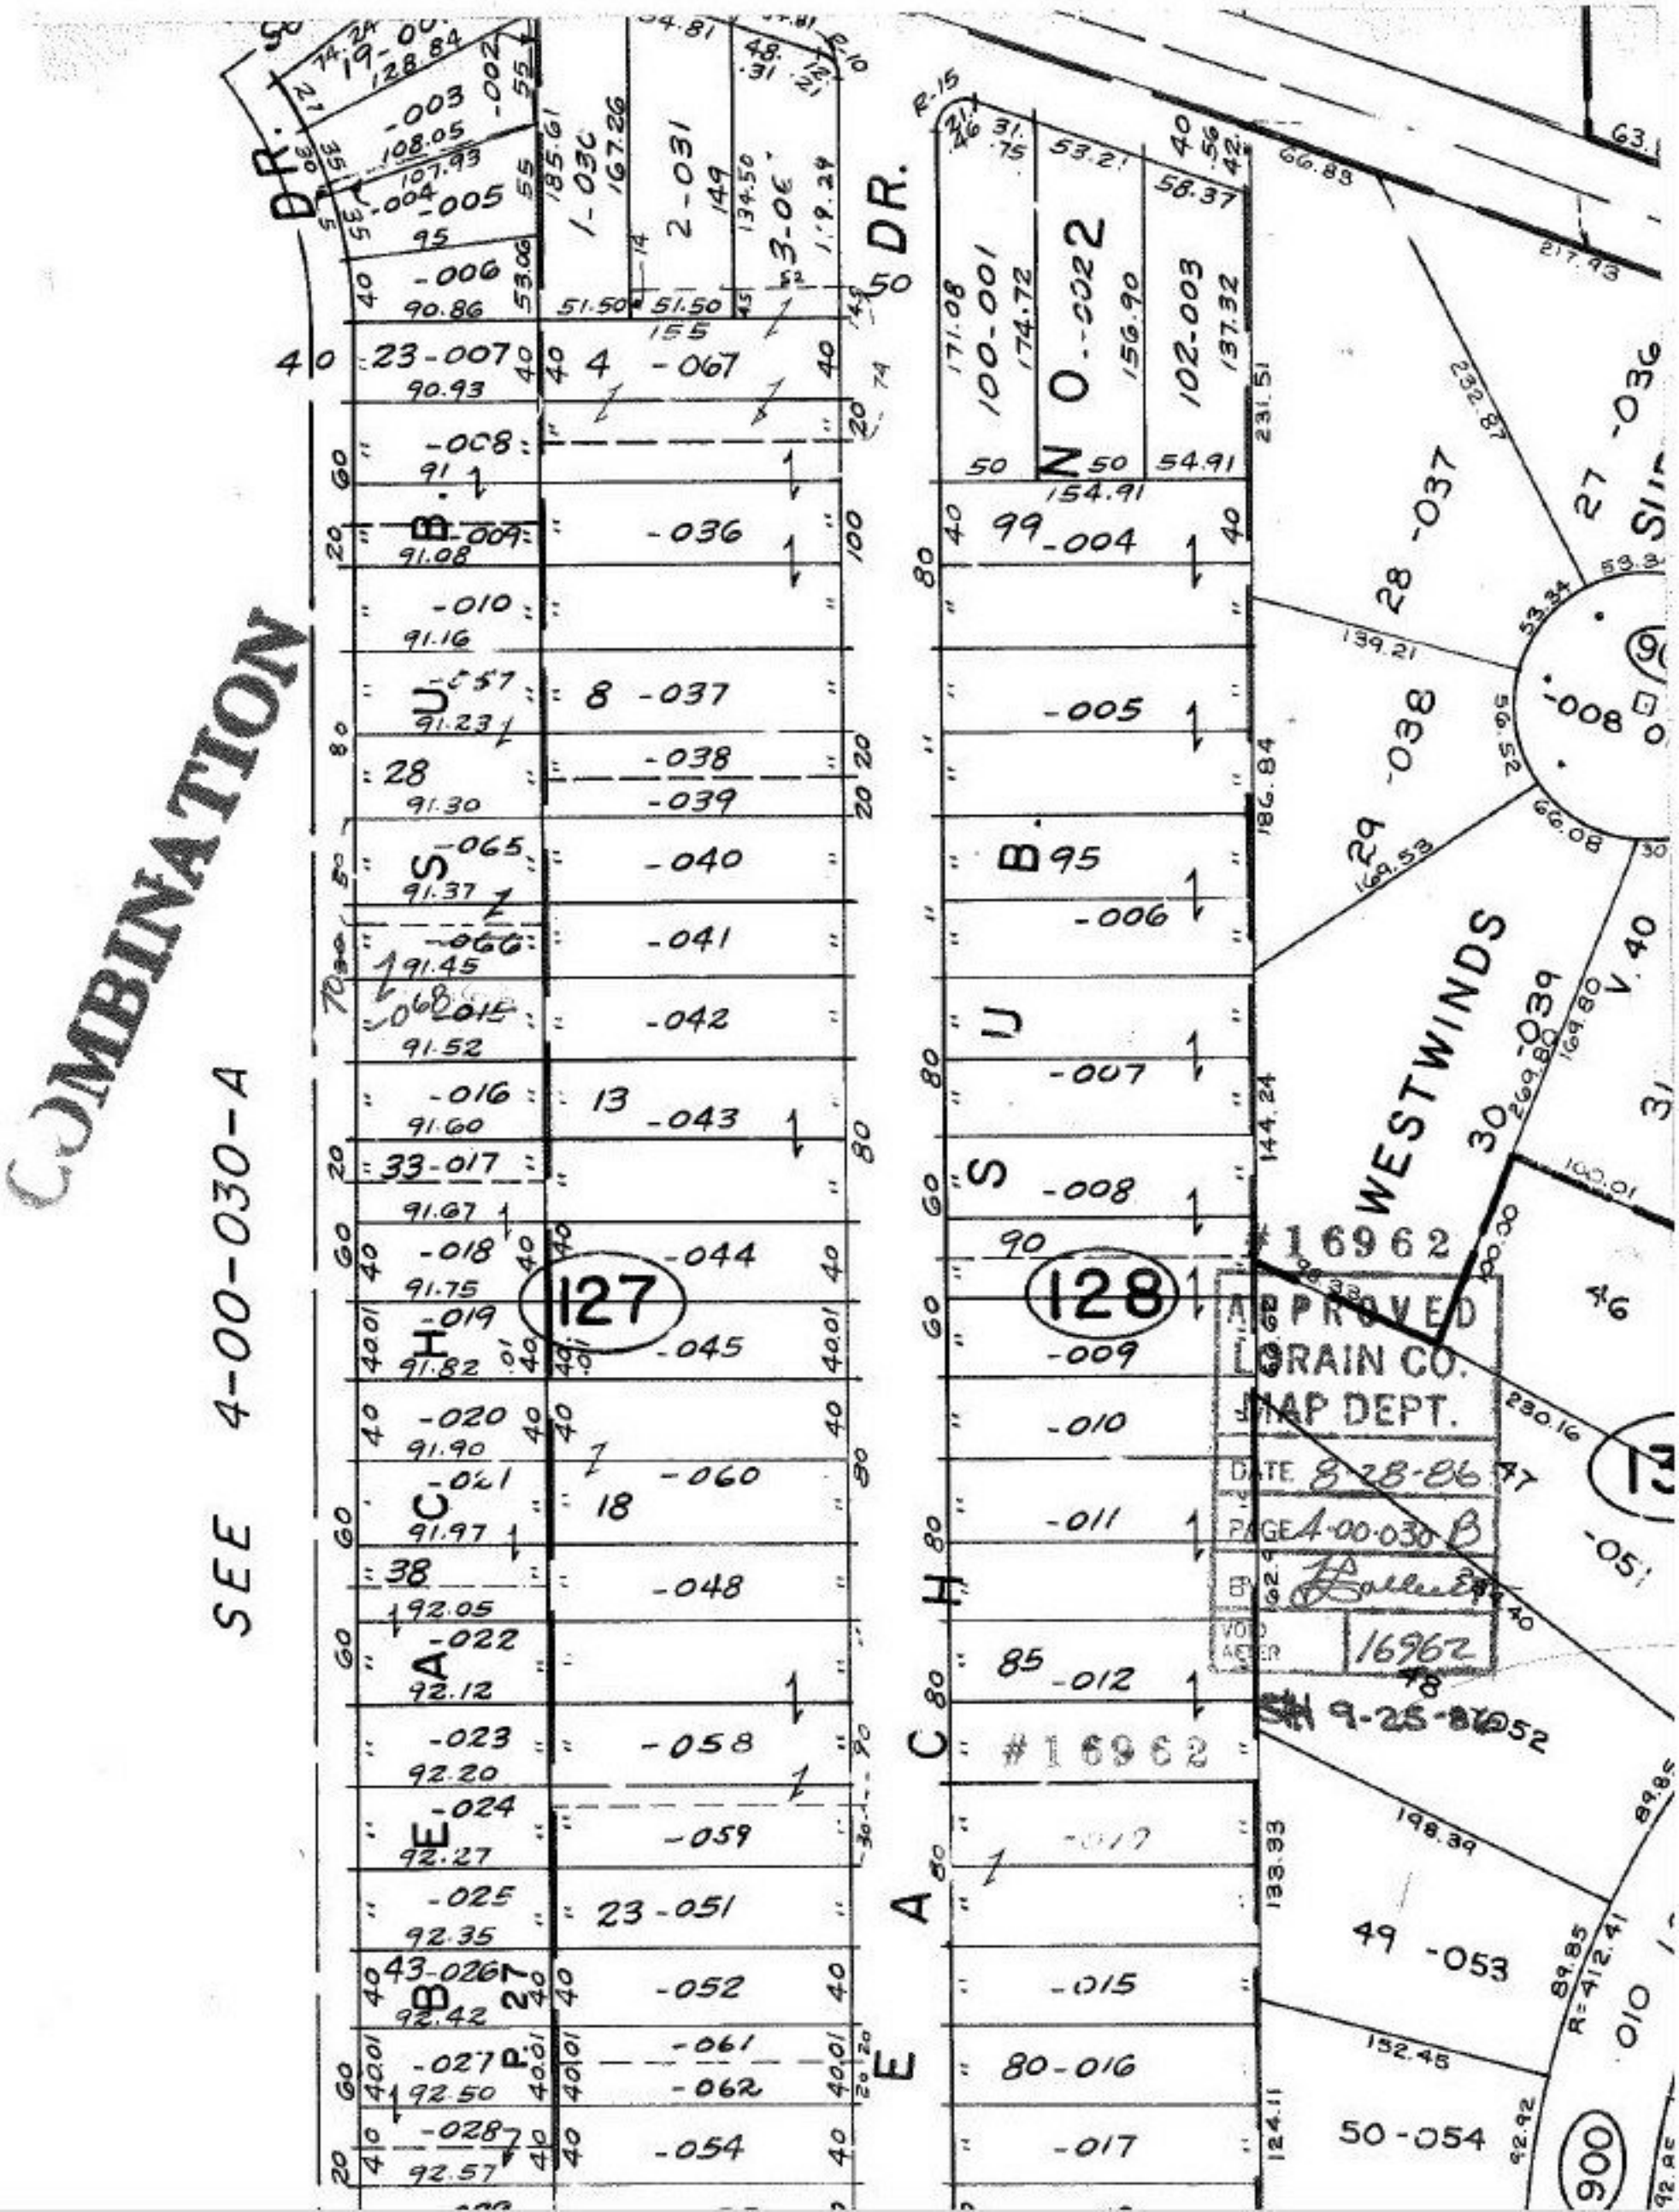
COMBINATION
SEE 4-00-030-A
DR.
DR.
127
128
WESTWINDS
#16962
APPROVED
LORAIN CO.
MAP DEPT.
DATE 8-28-86
PAGE 4-00-030 B
VOID AFTER 16962
9-25-86
#16962
#16962
49 -053
50-054
900