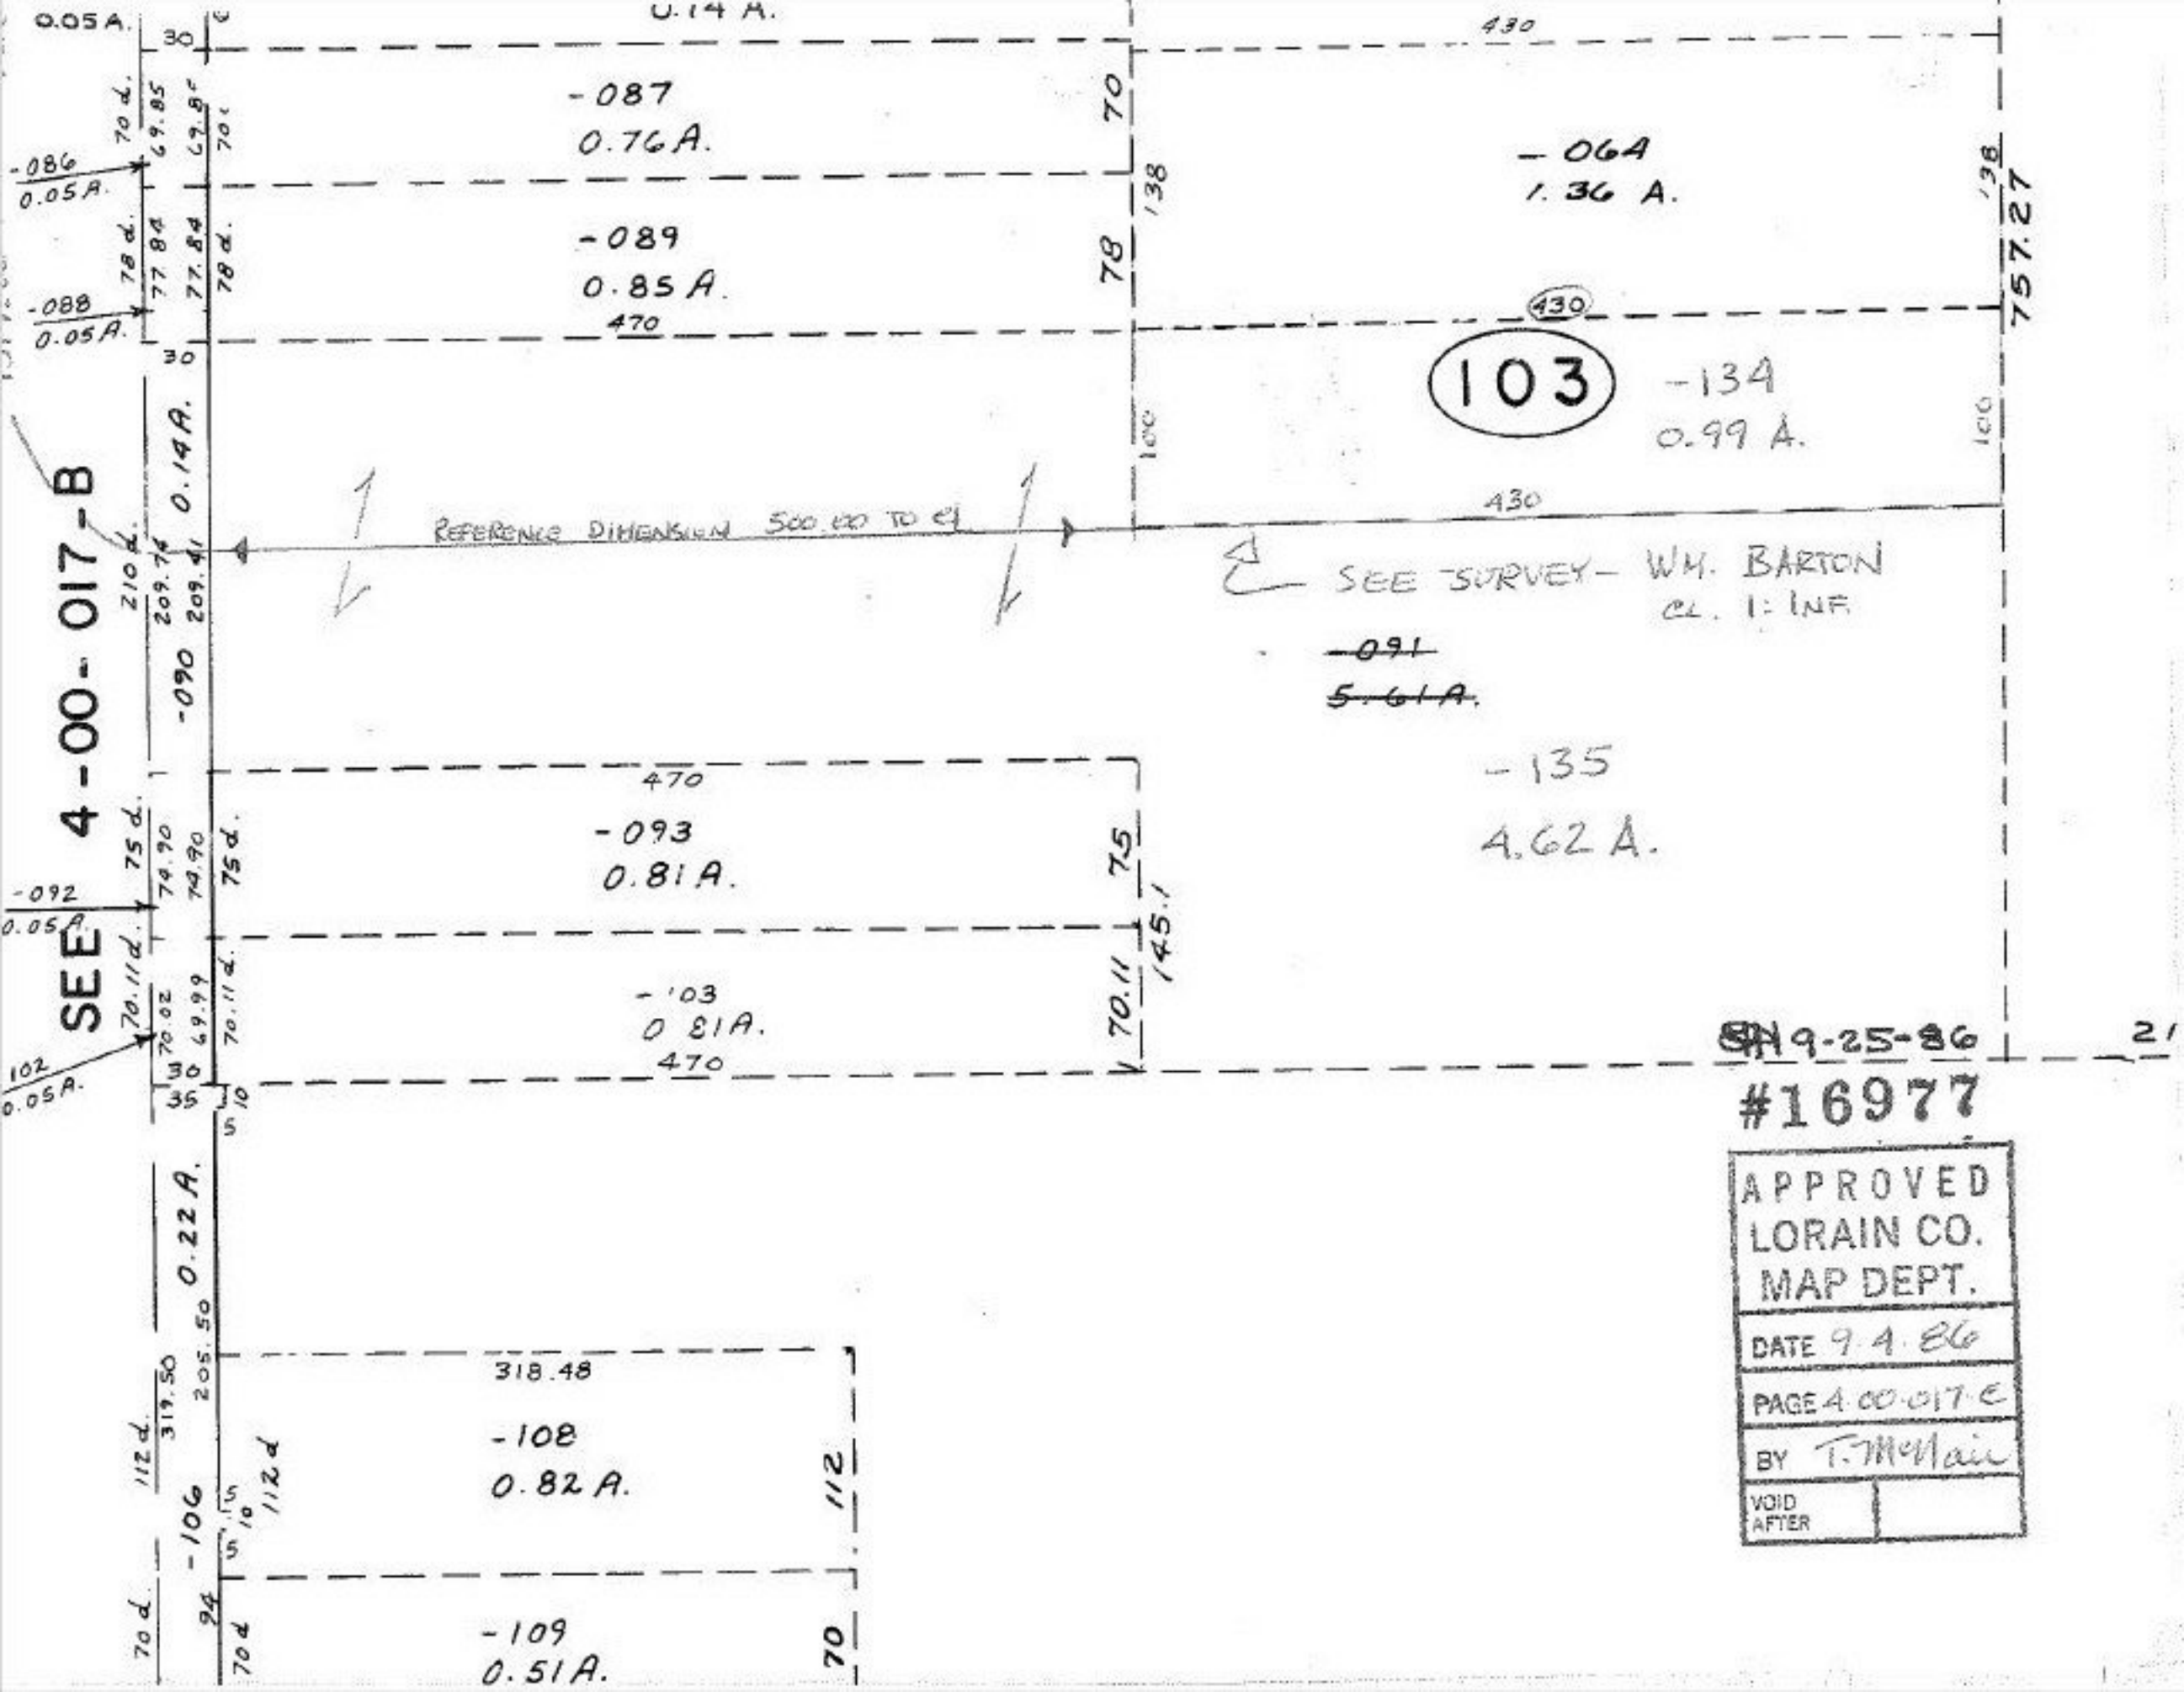

0.05 A.
0.14 A.
430
-087
0.76 A.
70
-064
1.36 A.
138
757.27
-086
0.05 A.
-089
0.85 A.
78
-088
0.05 A.
470
430
103
-134
0.99 A.
100
0.14 A.
REFERENCE DIMENSION 500.00 TO ℄
430
SEE SURVEY - WM. BARTON
CL. 1: INF.
-091
5.61 A.
SEE 4-00-017-B
-090
-135
4.62 A.
470
-093
0.81 A.
75
145.1
-092
0.05 A.
-103
0.81 A.
70.11
102
0.05 A.
470
9-25-86
21
#16977
0.22 A.
318.48
-108
0.82 A.
112
-106
-109
0.51 A.
70
APPROVED
LORAIN CO.
MAP DEPT.
DATE 9.4.86
PAGE 4.00.017.C
BY T. McNair
VOID AFTER