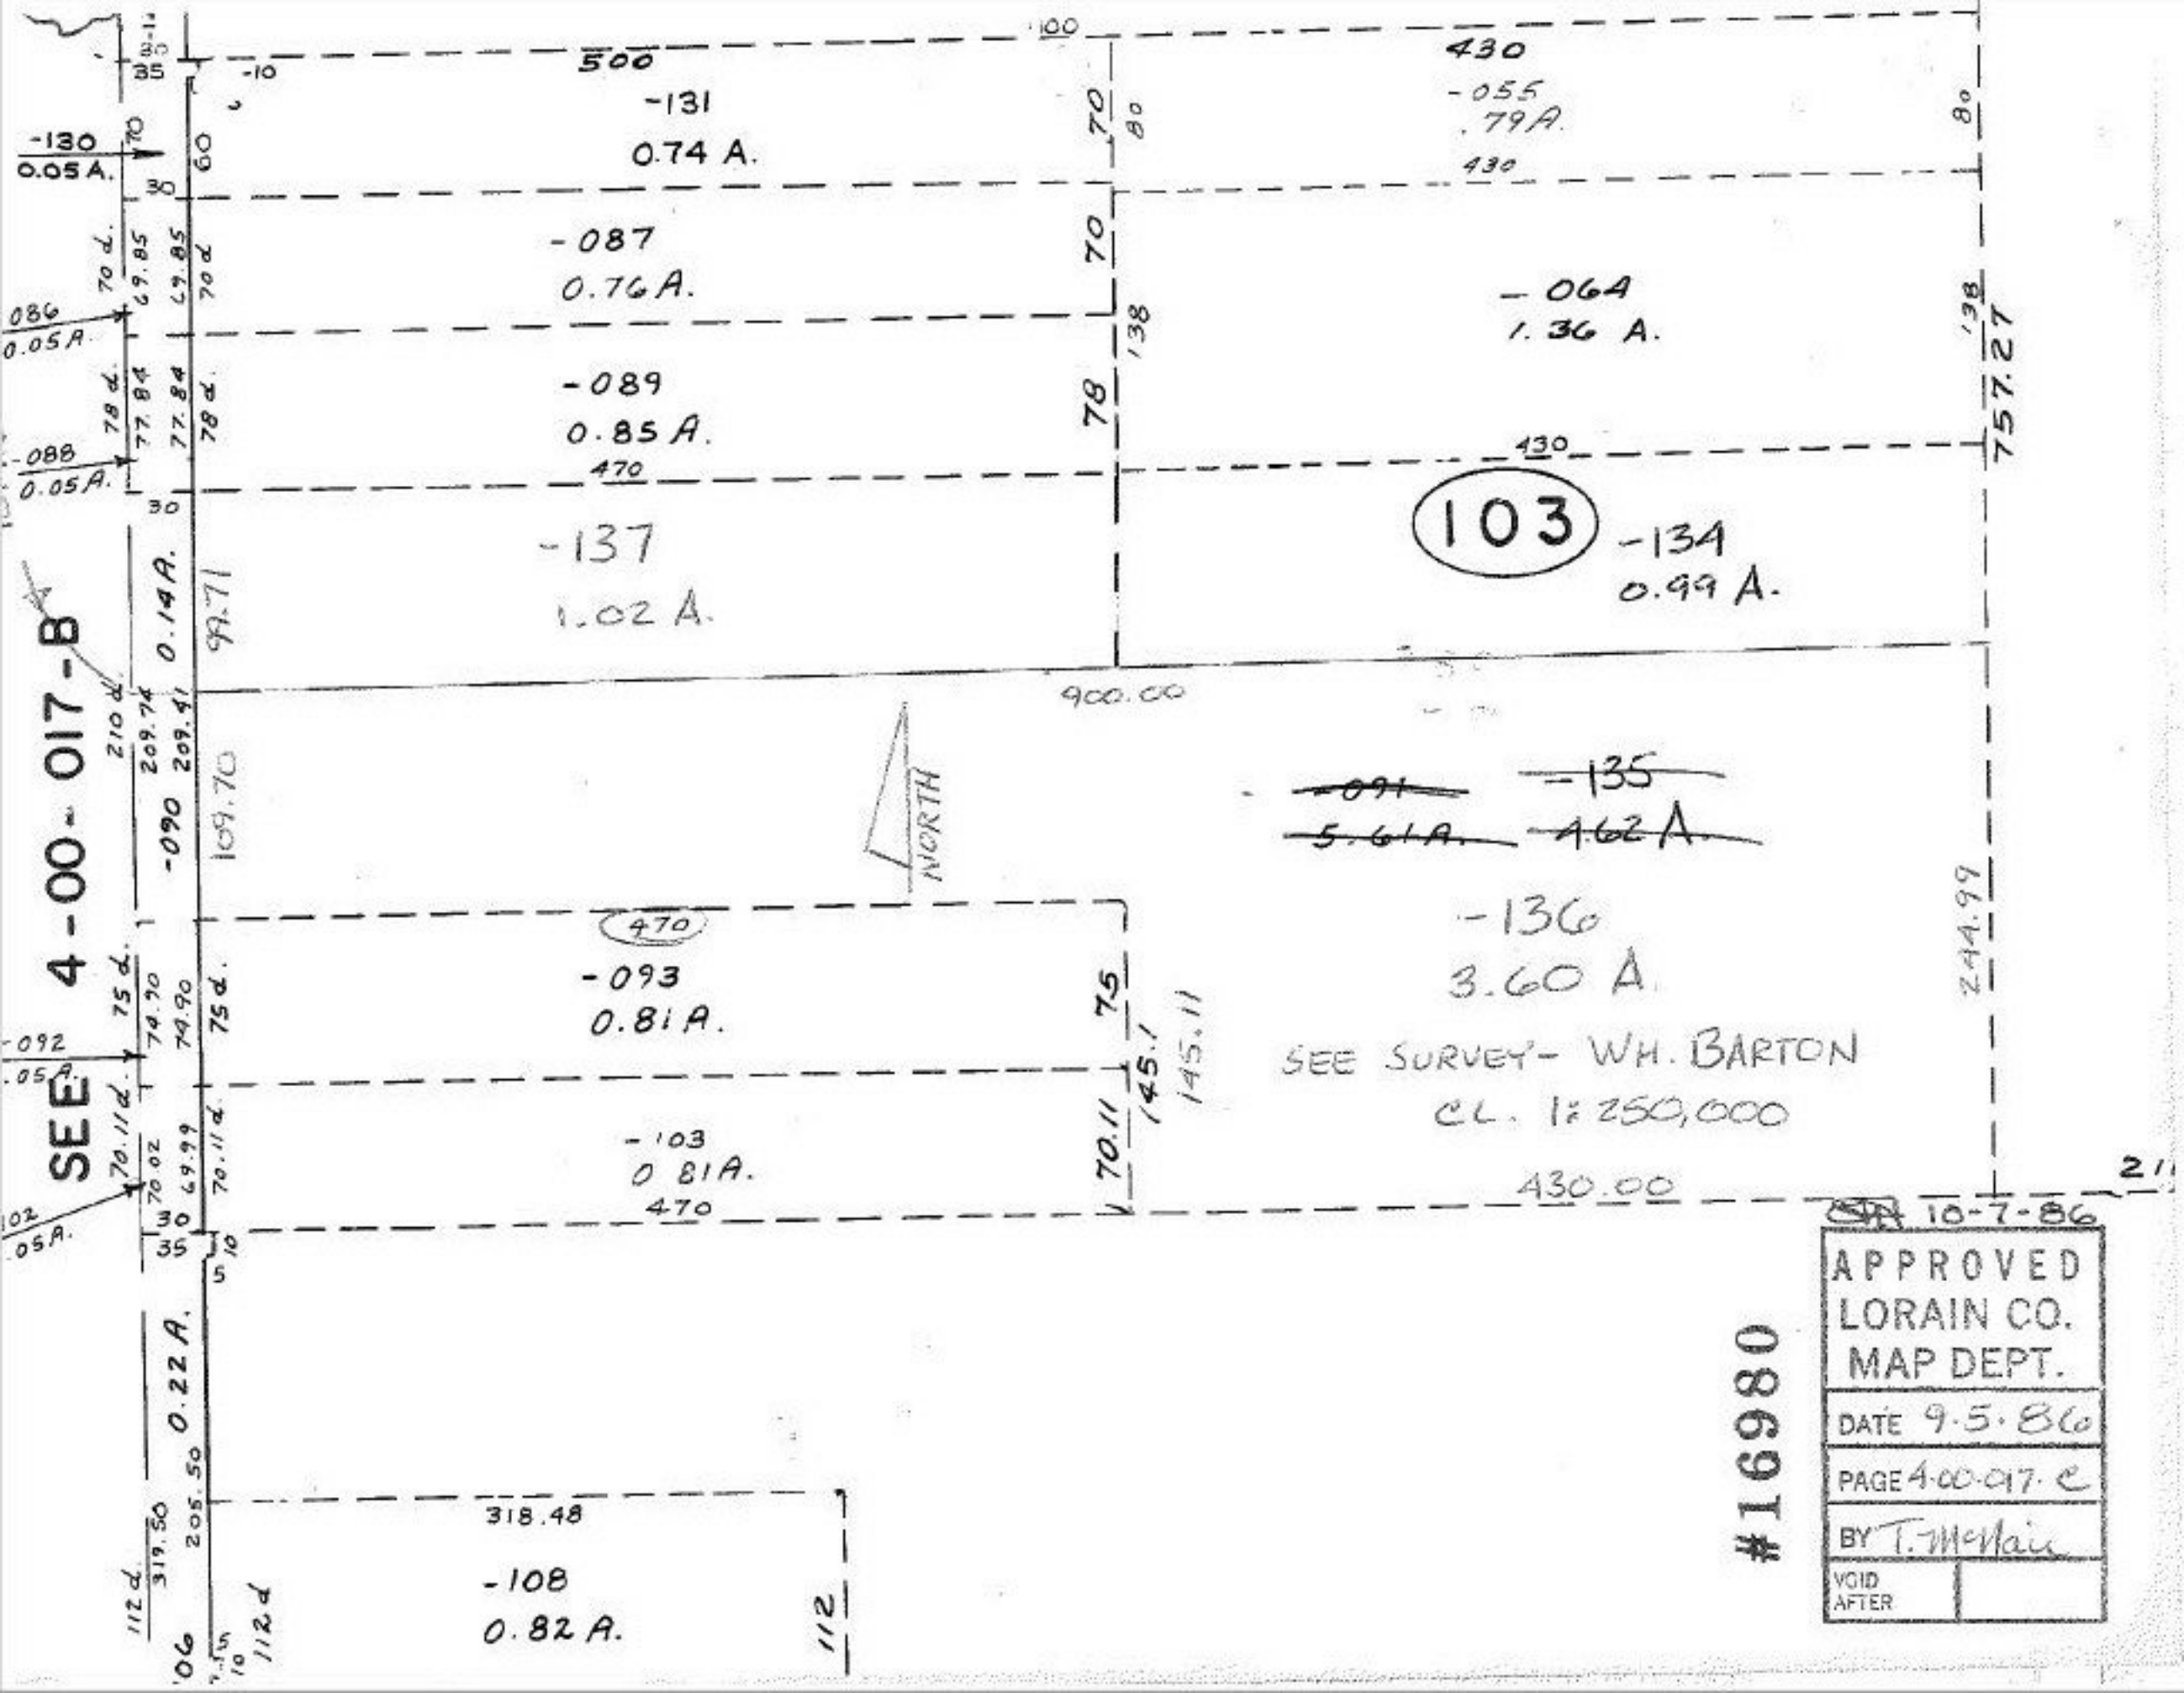

SEE 4-00-017-B
500
-131
0.74 A.
430
-055
.79 A.
-130
0.05 A.
-087
0.76 A.
-064
1.36 A.
-089
0.85 A.
-088
0.05 A.
470
-137
1.02 A.
103
-134
0.99 A.
900.00
NORTH
-091
5.61 A.
-135
4.62 A.
-136
3.60 A.
470
-093
0.81 A.
SEE SURVEY - WH. BARTON
CL. 1:250,000
-103
0.81 A.
470
430.00
757.27
244.99
0.14 A.
99.71
109.70
0.22 A.
318.48
-108
0.82 A.
112
#16980
10-7-86
APPROVED
LORAIN CO.
MAP DEPT.
DATE 9.5.86
PAGE 4-00-017-C
BY T. McNair
VOID AFTER