PARENT PARCEL: 02-02-009-101-023
CHILD PARCEL: 02-02-009-101-095, -096
STARTING POINT: INTERSECTION OF C/L OF JAEGER RD, AND EAST LINE OF O.L.9

17-00759

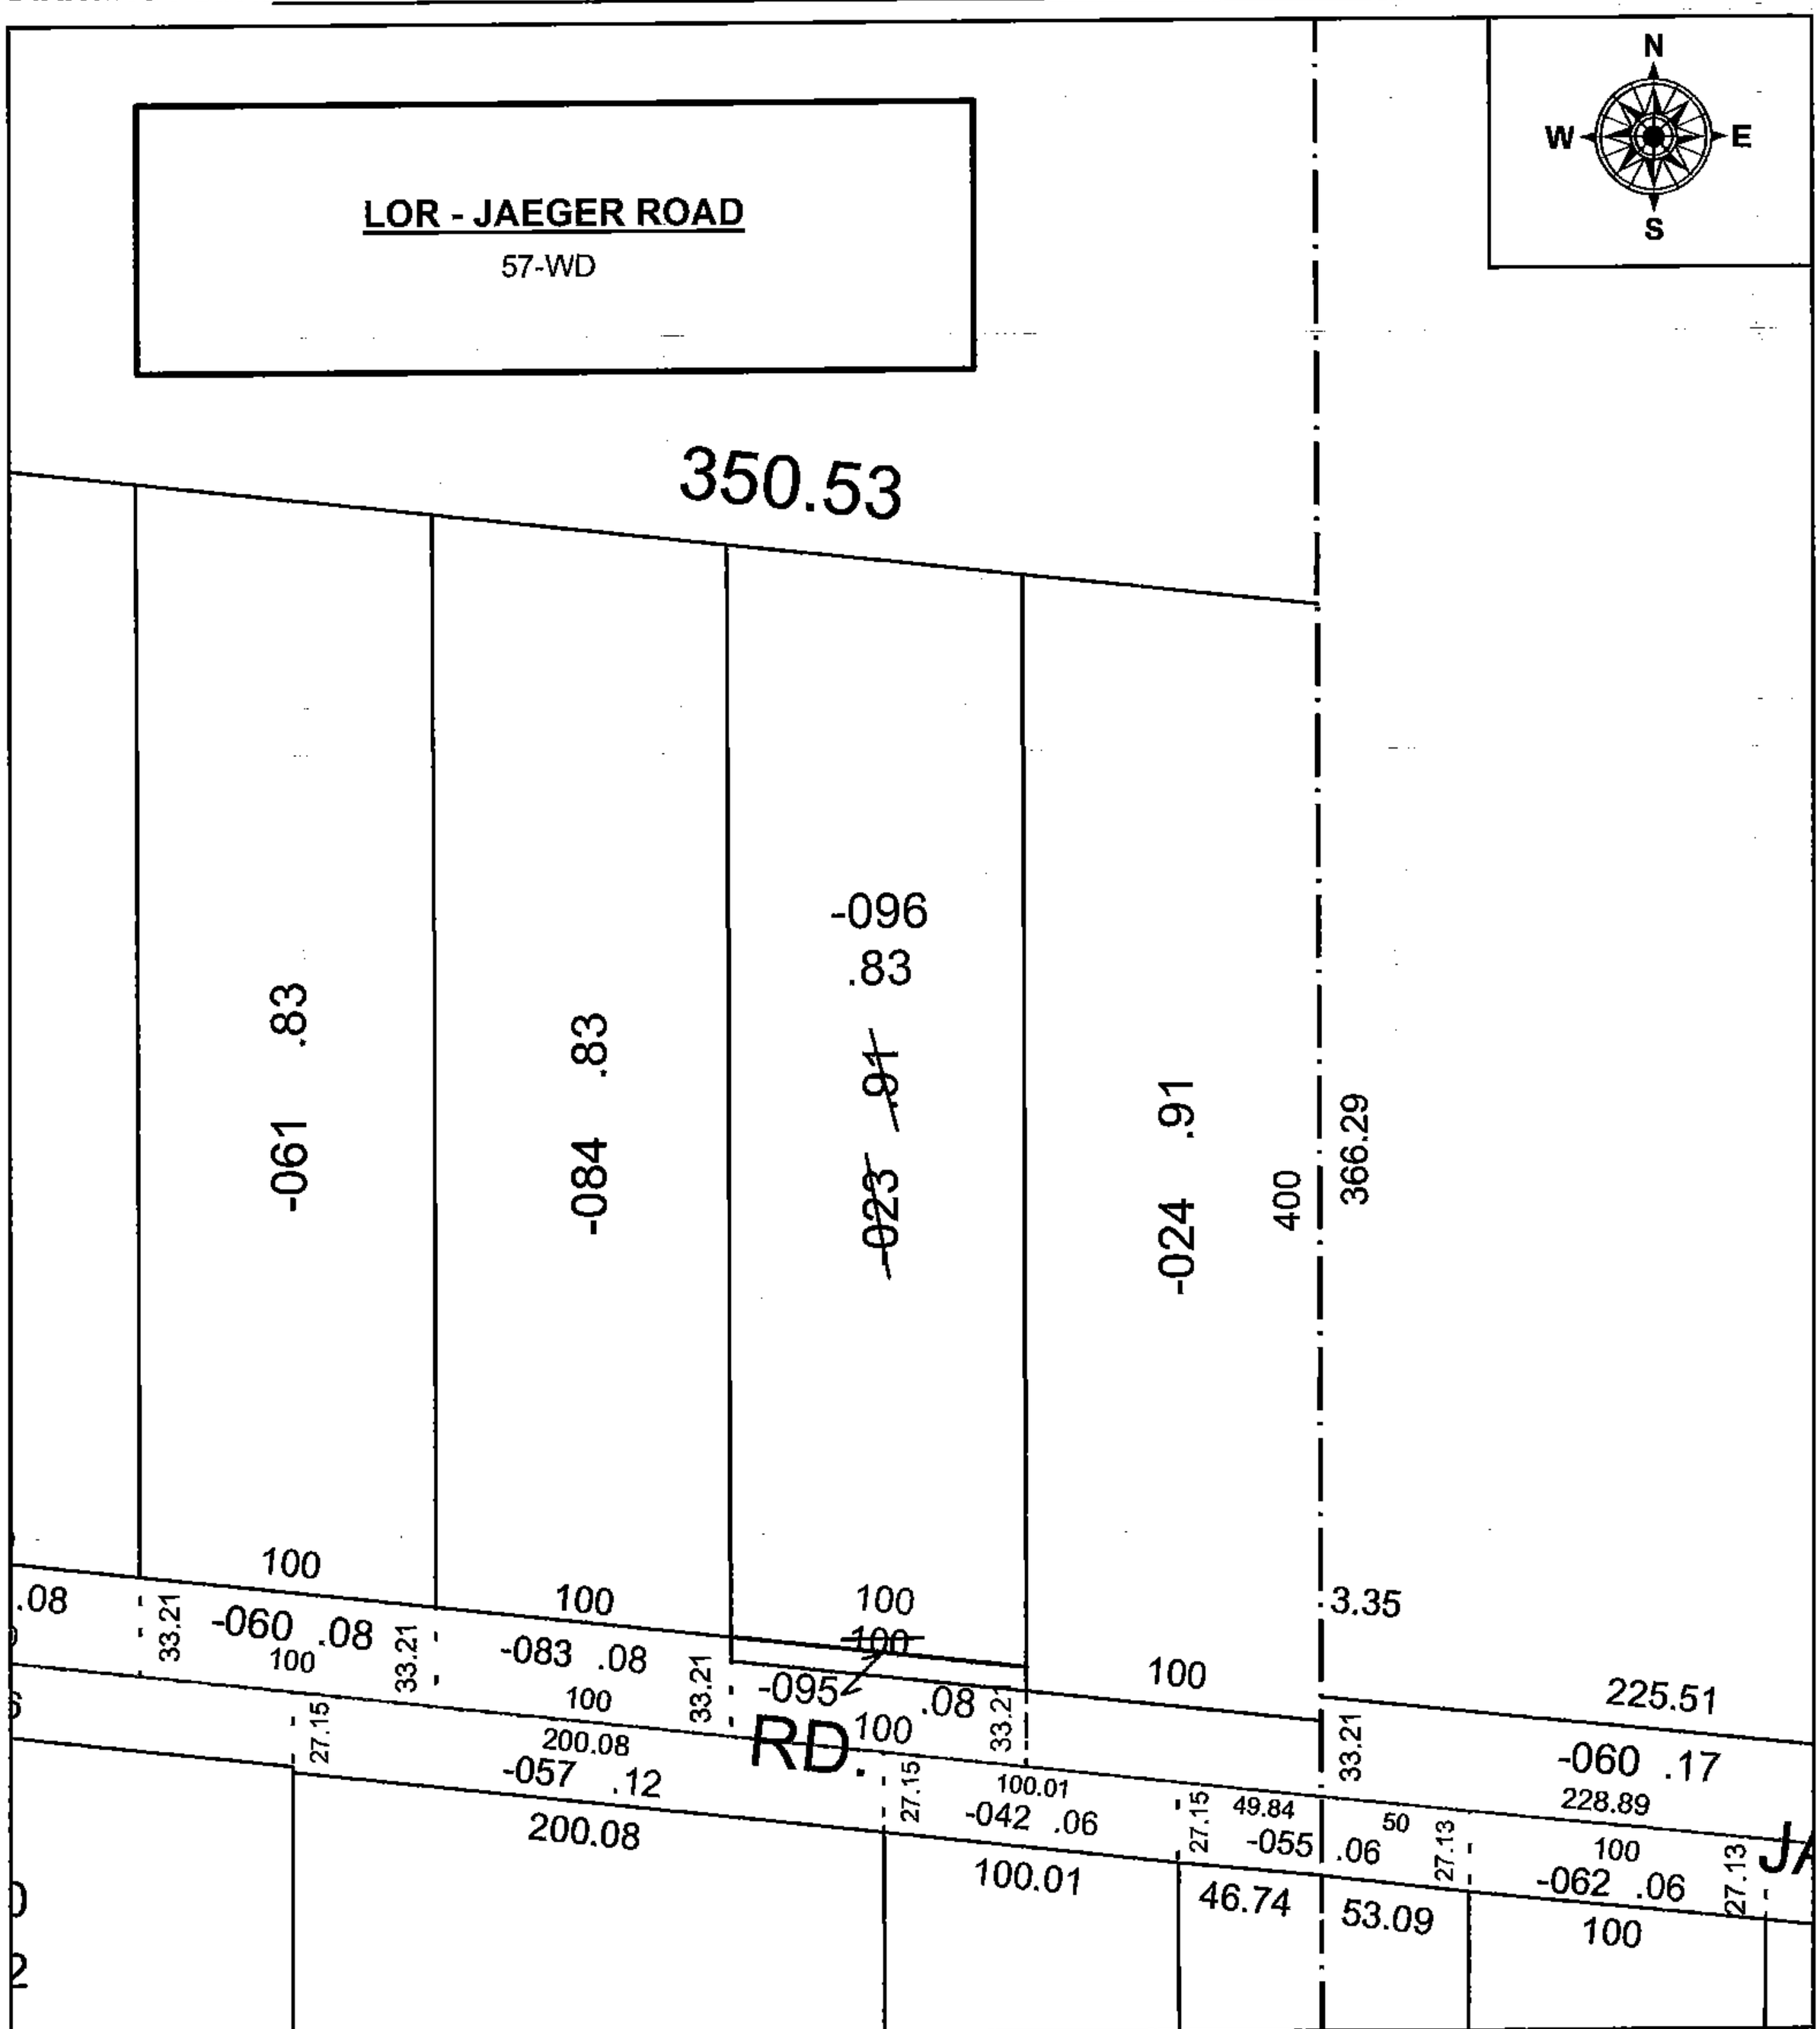

SPLITS/DEEDS PROCESSED
LORAIN COUNTY TAX MAP DEPARTMENT
226 MIDDLE AVE. ELYRIA, OH

SURVEYED BY: TREVOR A. BIXLER
CLOSURE: 1: 2147483648
MAP PAGE(S): 2-02-009
APPOVED BY: RRM **DATE:** 1-4-18
SCALE: 1" = 75 **PRIOR INSTRUMENT:** 20090304376