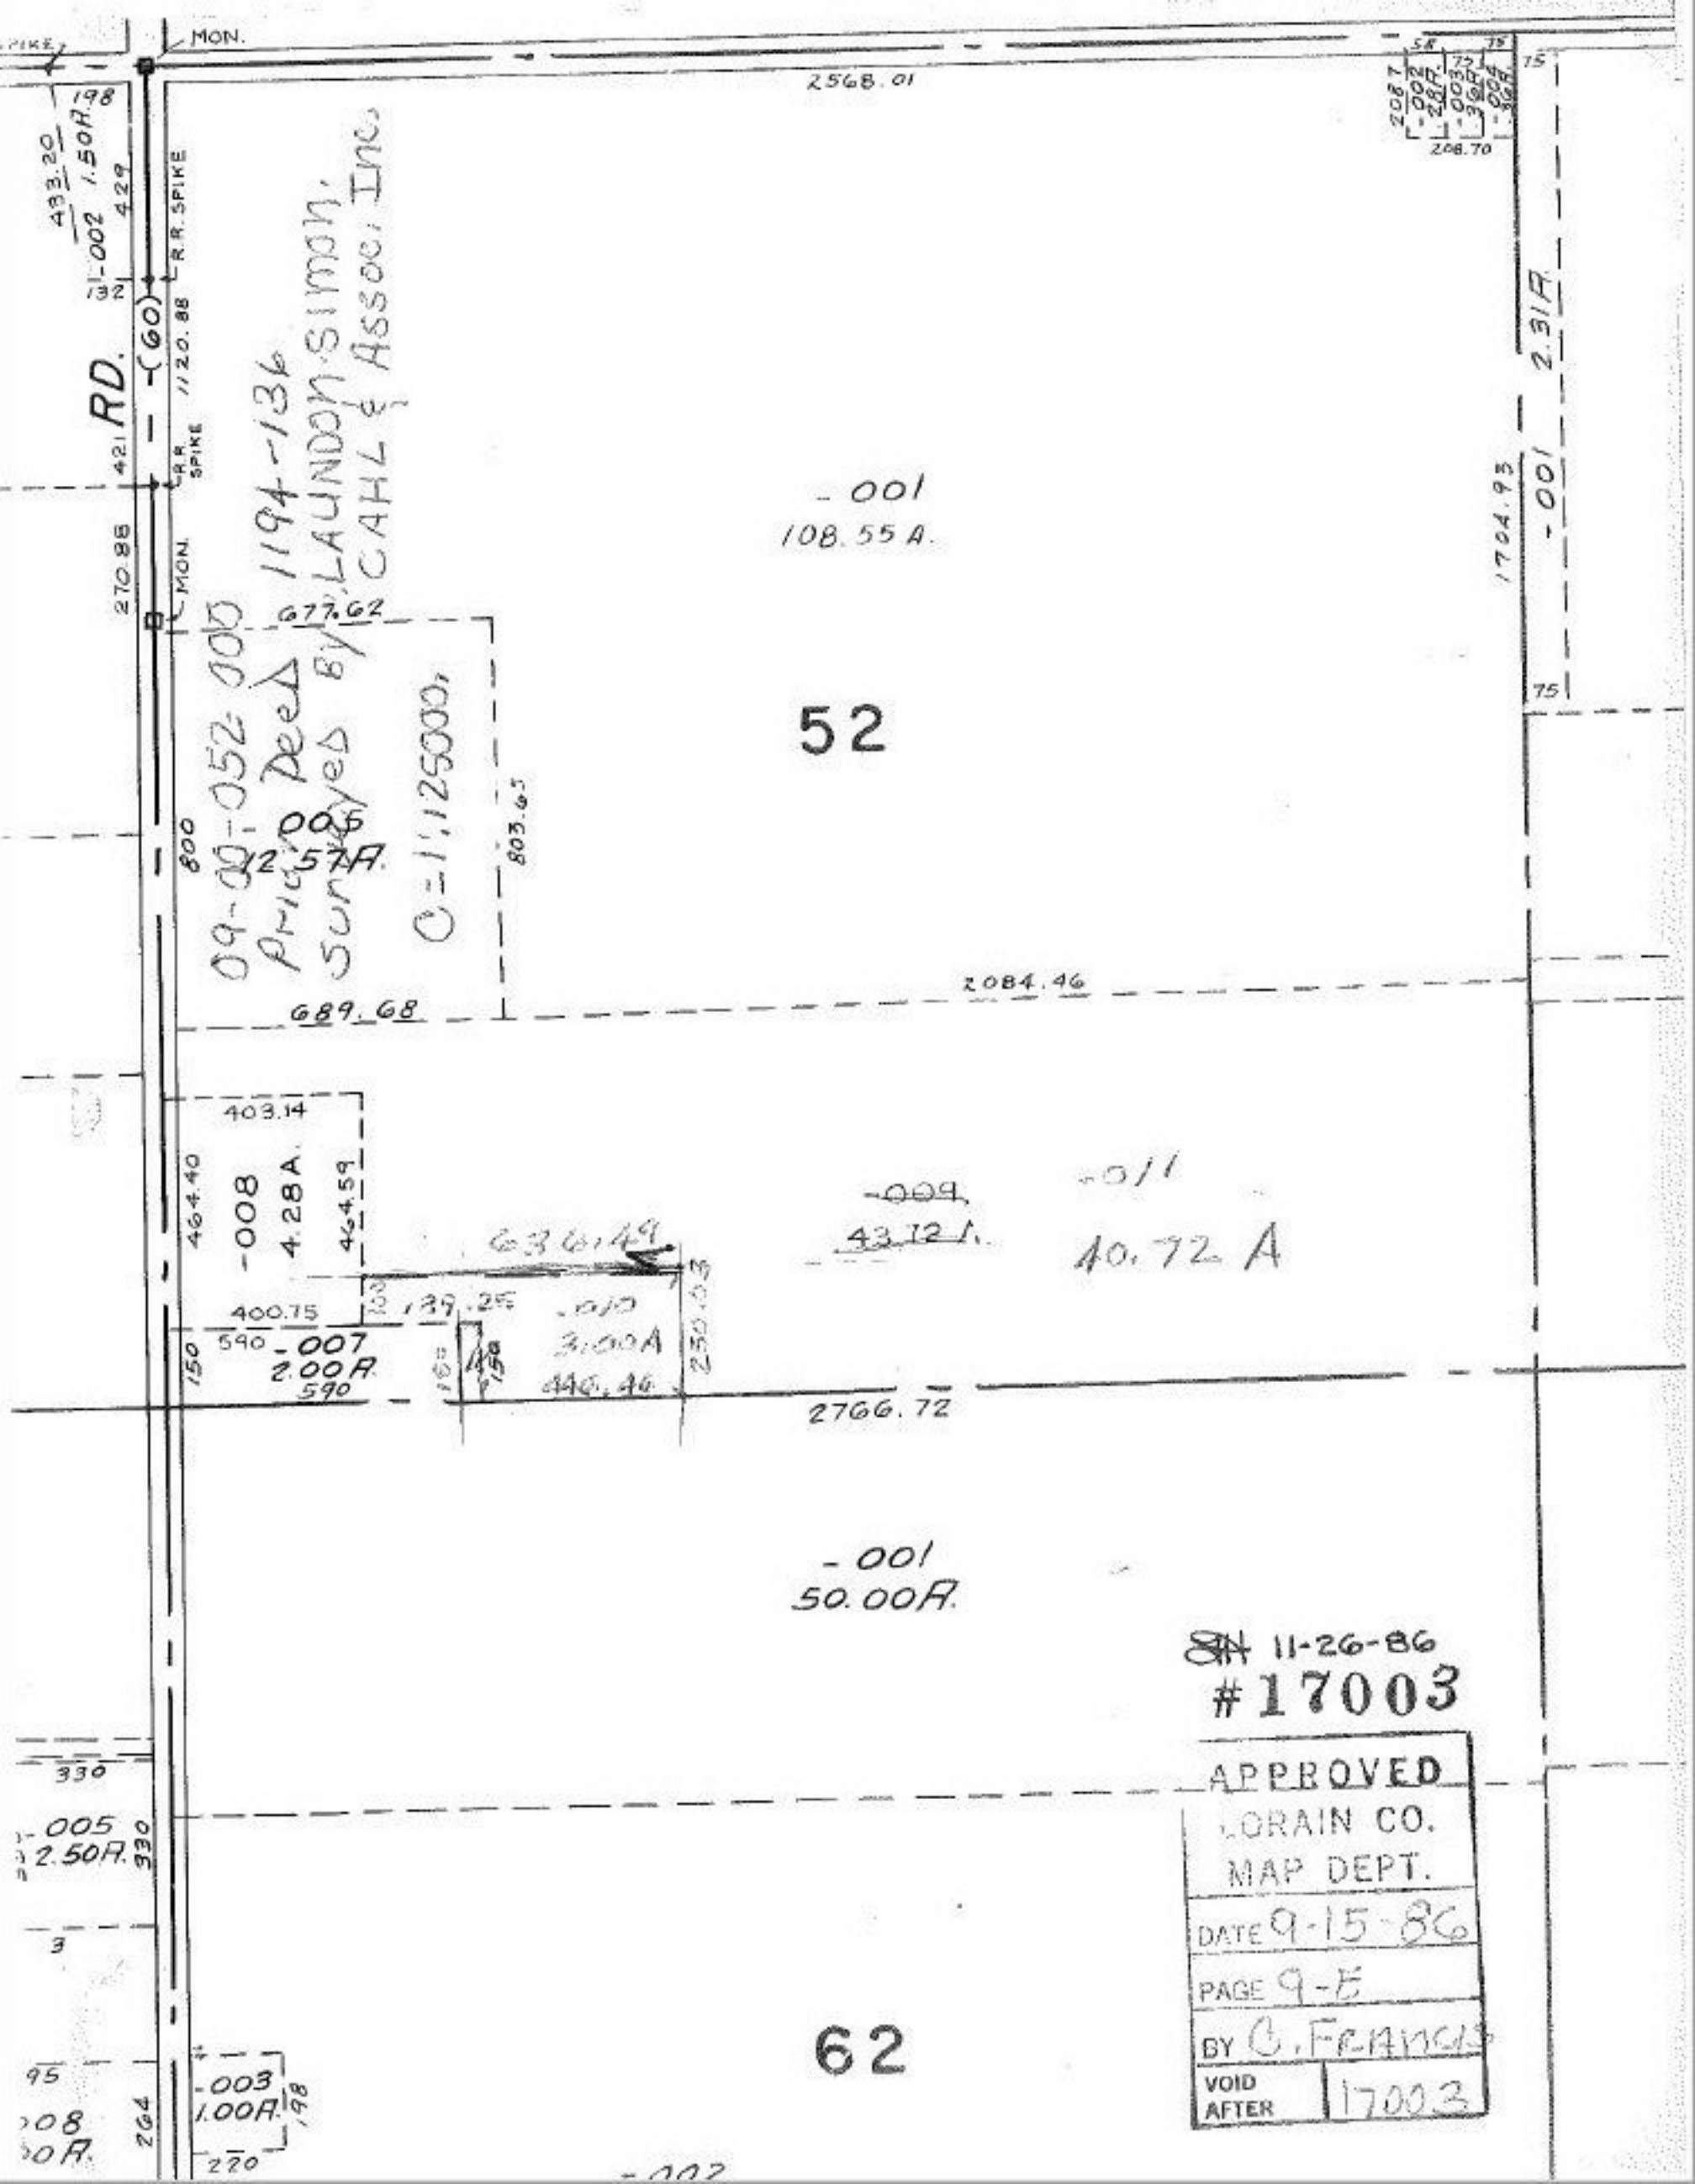

11-26-86
#17003

APPROVED
LORAIN CO.
MAP DEPT.
DATE 9-15-86
PAGE 9-E
BY G. Francis
VOID AFTER 17003