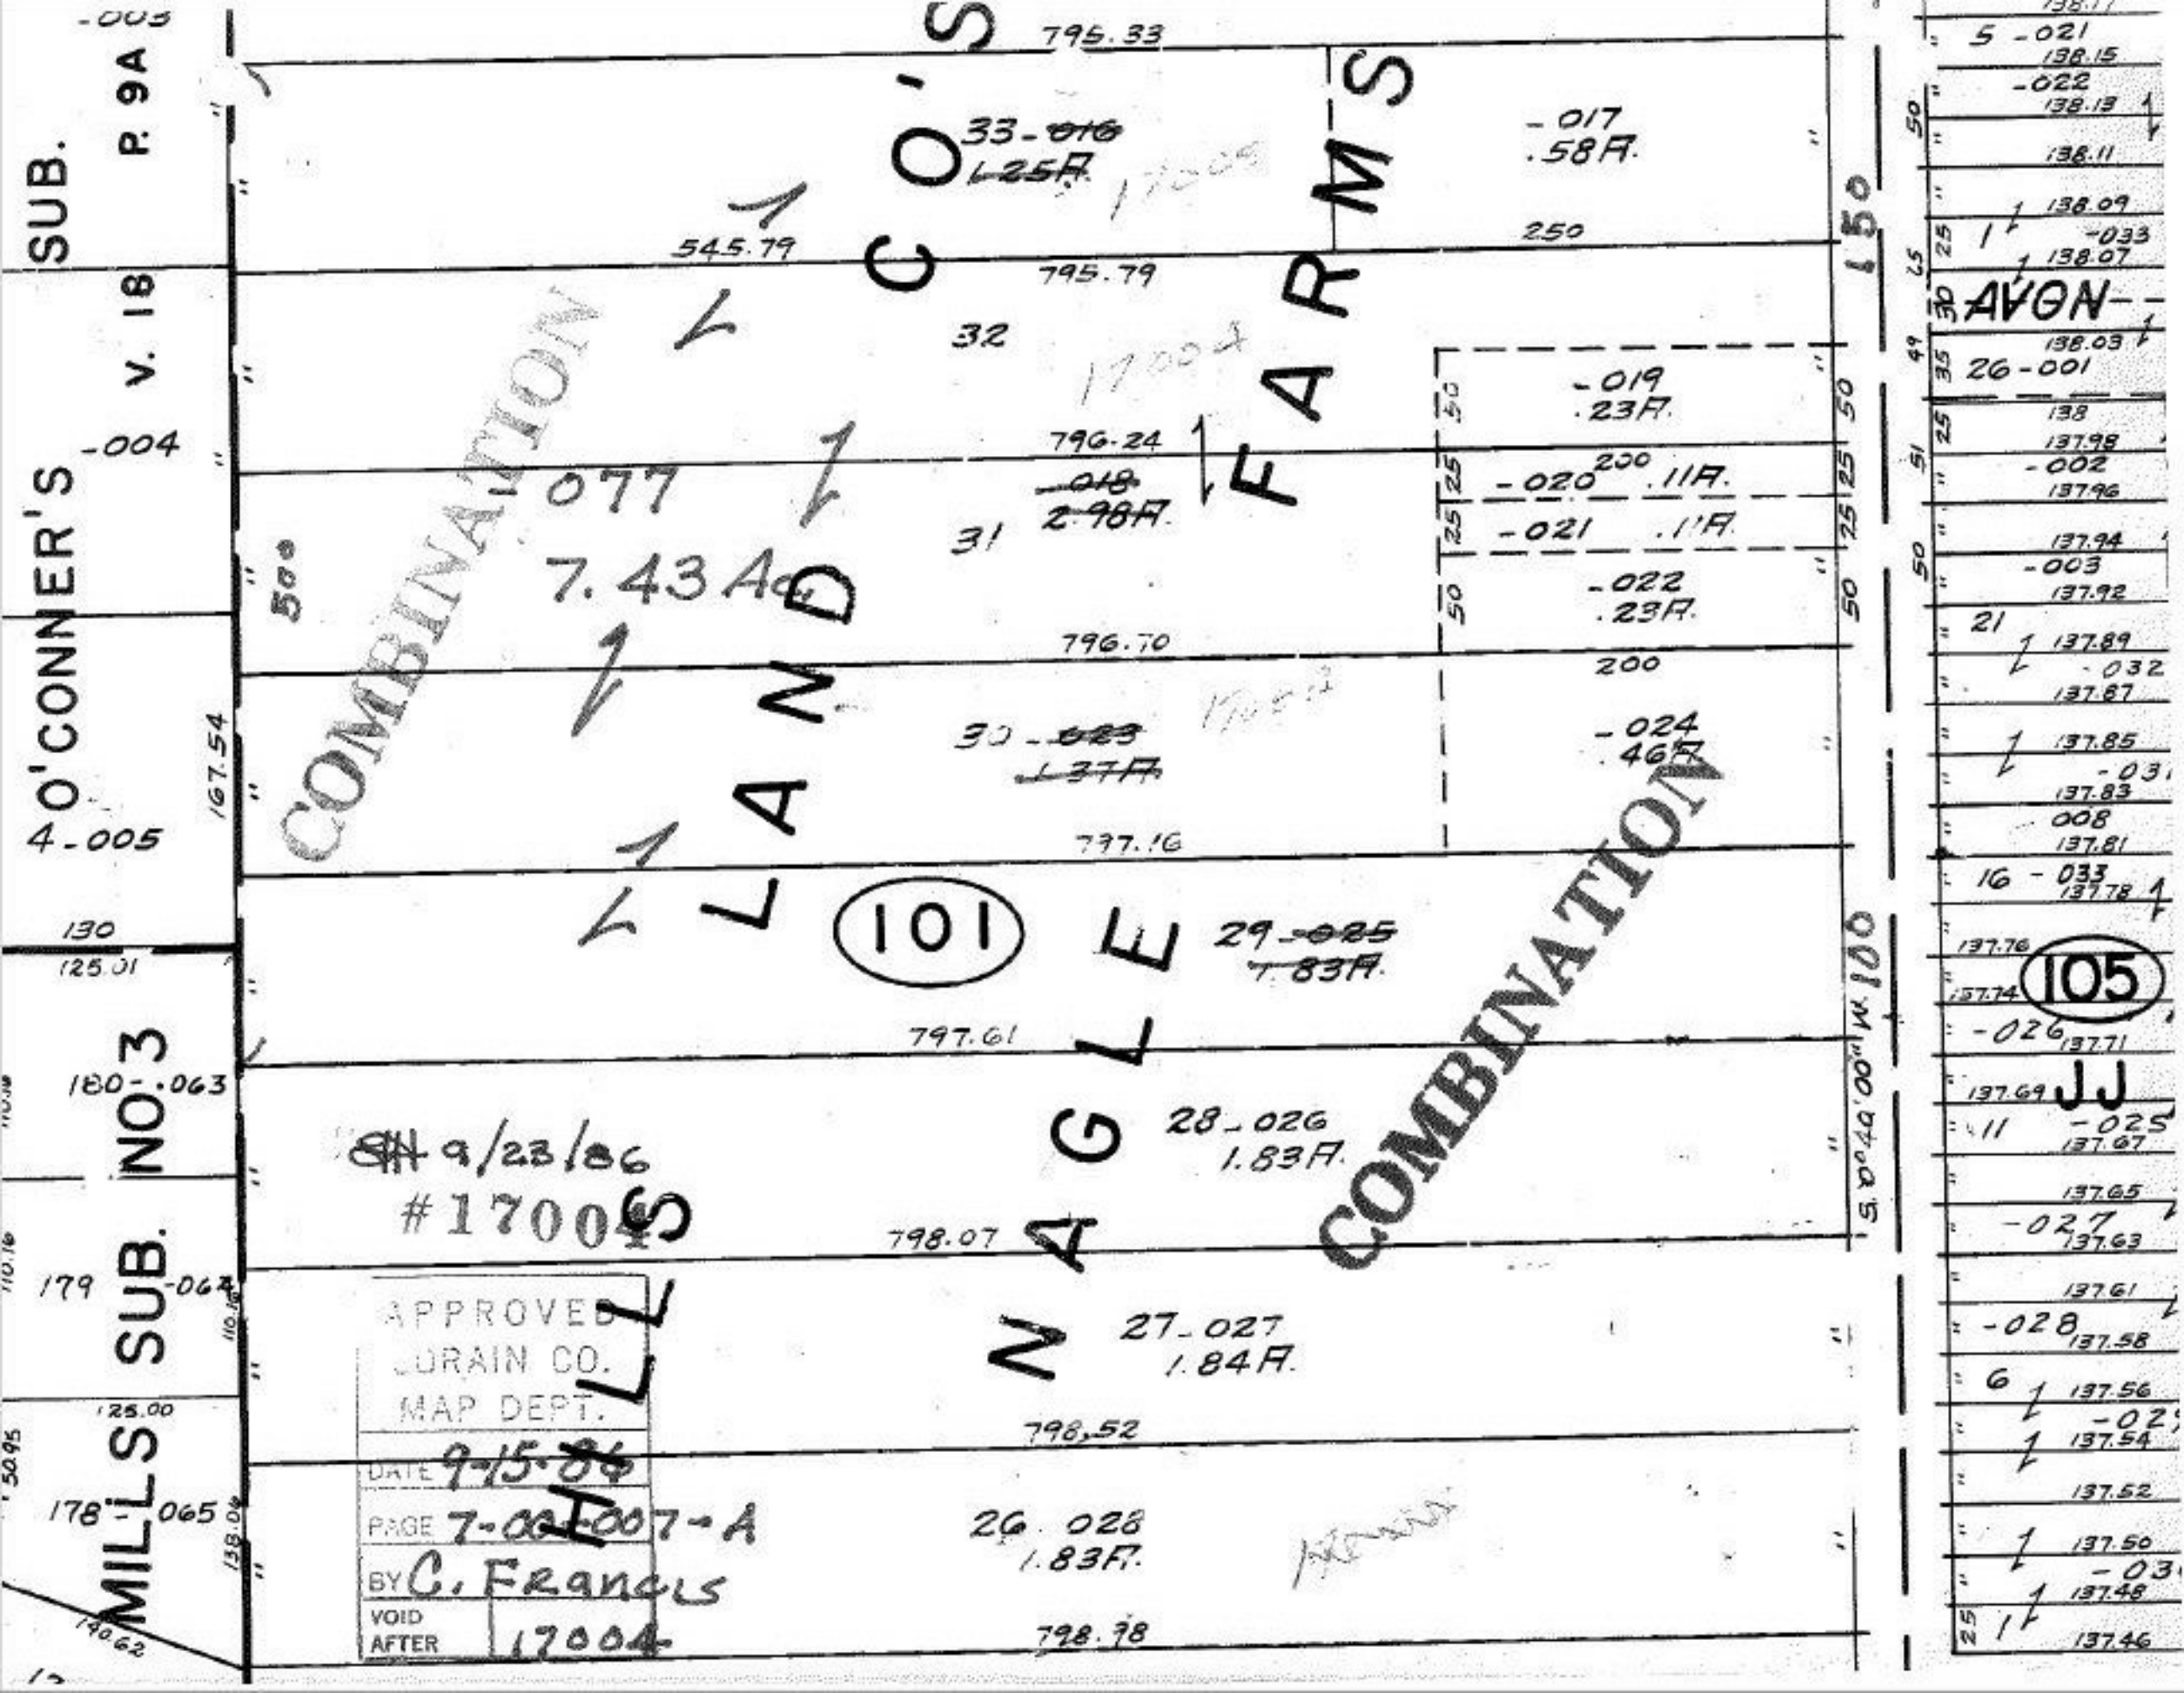

MILLS SUB. NO 3
O'CONNER'S SUB.
V. 18
P. 9A
COMBINATION
LAND CO'S
HILLS
NAGLE FARMS
COMBINATION
101
105
AVON
JJ
#17004
9/23/86
APPROVED
LORAIN CO.
MAP DEPT.
DATE 9-15-86
PAGE 7-00-007-A
BY C. Francis
VOID AFTER 17004