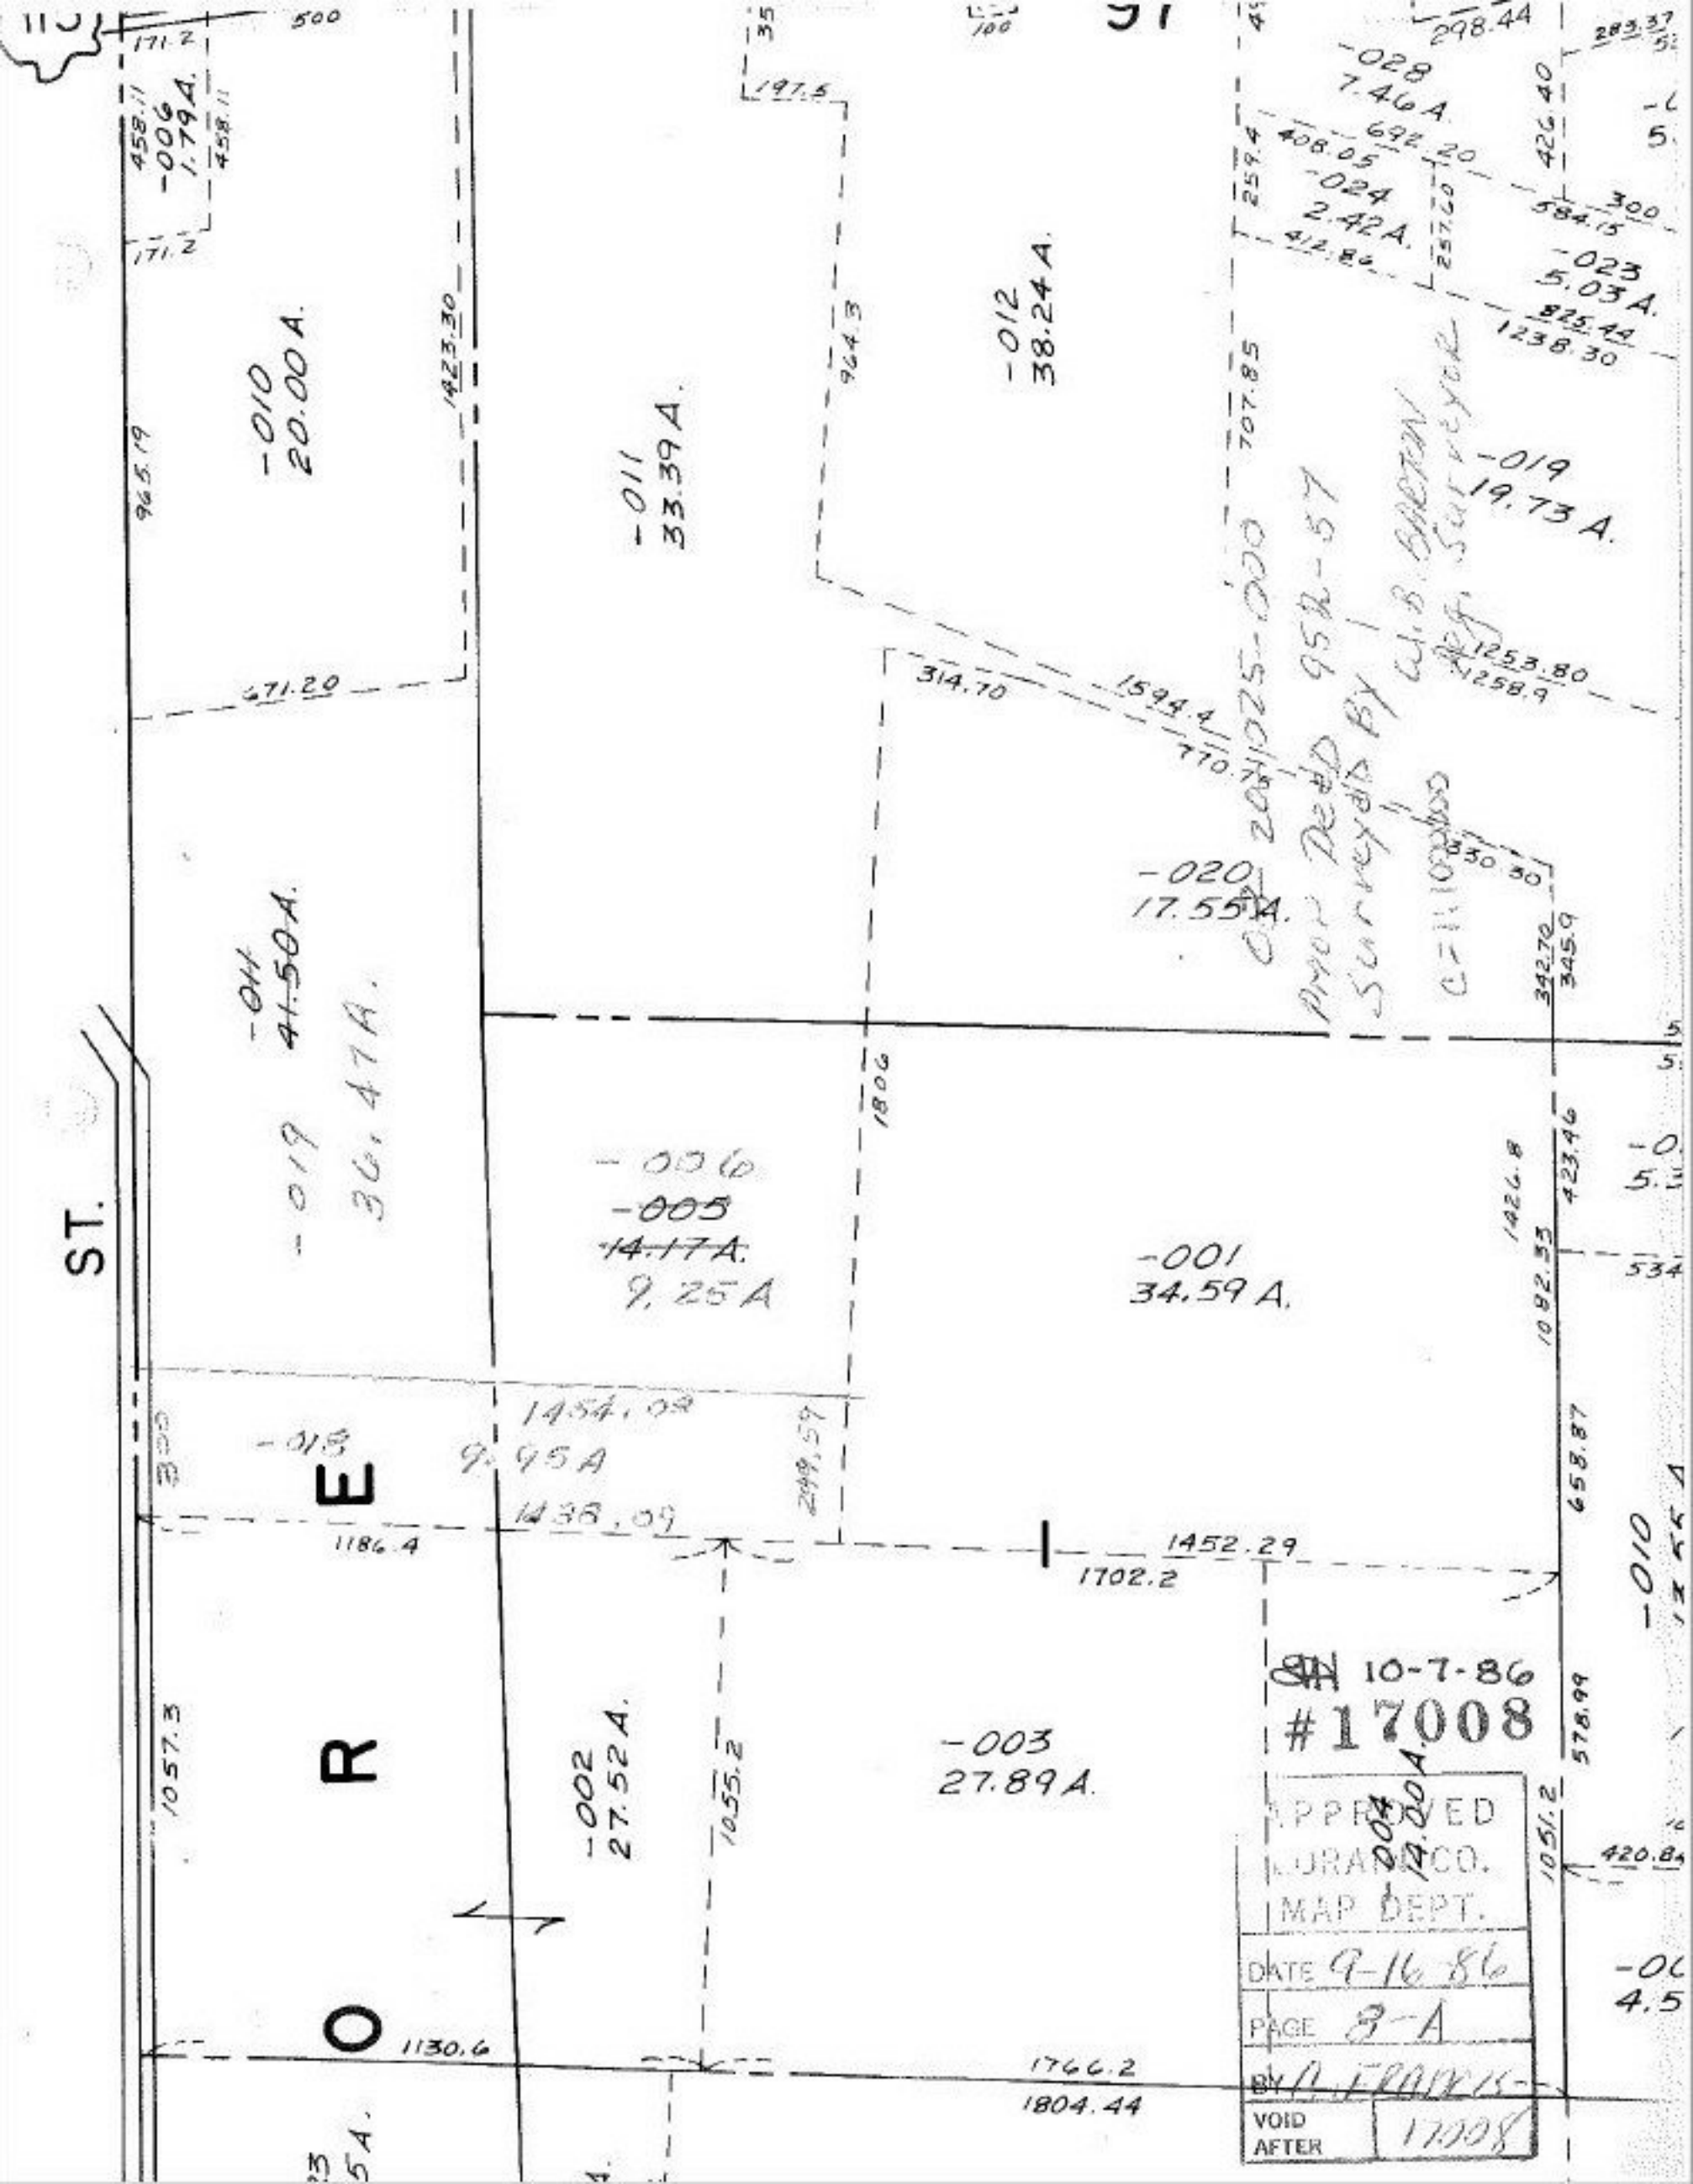

ST.
O R E
-010
20.00 A.
-011
33.39 A.
-012
38.24 A.
-028
7.46 A.
-024
2.42 A.
-023
5.03 A.
-019
19.73 A.
-020
17.55 A.
-011
41.50 A.
-019
36.47 A.
-006
-005
14.17 A.
9.25 A
-001
34.59 A.
-018
9.95 A
-002
27.52 A.
-003
27.89 A.
-004
14.00 A.
-010
-006
1.79 A.
1423.30
1423.30
1186.4
1452.29
1702.2
1130.6
1766.2
1804.44
1057.3
1055.2
1051.2
1806
1423.46
1082.33
658.87
578.99
420.84
1253.80
1258.9
1238.30
825.44
692.20
408.05
412.86
257.60
259.4
707.85
964.3
197.5
171.2
458.11
965.19
671.20
314.70
1594.4
770.75
330.30
342.70
345.9
298.44
283.37
426.40
584.15
300
534

10-7-86
#17008
APPROVED
LORAIN CO.
MAP DEPT.
DATE 9-16-86
PAGE 8-A
BY A. FRANCIS
VOID AFTER 17008