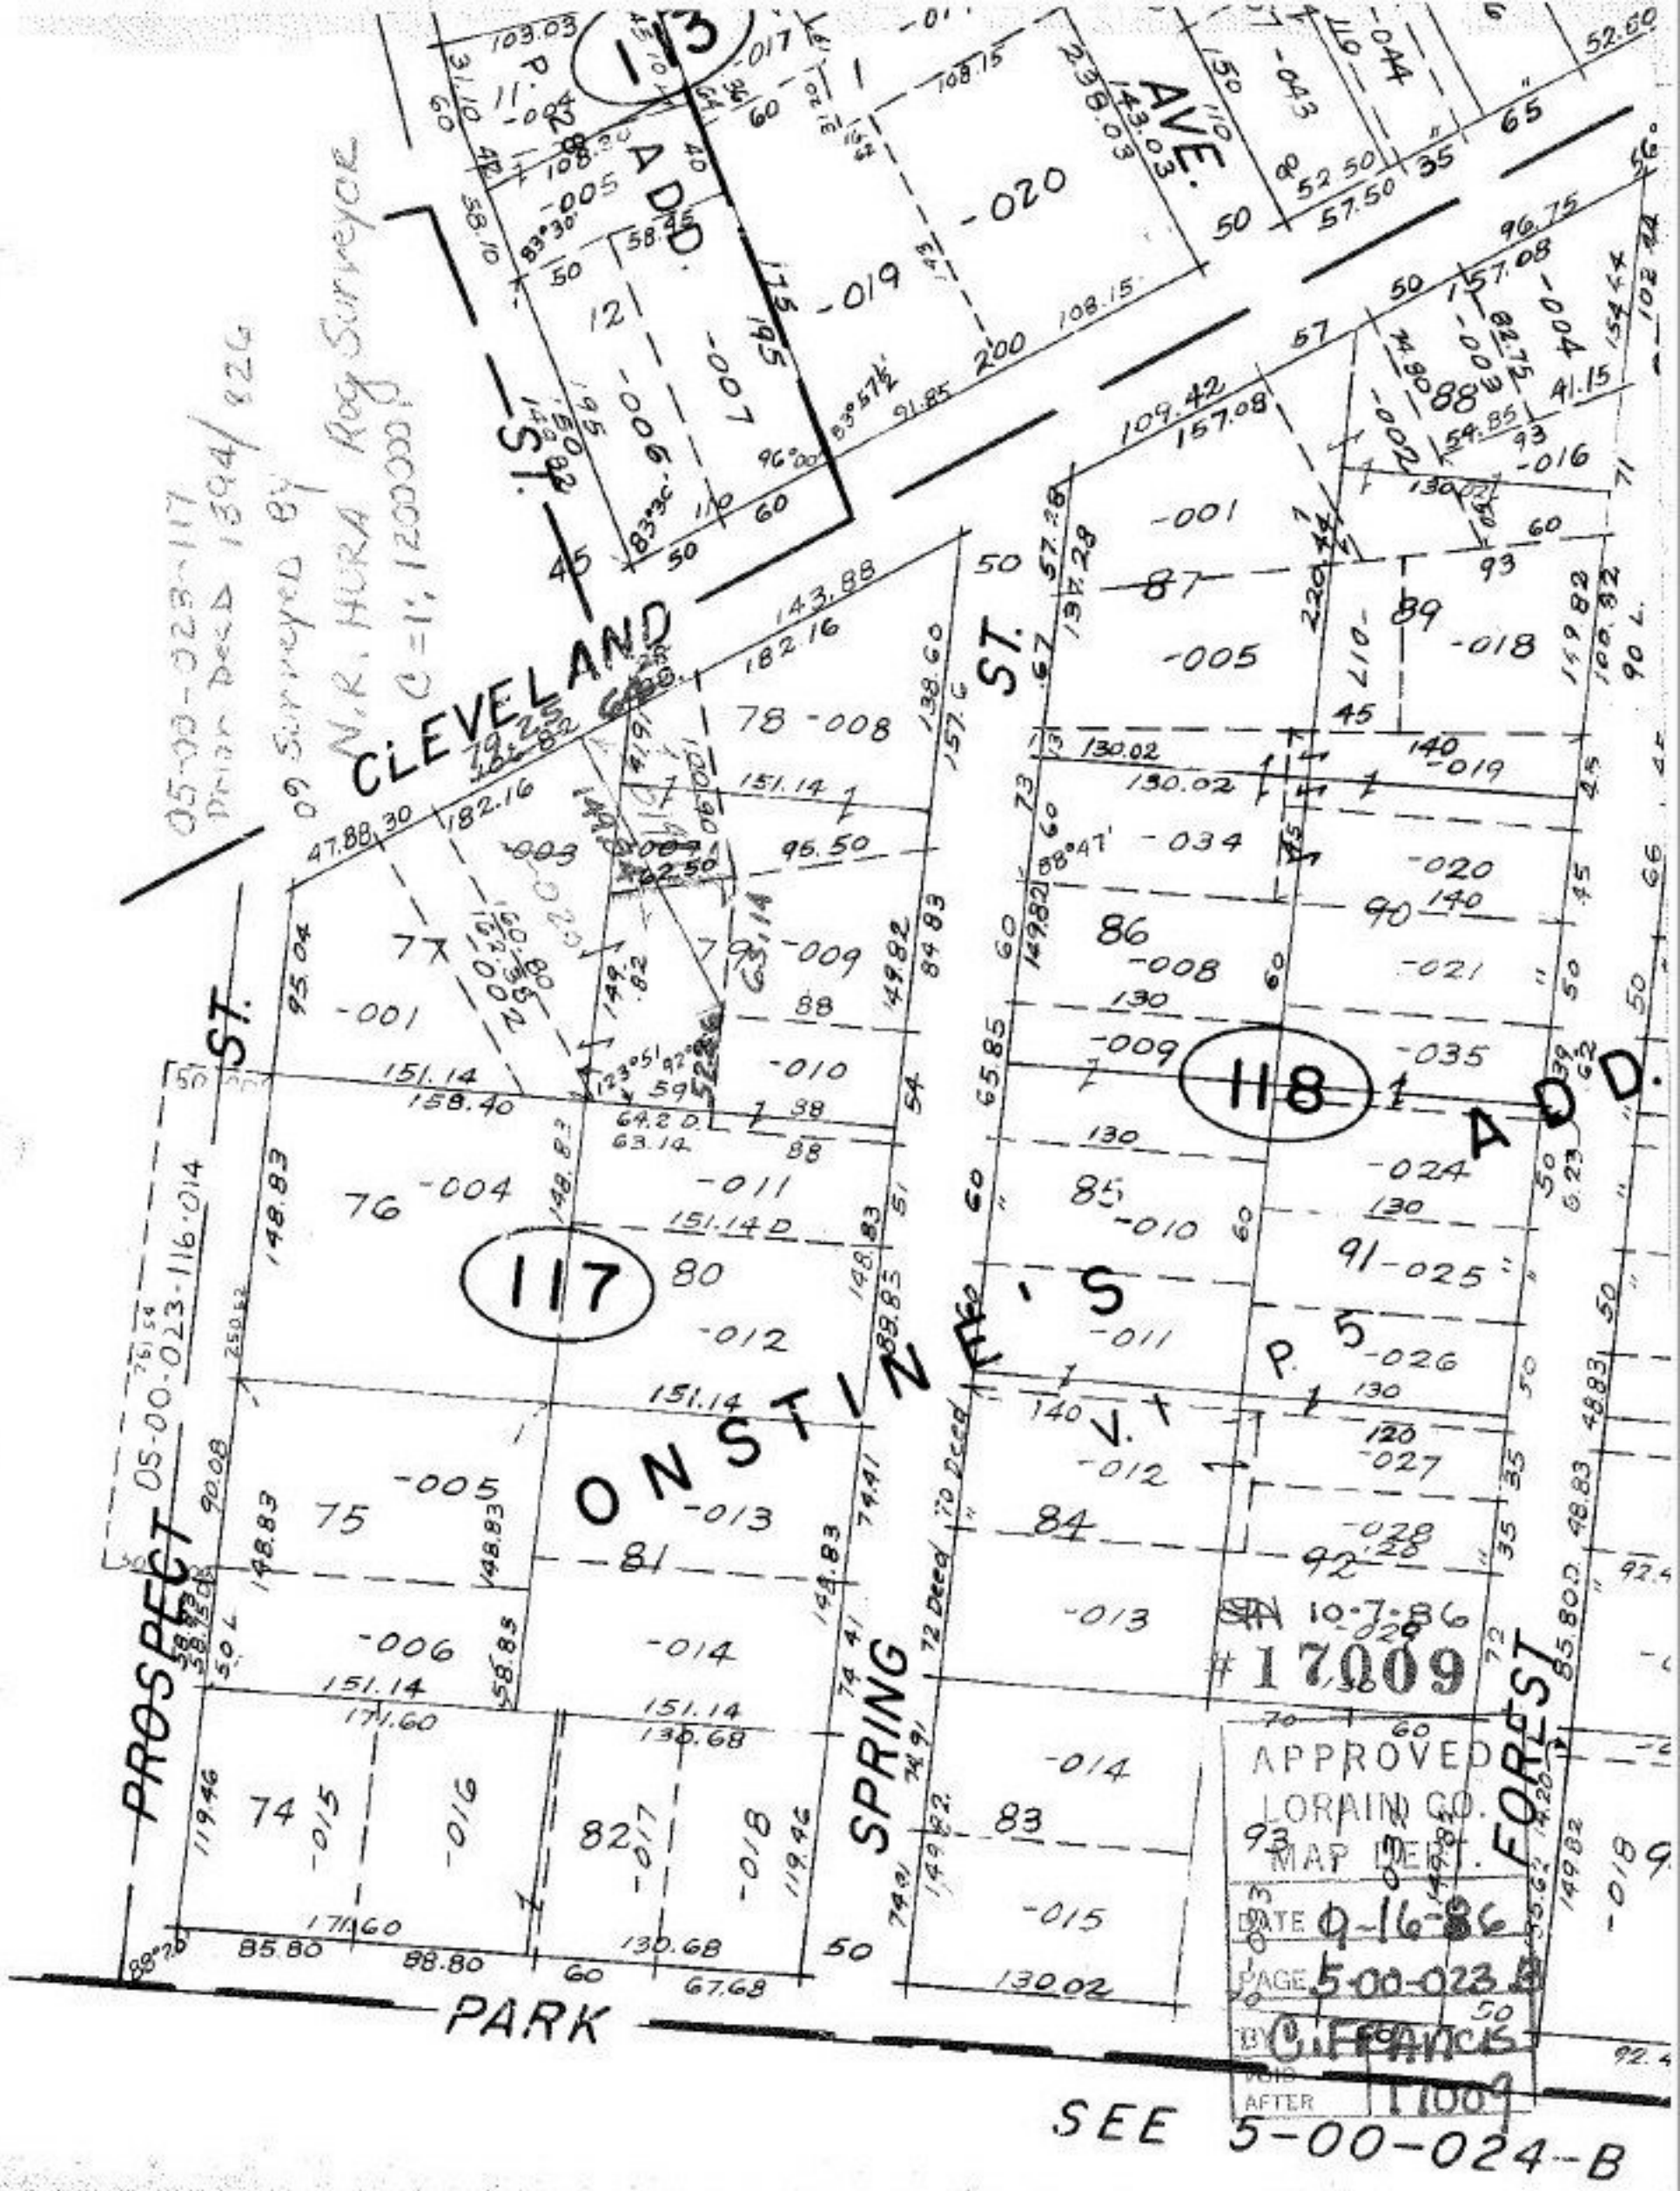

CLEVELAND
ST.
ADD.
AVE.
ONSTINE'S
SPRING
FOREST
PROSPECT
PARK
113
117
118
05-00-023-117
Prior Deed 1394/826
09 Surveyed By
N.R. HURA Reg Surveyor
C=1:1200000
05-00-023-116-014
SEE 5-00-024-B
#17009
APPROVED
LORAIN CO.
MAP DEPT.
DATE 9-16-86
PAGE 5-00-023-B
BY C. Francis
VOID AFTER 17009