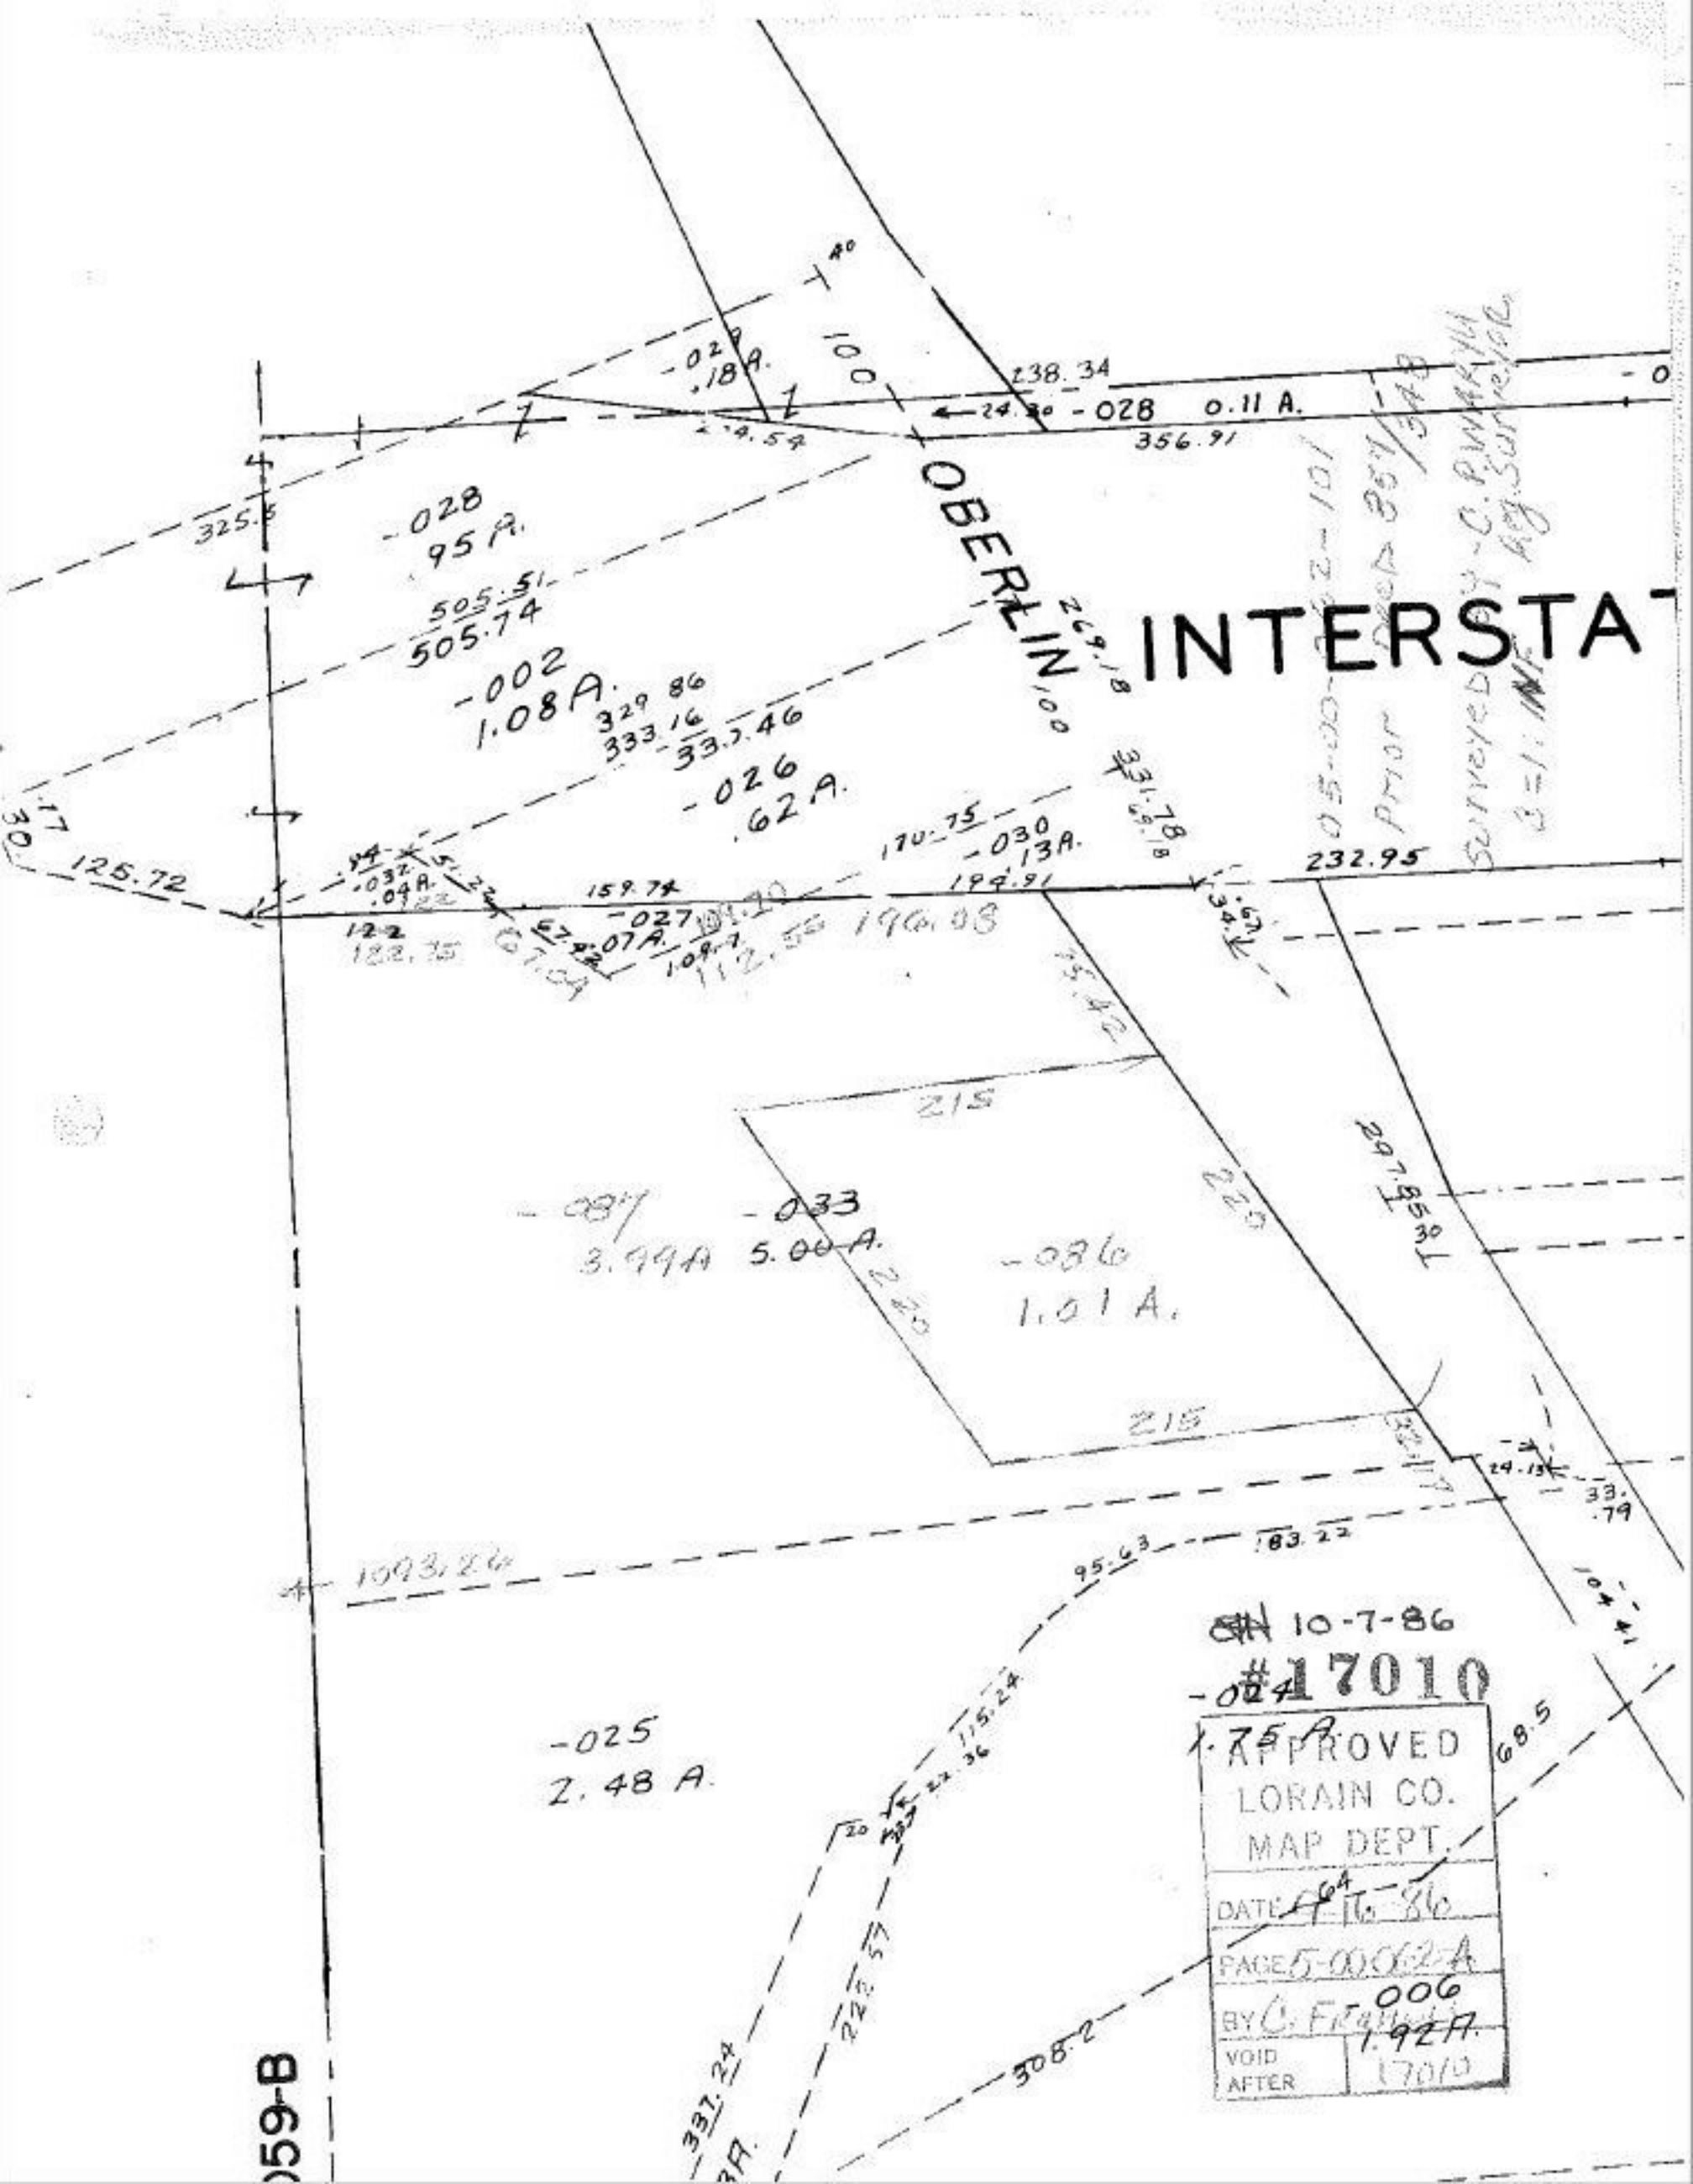

10-7-86
#17010
APPROVED
LORAIN CO.
MAP DEPT.
DATE 9-16-86
PAGE 5-00062-A
BY C. Franklin
VOID AFTER 17010

059-B