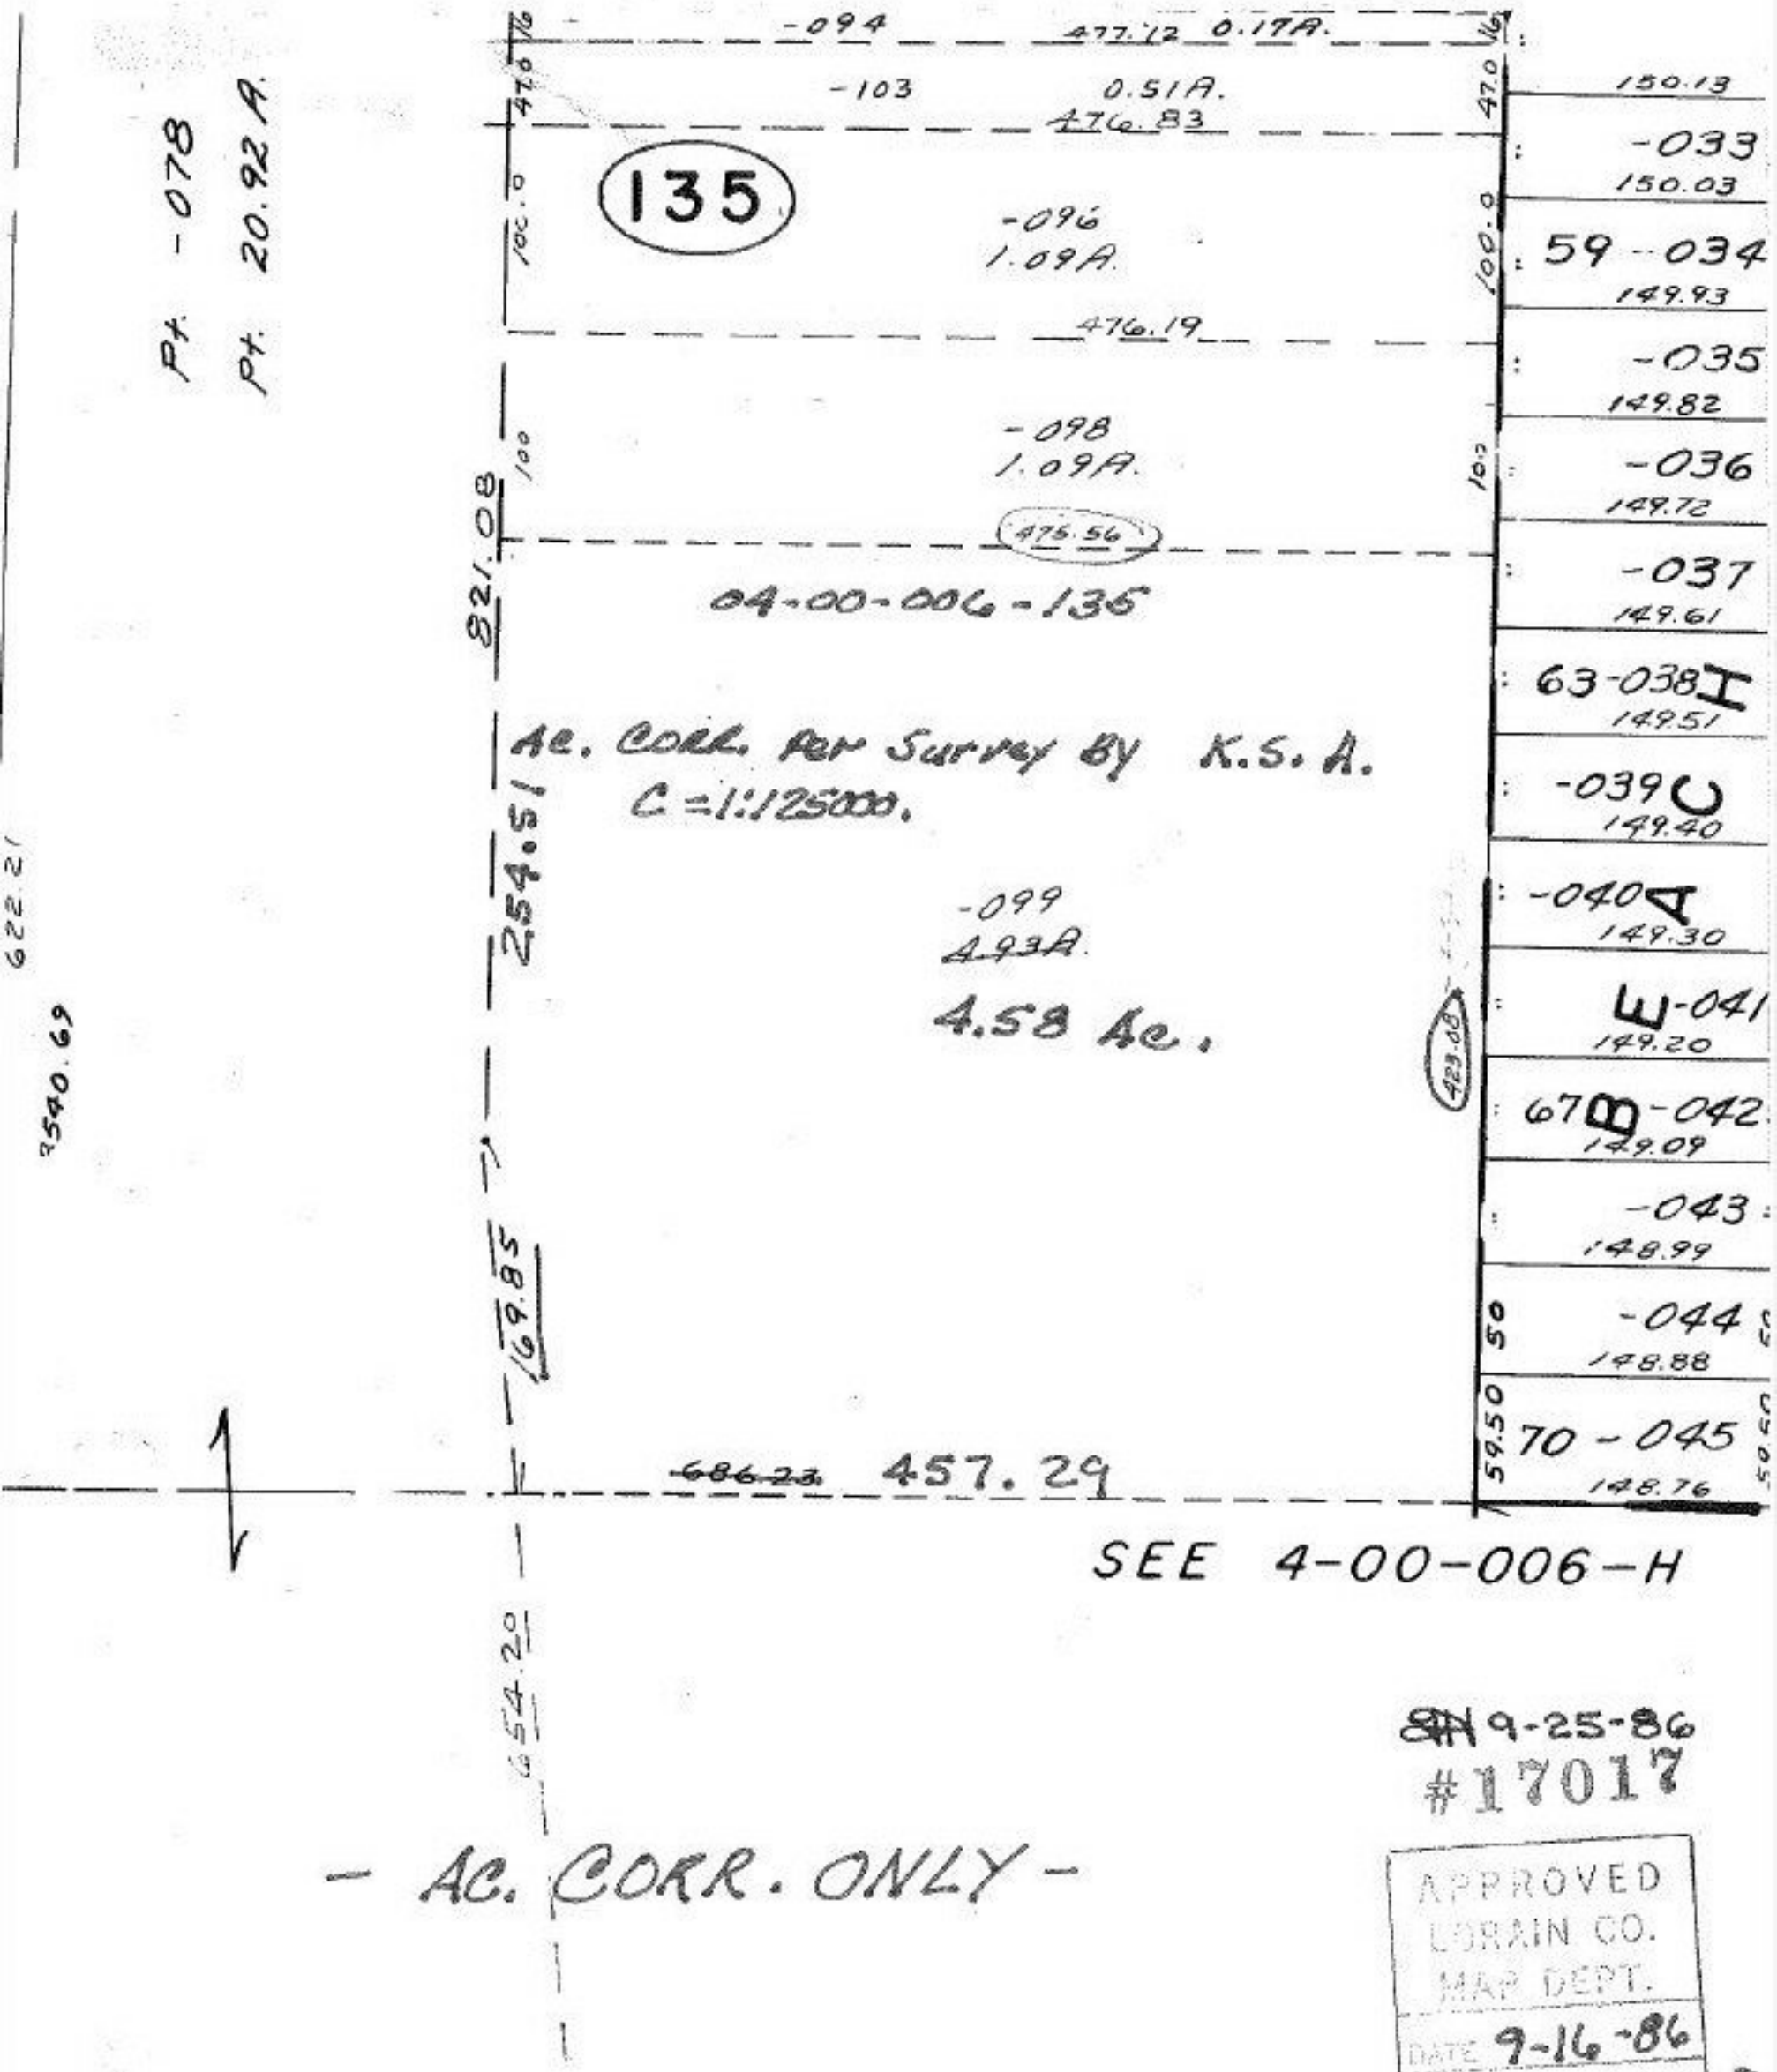


SH 9-25-86
#17017

APPROVED
LORAIN CO.
MAP DEPT.
DATE 9-16-86
PAGE 4-00-006D
BY C. FRANCIS E. Colberg
VOID AFTER 17017