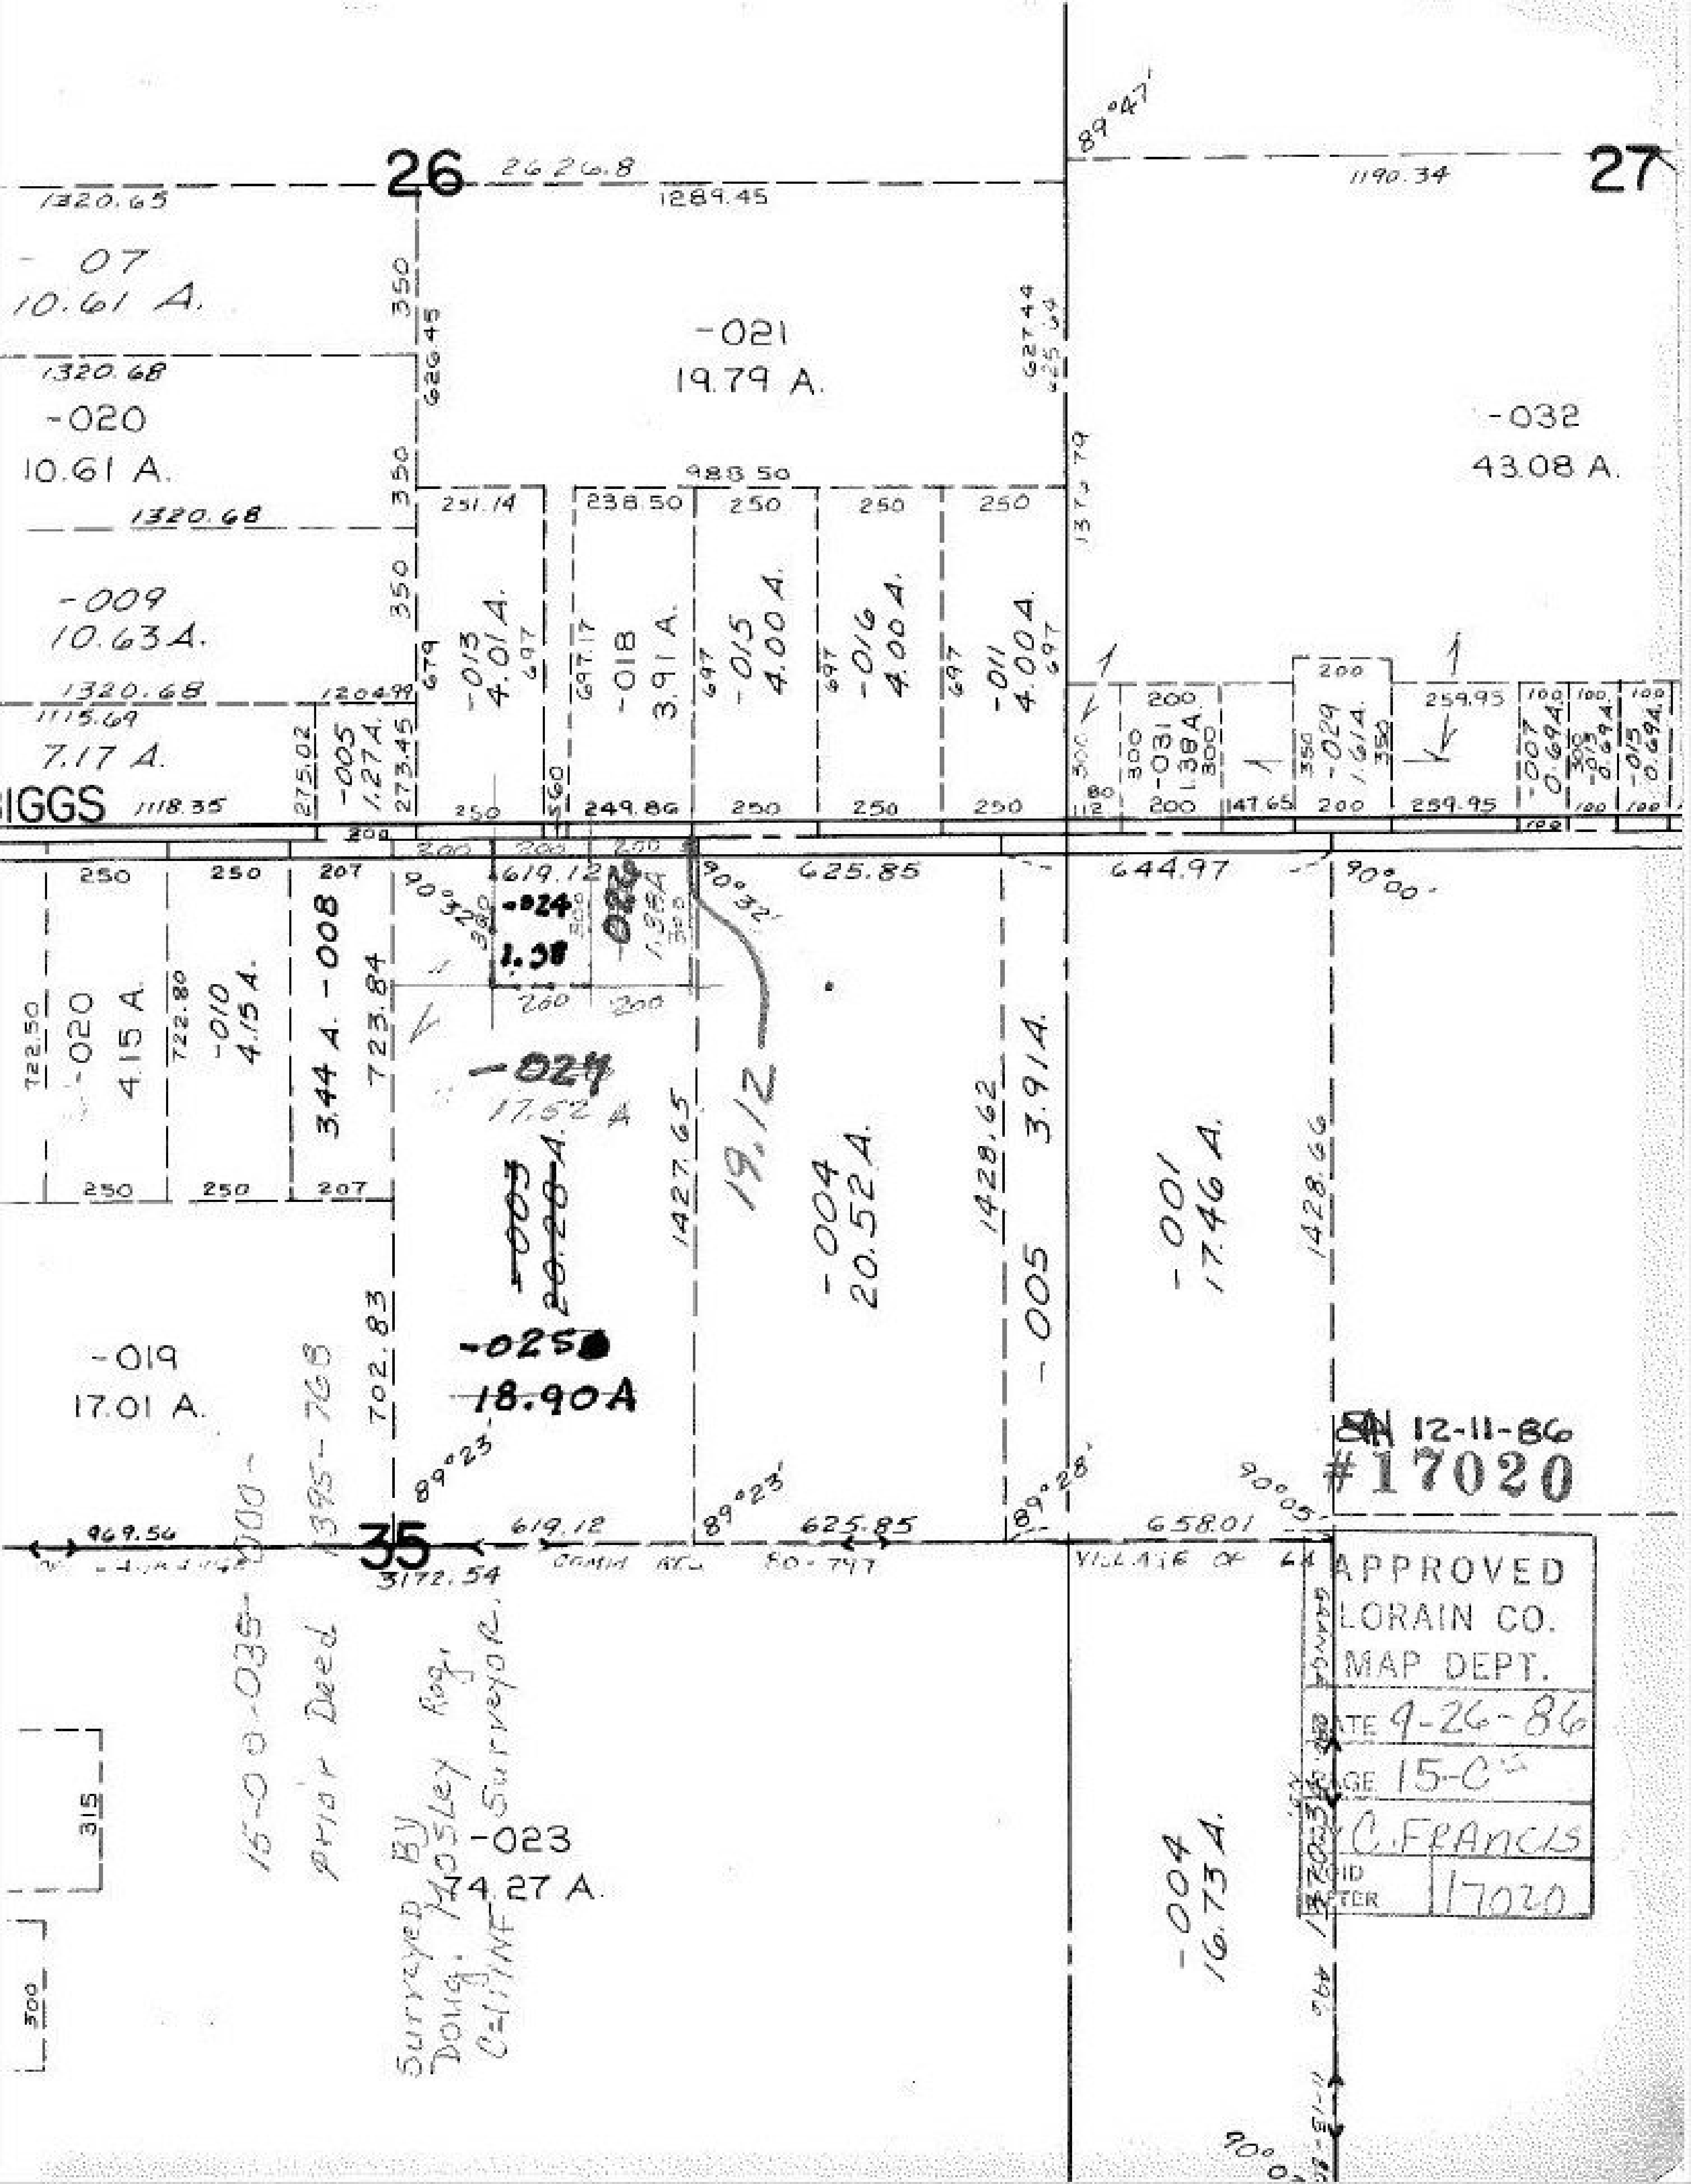
26
2626.8
1320.65
1289.45
27
1190.34
89°47'
-07
10.61 A.
1320.68
-020
10.61 A.
1320.68
-009
10.63 A.
1320.68
1115.69
7.17 A.
-021
19.79 A.
988.50
-032
43.08 A.
251.14
238.50
250
-013
4.01 A.
-018
3.91 A.
-015
4.00 A.
-016
4.00 A.
-011
4.00 A.
1204.99
-005
1.27 A.
-031
1.38 A.
-029
1.61 A.
259.95
147.65
-007
0.69 A.
-015
0.69 A.
BIGGS
1118.35
249.86
619.12
625.85
644.97
90°32'
90°00'
-024
1.38
-020
4.15 A.
-010
4.15 A.
3.44 A. -008
723.84
-024
17.52 A
-003
20.28 A.
-025
18.90A
1427.65
19.12
-004
20.52 A.
1428.62
3.91 A.
-005
-001
17.46 A.
1428.66
-019
17.01 A.
702.83
89°23'
89°28'
90°05'
35
969.56
3172.54
619.12
625.85
658.01
VILLAGE OF
15-00-035-000-
Prior Deed 1395-768
Surveyed By Doug. Mosley Reg. Surveyor. Ceiline
-023
74.27 A.
-004
16.73 A.
315
300
12-11-86
#17020
APPROVED
LORAIN CO.
MAP DEPT.
DATE 9-26-86
PAGE 15-C
BY C. FRANCIS
NO ID
NUMBER 17020