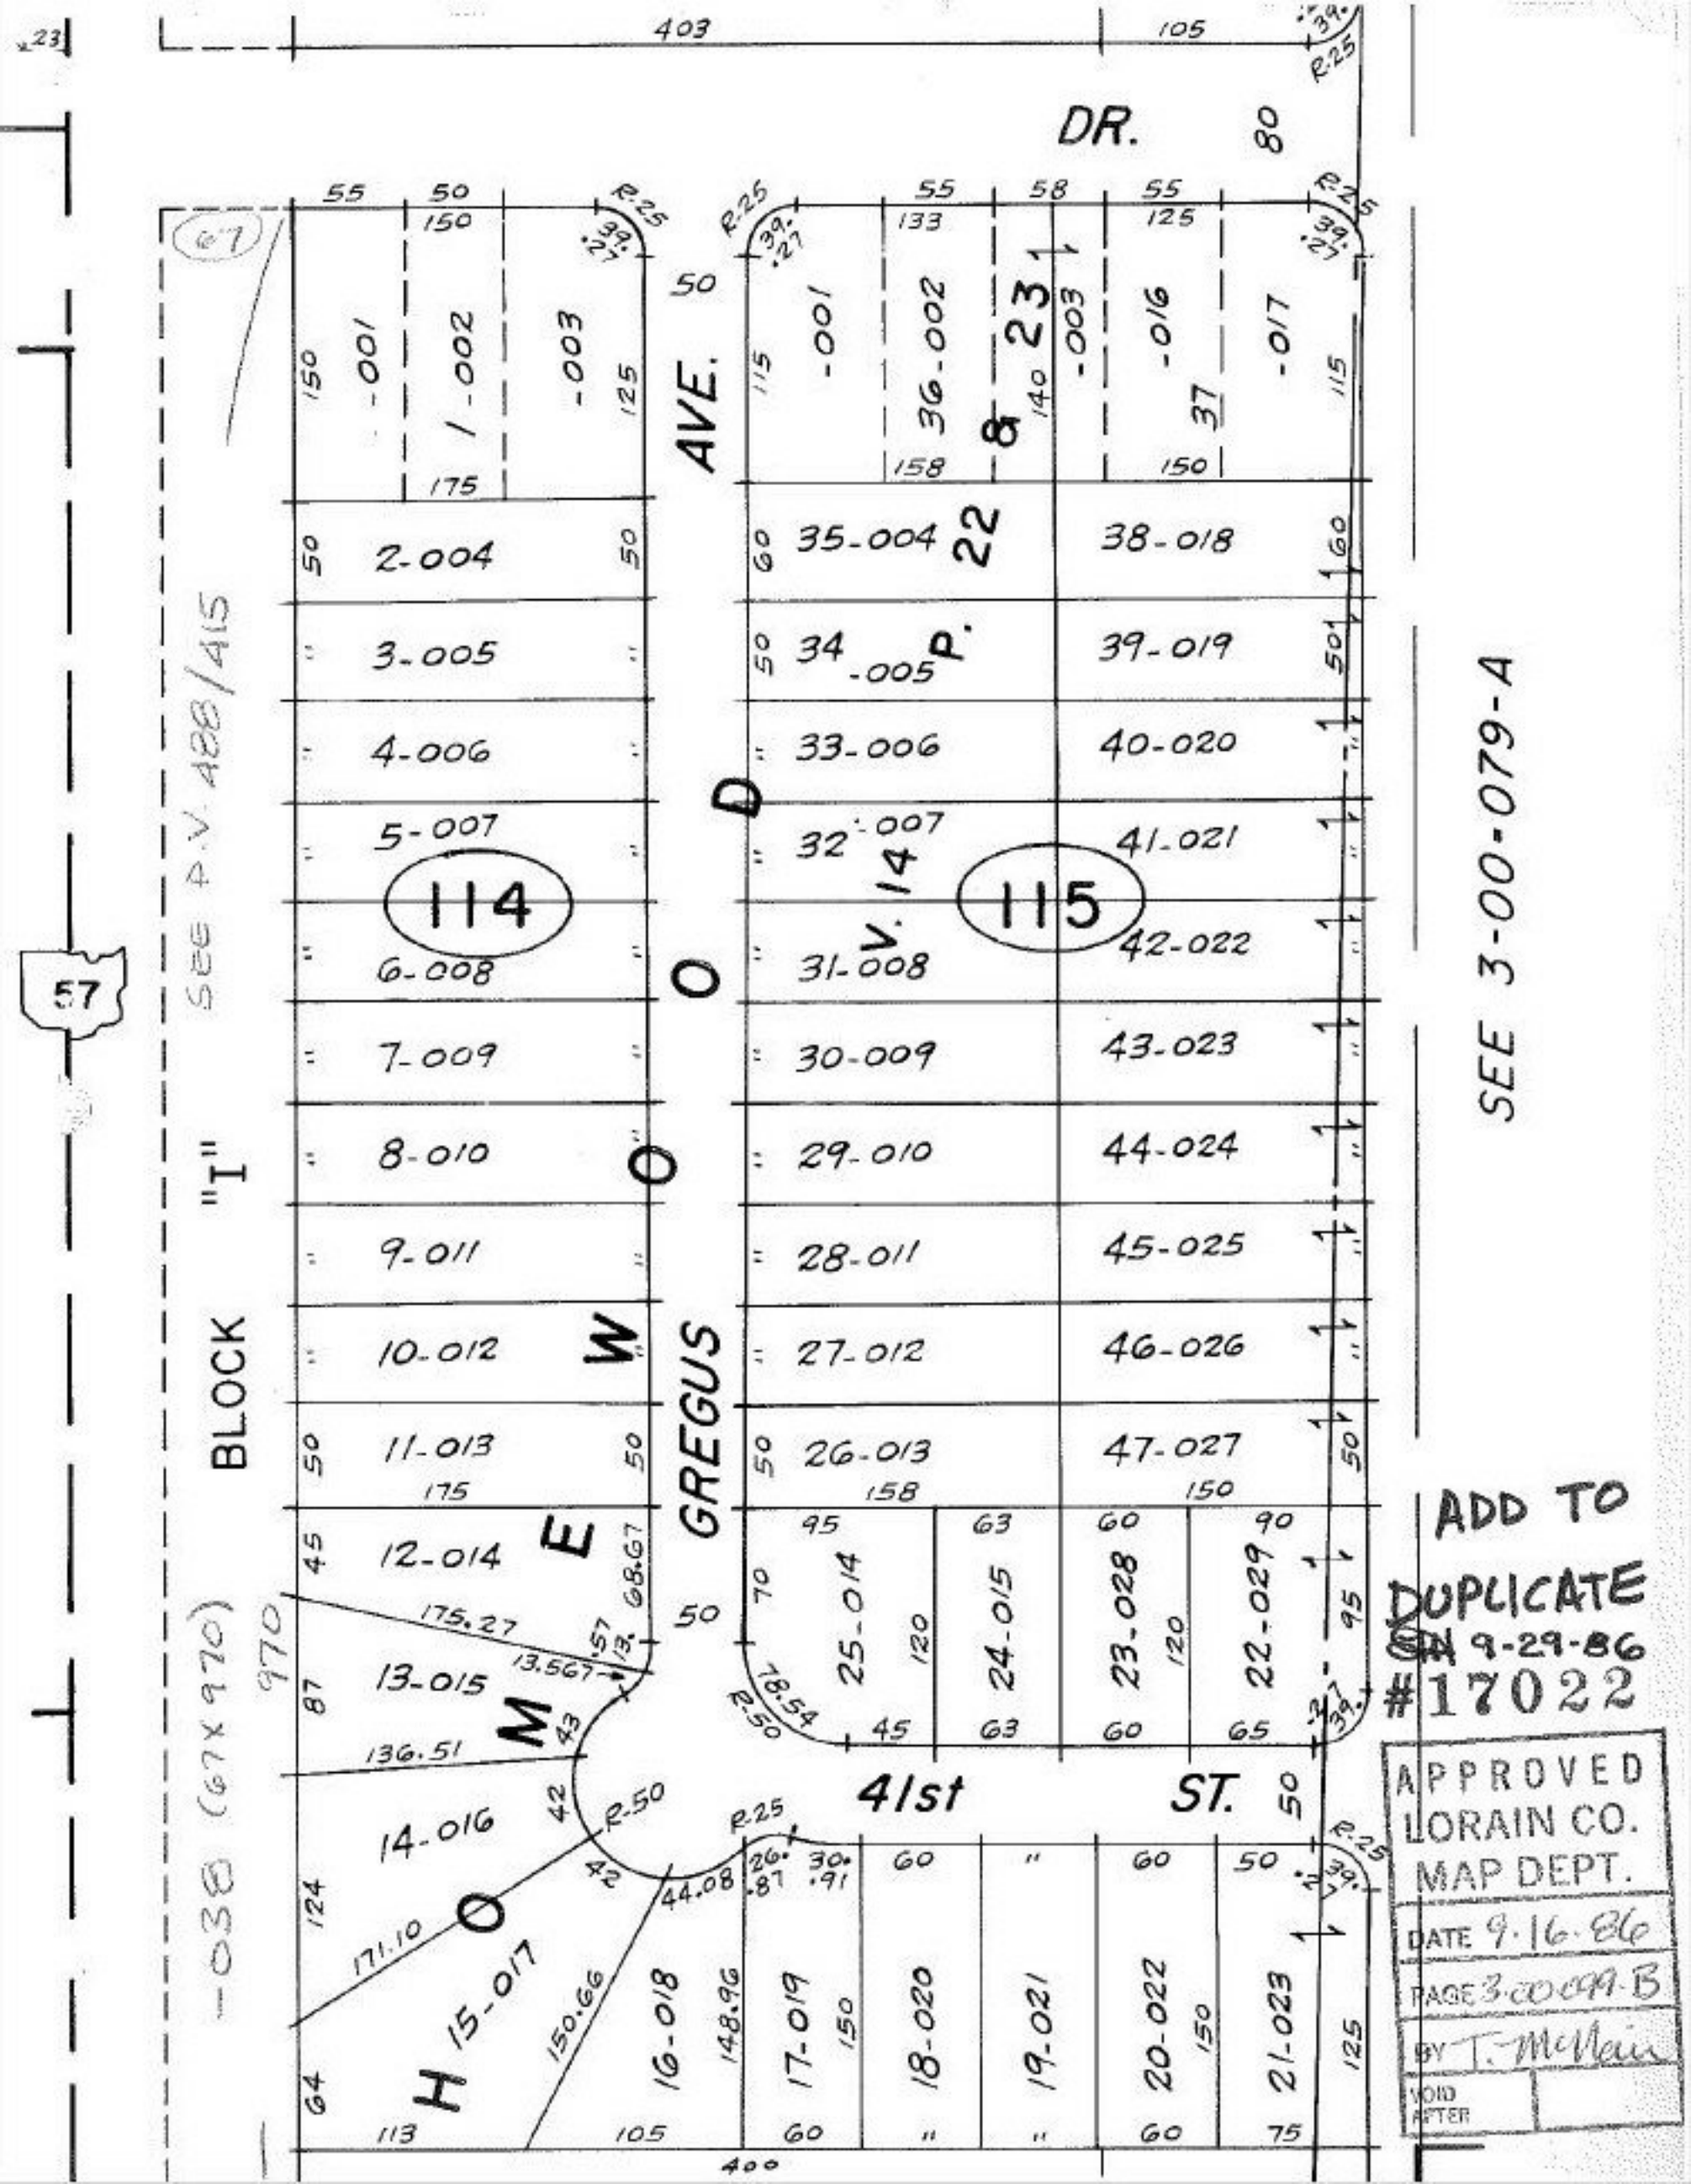

403
105
DR.
80
AVE.
GREGUS
BLOCK "I"
SEE P.V. 488/415
-038 (67 x 970)
970
57
114
115
P. 22
V. 14
23
& 37
41st ST.
SEE 3-00-079-A
ADD TO DUPLICATE
9-29-86
#17022
APPROVED
LORAIN CO.
MAP DEPT.
DATE 9-16-86
PAGE 3-00-099-B
BY T. McNair
VOID AFTER