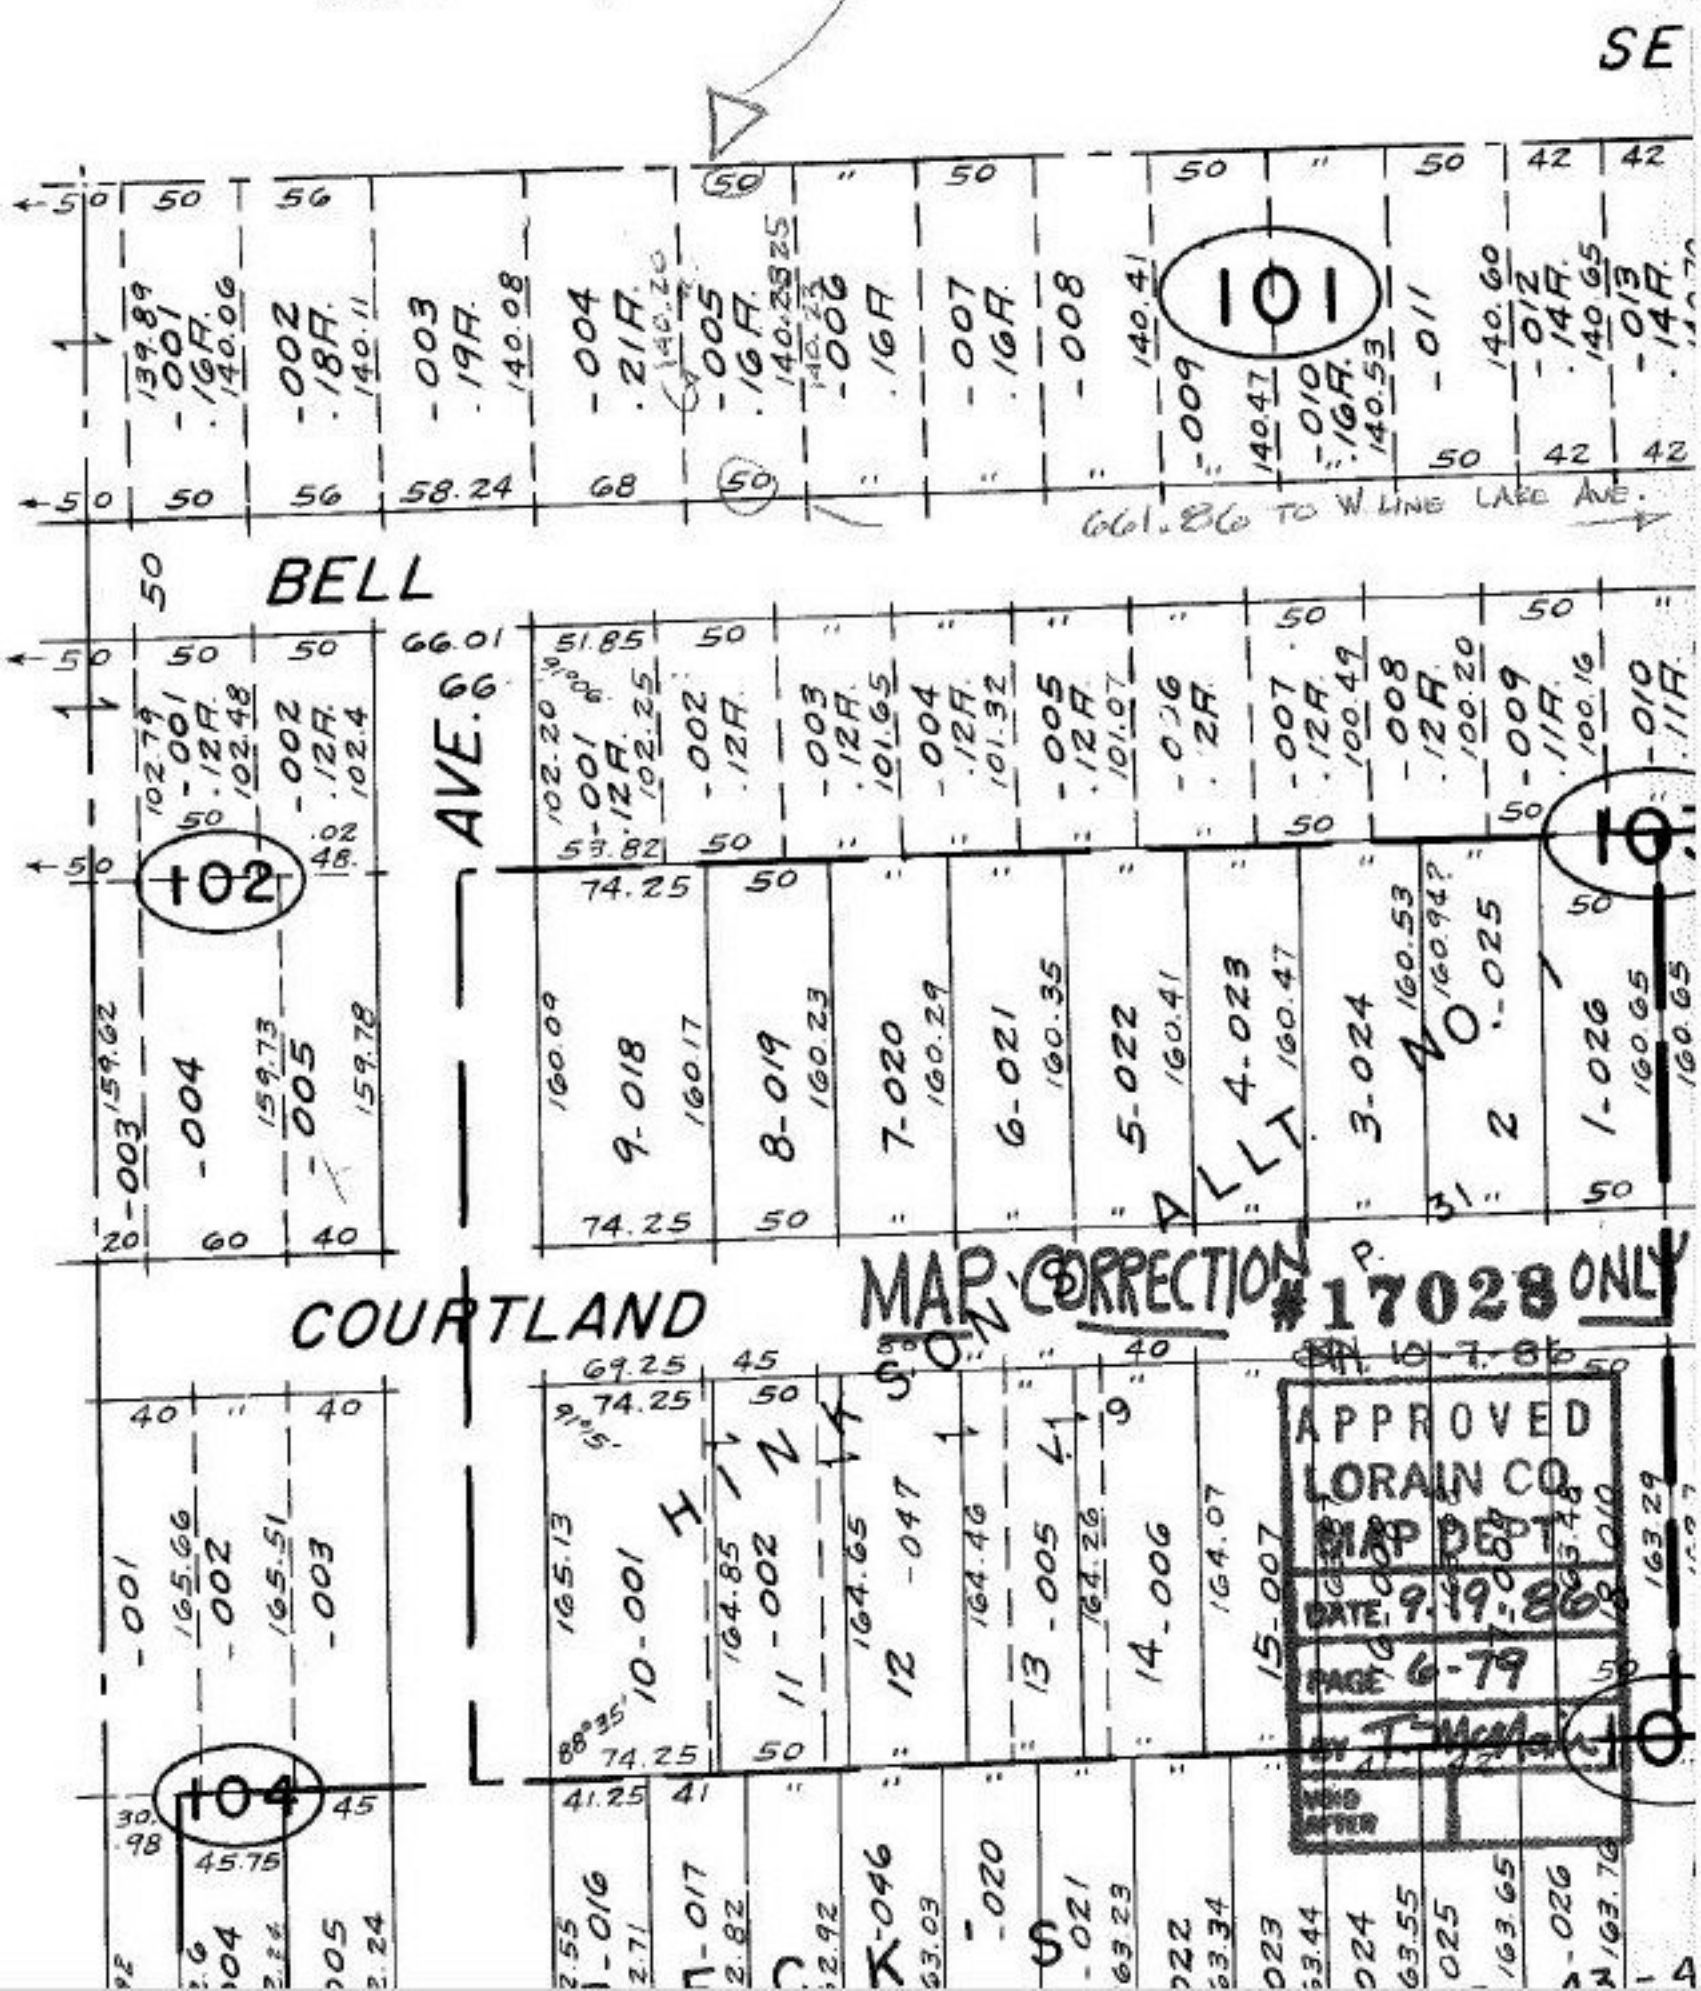ADD CORRECTED DIMENSIONS PER—
SURVEY BY
J. W. WARDEN, 1943
CL. 1:47619