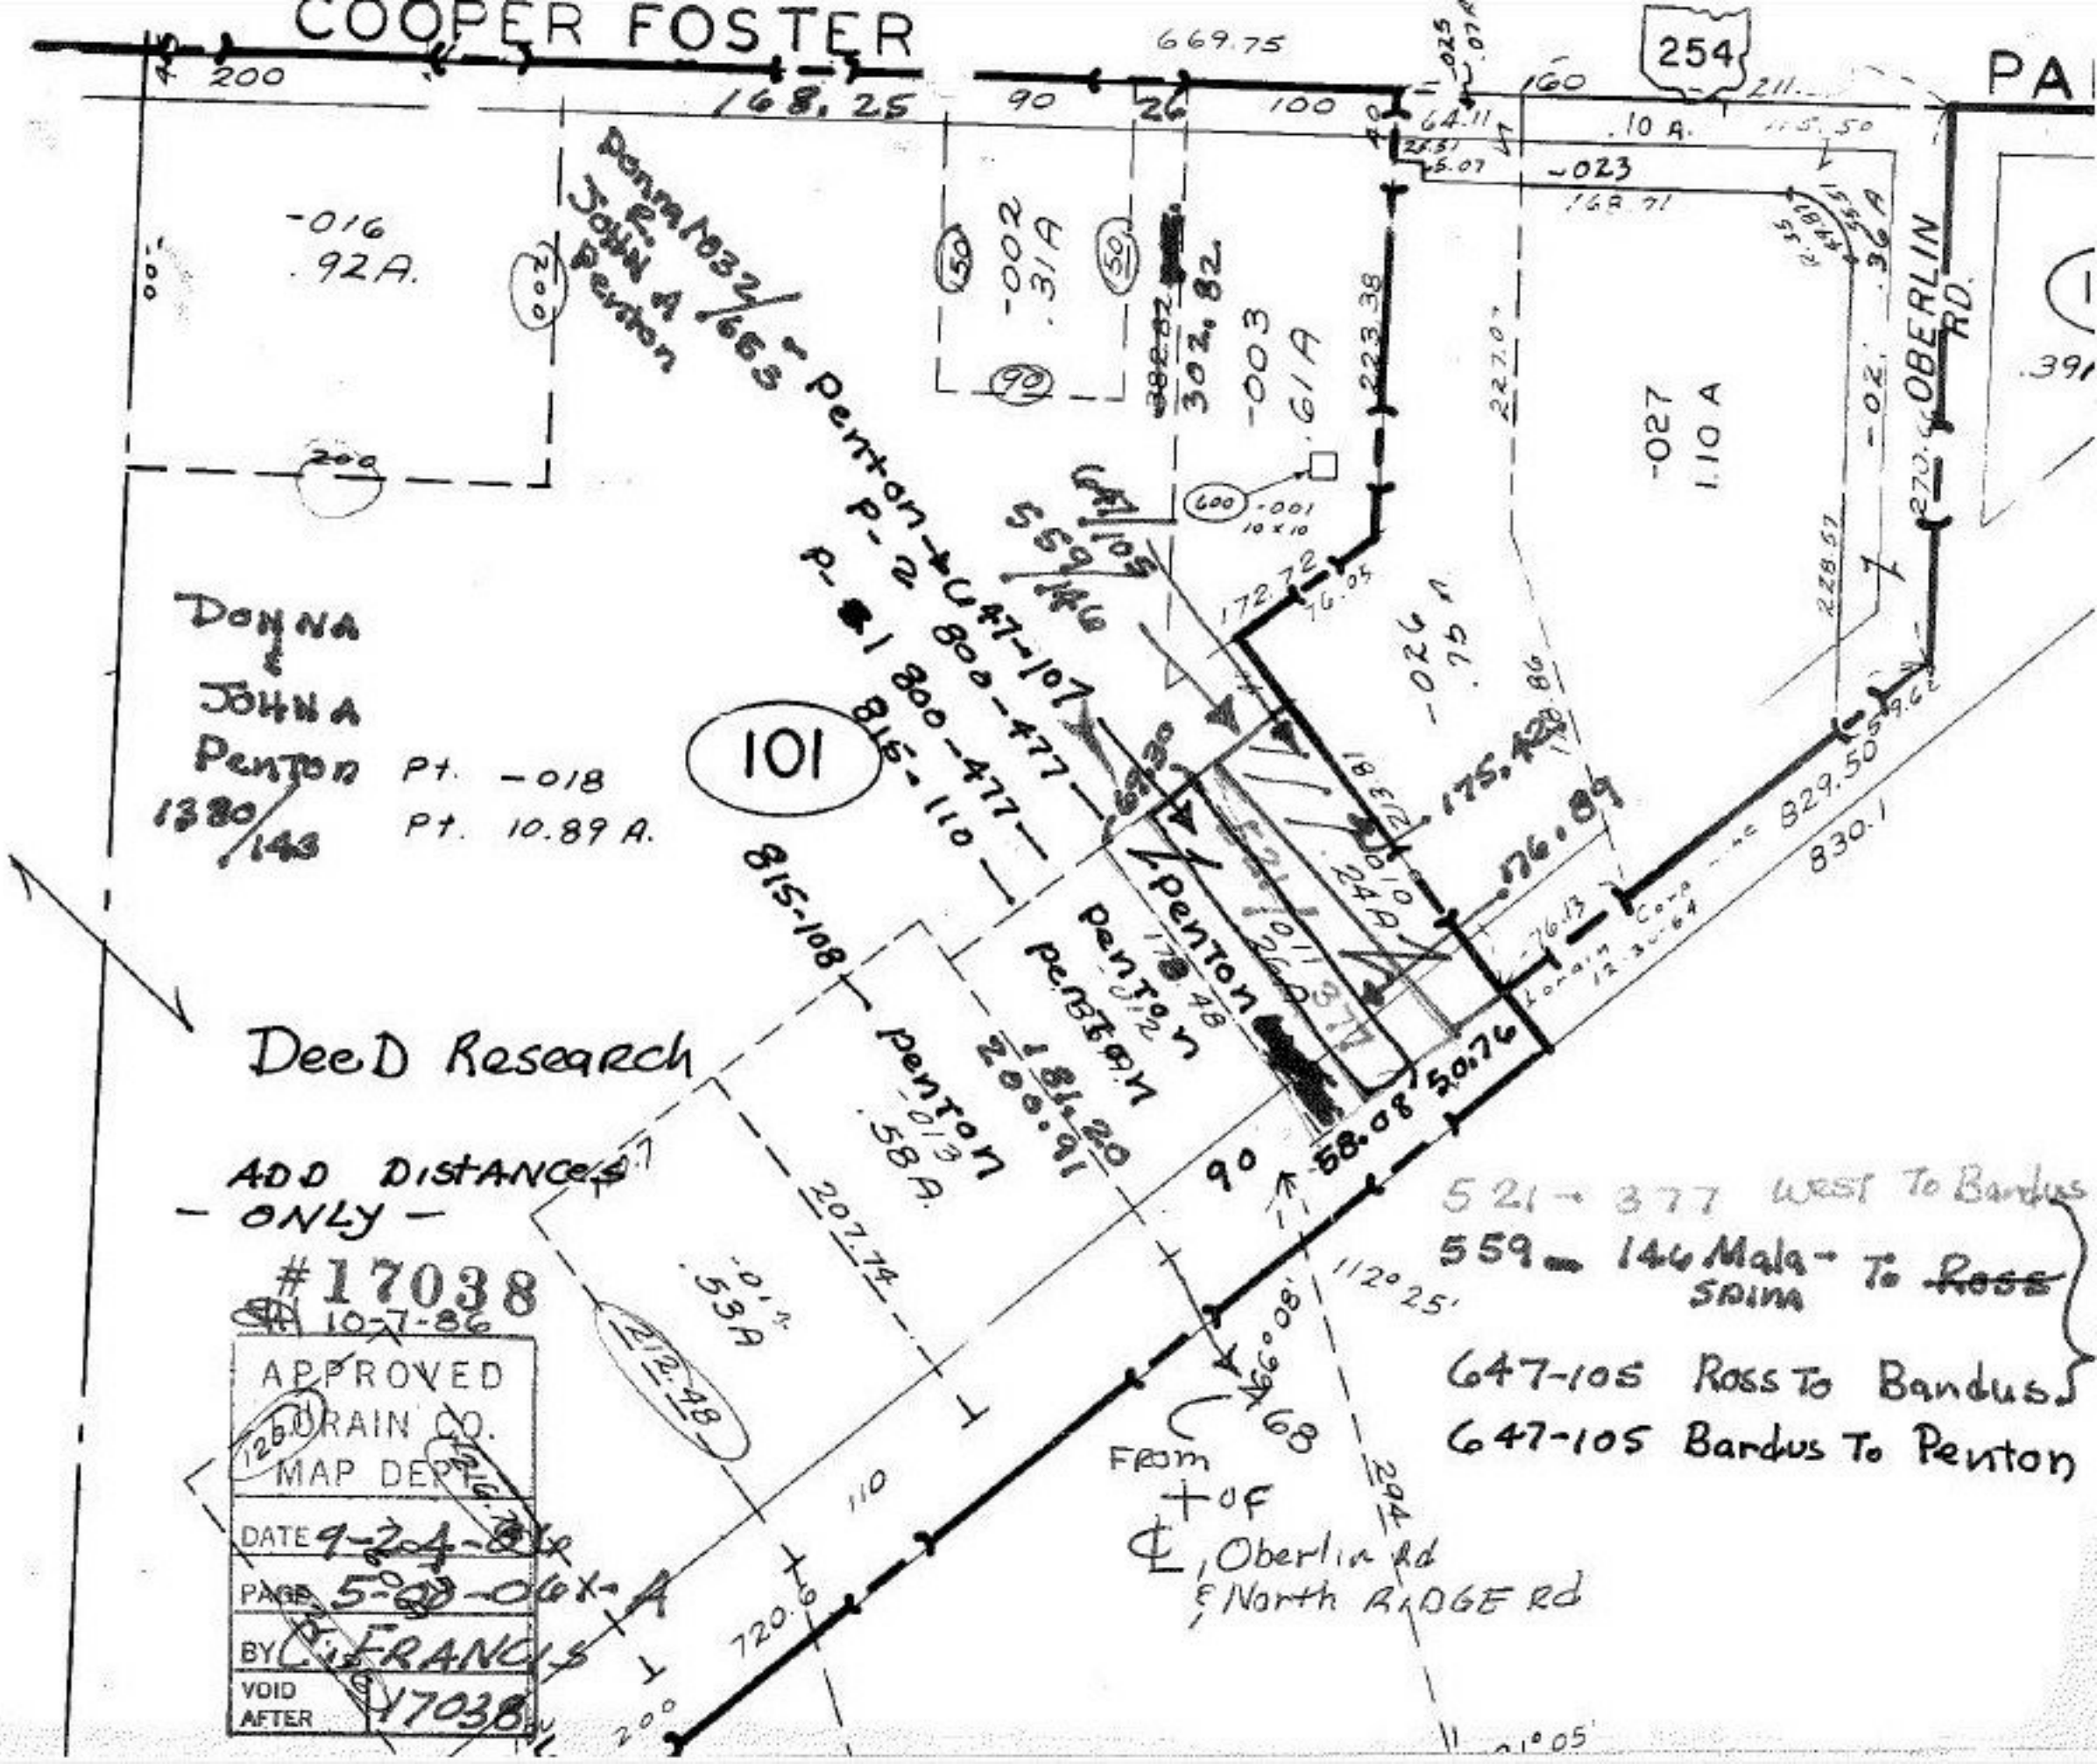
COOPER FOSTER
254
PA
OBERLIN RD.
101
Donna & John A Penton
Pt. -018
Pt. 10.89 A.
1380/143
Deed Research
ADD DISTANCES - ONLY -
#17038
10-7-86
APPROVED
LORAIN CO.
MAP DEPT.
DATE 9-24-86
PAGE 5-00-06X-A
BY C. FRANCIS
VOID AFTER 17038
521 → 377 West To Bardus
559 — 146 Mala - To ~~Ross~~
647-105 Ross To Bardus
647-105 Bardus To Penton
From + of ℄ Oberlin Rd & North RIDGE Rd
Penton
Donna 1032/663 - Penton → 647-107
P-2 800-477
P-1 800-477
815-110
815-108
-016 .92A.
-002 .31A
-003 .61A
-027 1.10 A
-026 .75 A
-023
-013 .58A
-012
-014 .53A
-001 10 x 10
669.75
168.25
90
26
100
160
211
64.11
.10 A.
223.38
227.07
228.57
172.72
76.05
175.42
176.89
829.50
830.1
58.08
50.76
207.74
212.48
112°25'
66°08'
110
720.6
294
200